INSET 'A'	INSET 'B'	INSET 'C'	INSET 'D'	INSET 'E'	INSET 'F'

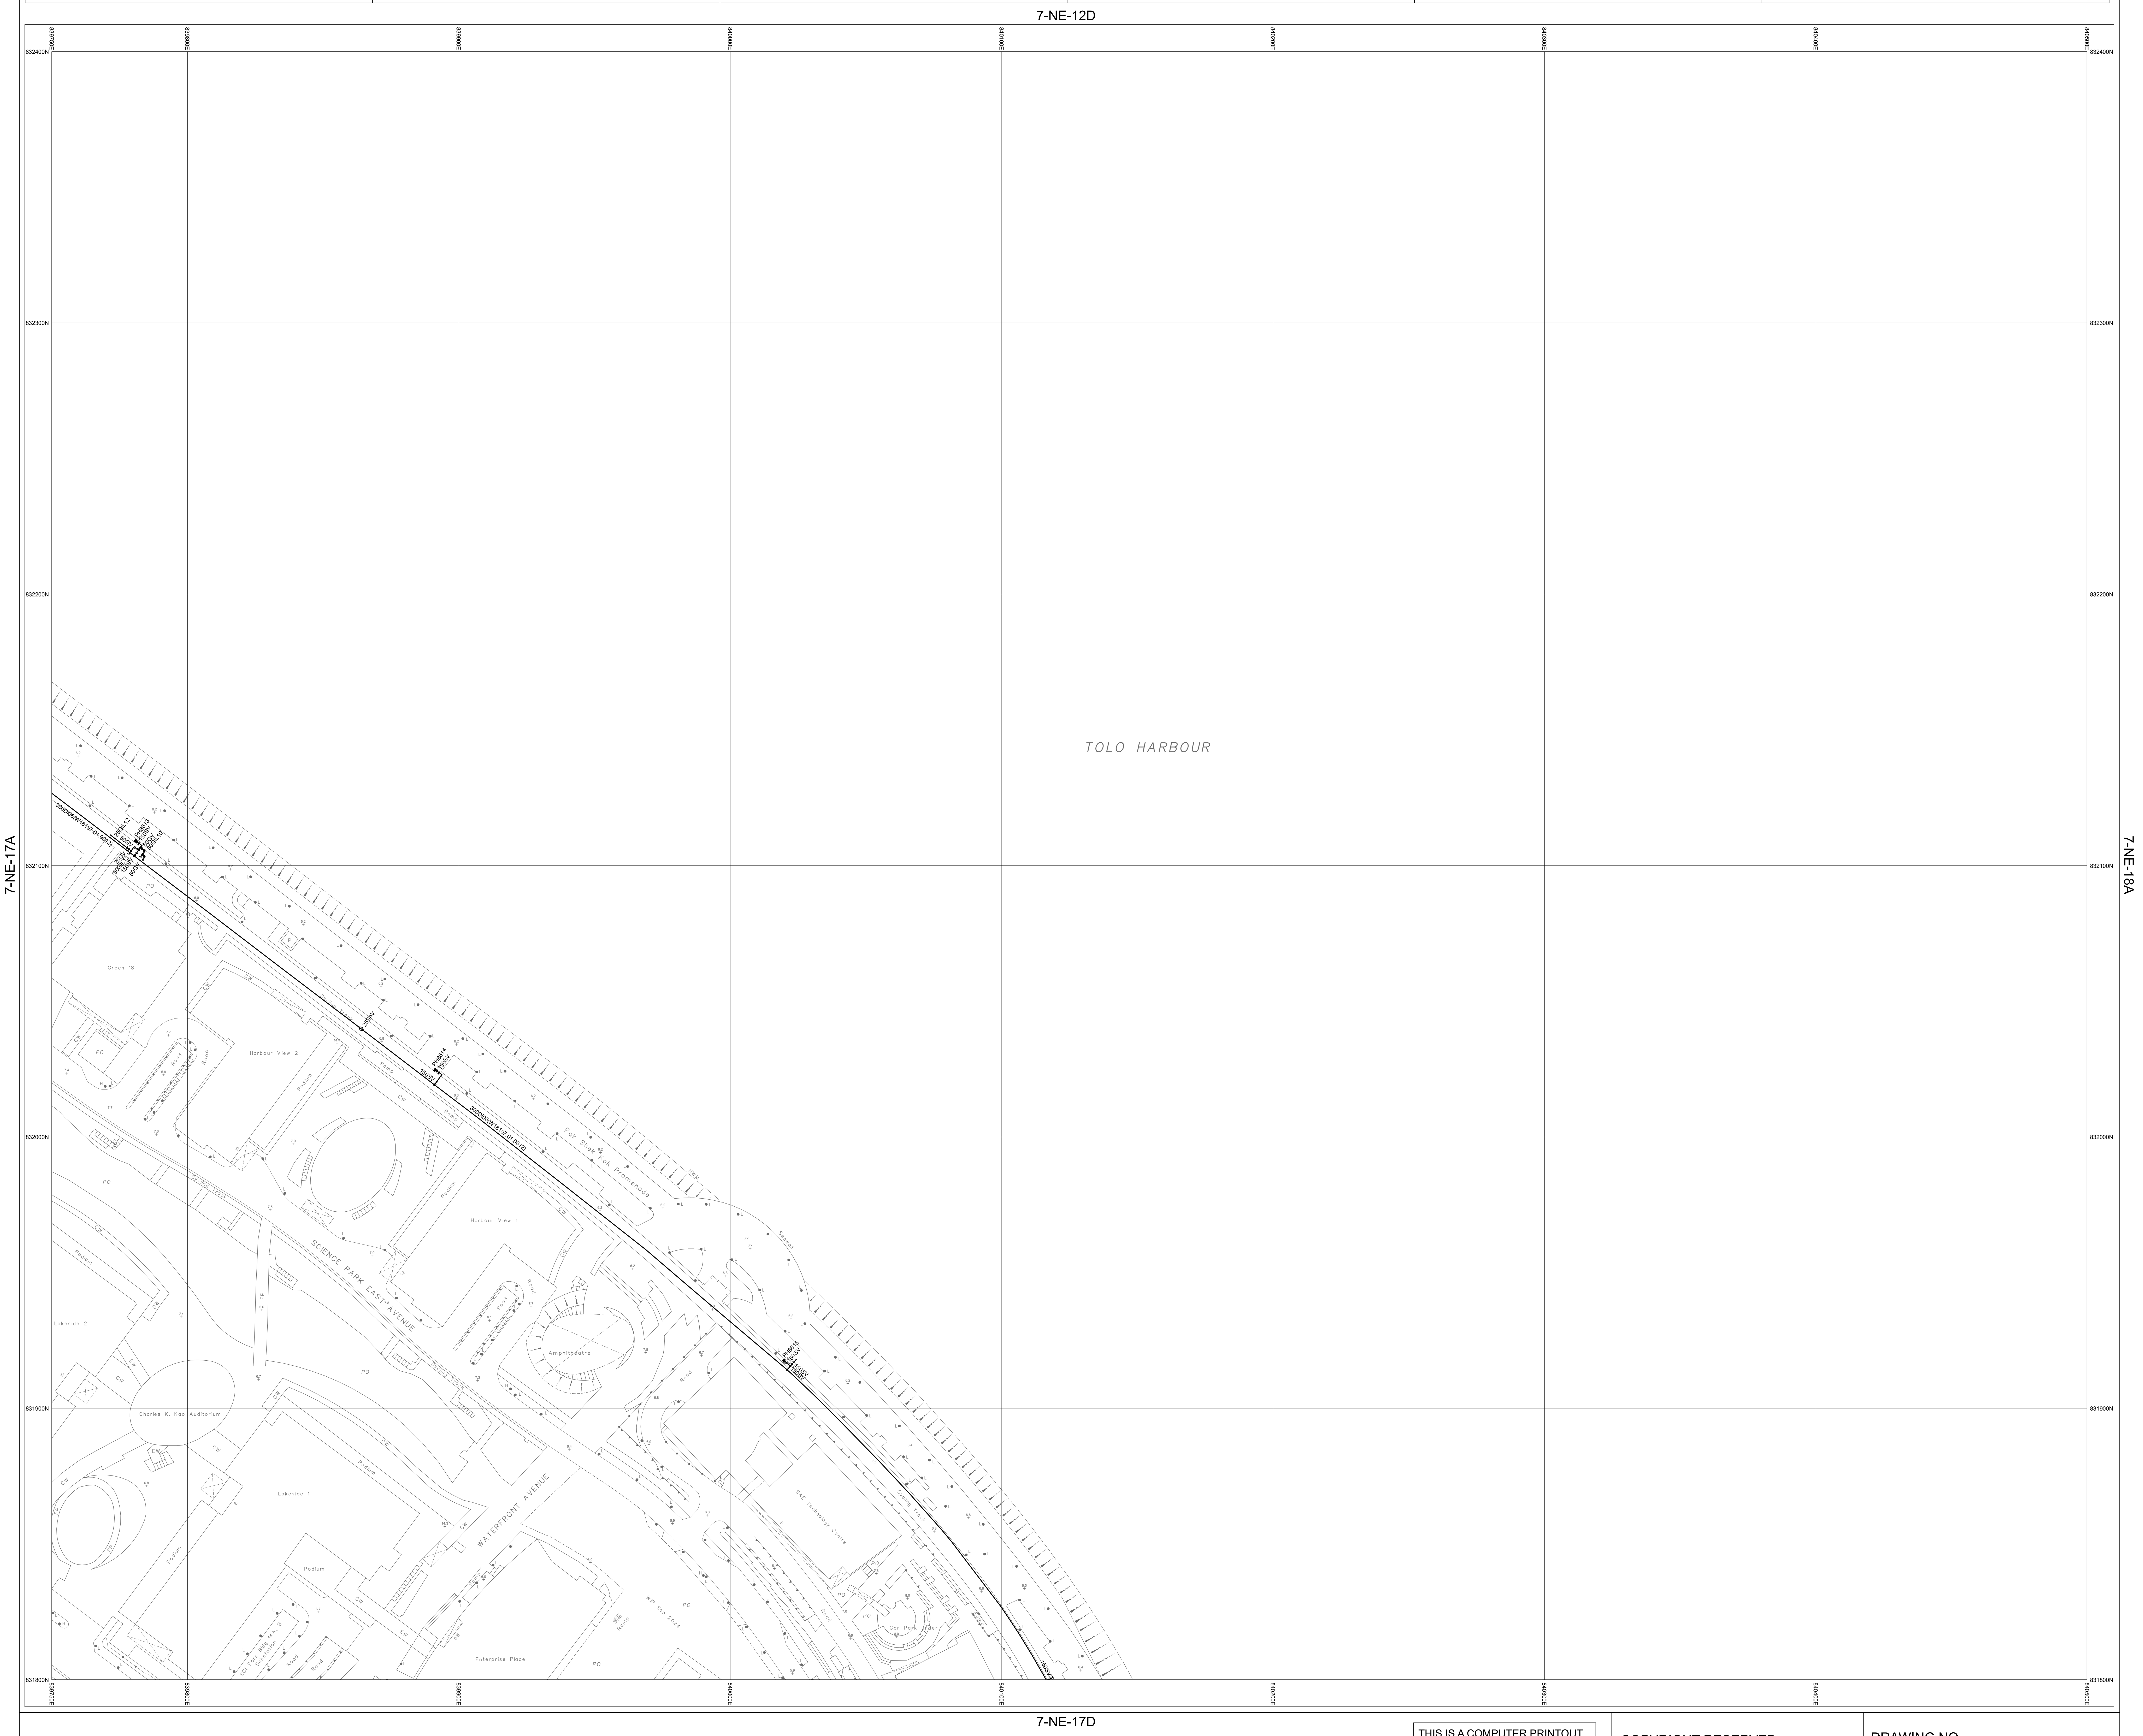
7-NE-12D
7-NE-17A
7-NE-18A
7-NE-17D
832400N
832300N
832200N
832100N
832000N
831900N
831800N
839750E
839800E
839900E
840000E
840100E
TOLO HARBOUR
300DI06(W18197.01.0012)
25GIL12
PH8613
150SV
80GV
80GIL10
50GV
25GV
50GIL12
150SV
50GV
25SAV
PH8614
150SV
150SV
PH8615
150SV
150SV
150SV
150SV
Green 18
Harbour View 2
Harbour View 1
Podium
Cycling Track
Ramp
CW
EW
PO
Road
Pak Shek Kok Promenade
Seawall
SCIENCE PARK EAST AVENUE
WATERFRONT AVENUE
Amphitheatre
Lakeside 2
Lakeside 1
Charles K. Kao Auditorium
SAE Technology Centre
Car Park under
SCI Park Bldg 14A, B Substation
Enterprise Place
WIP Sep 2024
斜路 Ramp
FP

NOTES:

1. FOR MAINS RECORDS SIGN CONVENTIONS AND DESIGNATIONS SEE SKETCH NO.3988.
2. DIMENSIONS OF MAINS ARE IN MILLIMETRES UNLESS OTHERWISE SPECIFIED.
3. ALL LEVELS ARE IN METRES ABOVE PRINCIPAL DATUM.

Basemap Date Updated On: 23/12/2024

SCALE 1:1 000

METRES 20 10 0 20 40 60 80 100 METRES

THIS IS A COMPUTER PRINTOUT,
NO SIGNATURE IS REQUIRED.

FRESH WATER MAINS RECORD PLAN

HONG KONG SCIENCE PARK

COPYRIGHT RESERVED

DATE REVISED : 30/12/2024

DRAWING NO.
W67880/ 7-NE-17B

SIGNED
C.T. WONG
CE/NTE
DATE: 16/01/2008

Water Supplies Department
HONG KONG

© The Government of the Hong Kong SAR, Map reproduced with permission of the Director of Lands