INSET 'A'

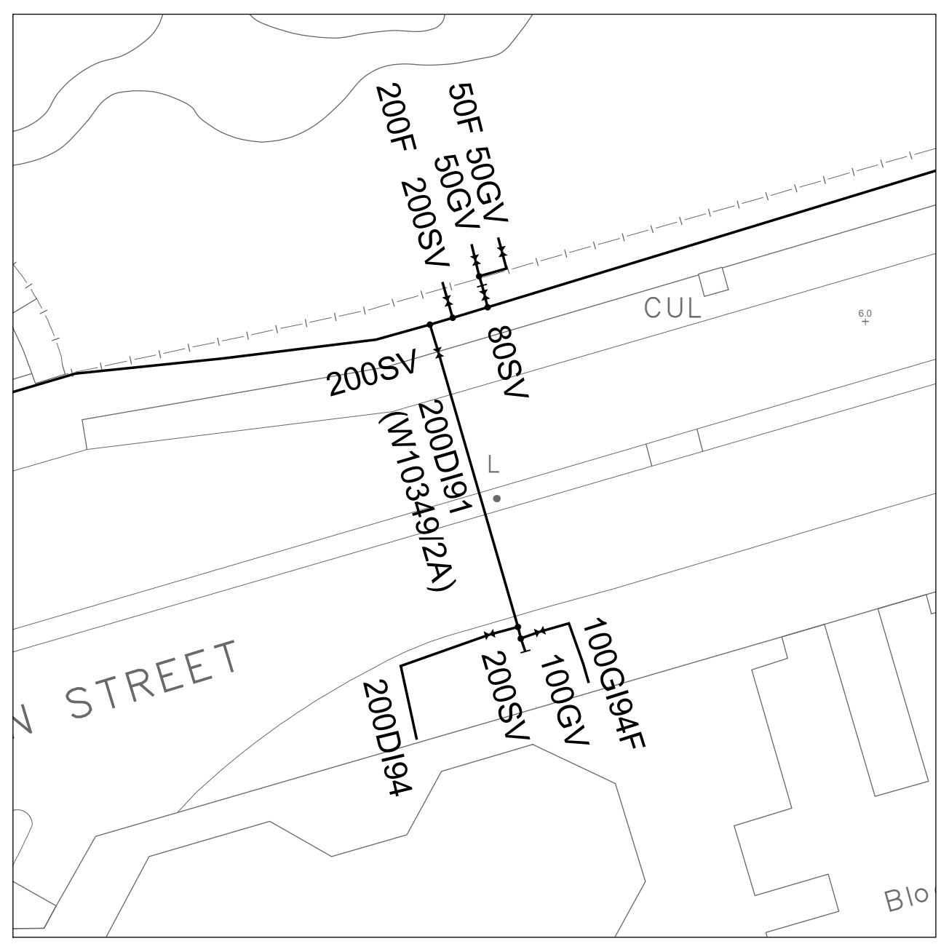
50F 50GV
50GV
200F
200SV
CUL
200SV
80SV
200DI91
(W10349/2A)
STREET
100GI94F
100GV
200SV
200DI94

Scale 1:500

INSET 'B'

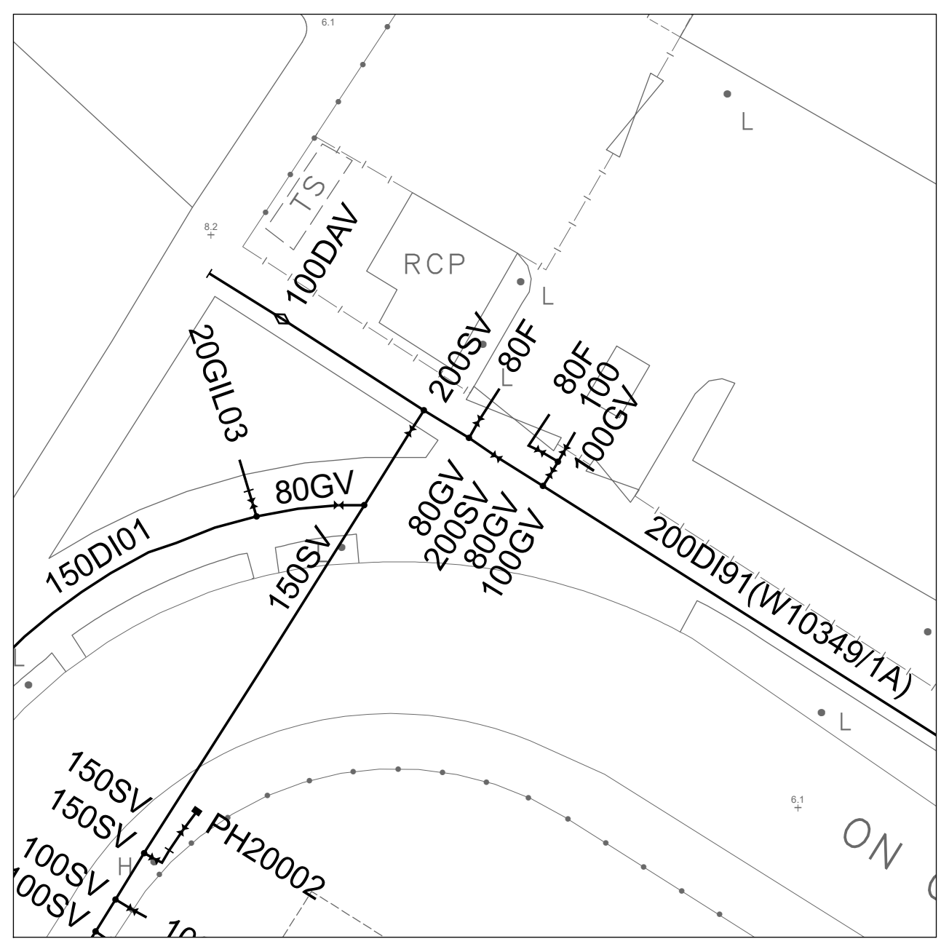
100DAV
RCP
TS
20GIL03
200SV
80F
80F
100
100GV
80GV
150DI01
150SV
80GV
200SV
80GV
100GV
200DI91(W10349/1A)
150SV
150SV
PH20002
100SV
100SV
ON

Scale 1:500

INSET 'C'

INSET 'D'

INSET 'E'

INSET 'F'

7-NE-13D

7-NE-18A

7-NE-19A

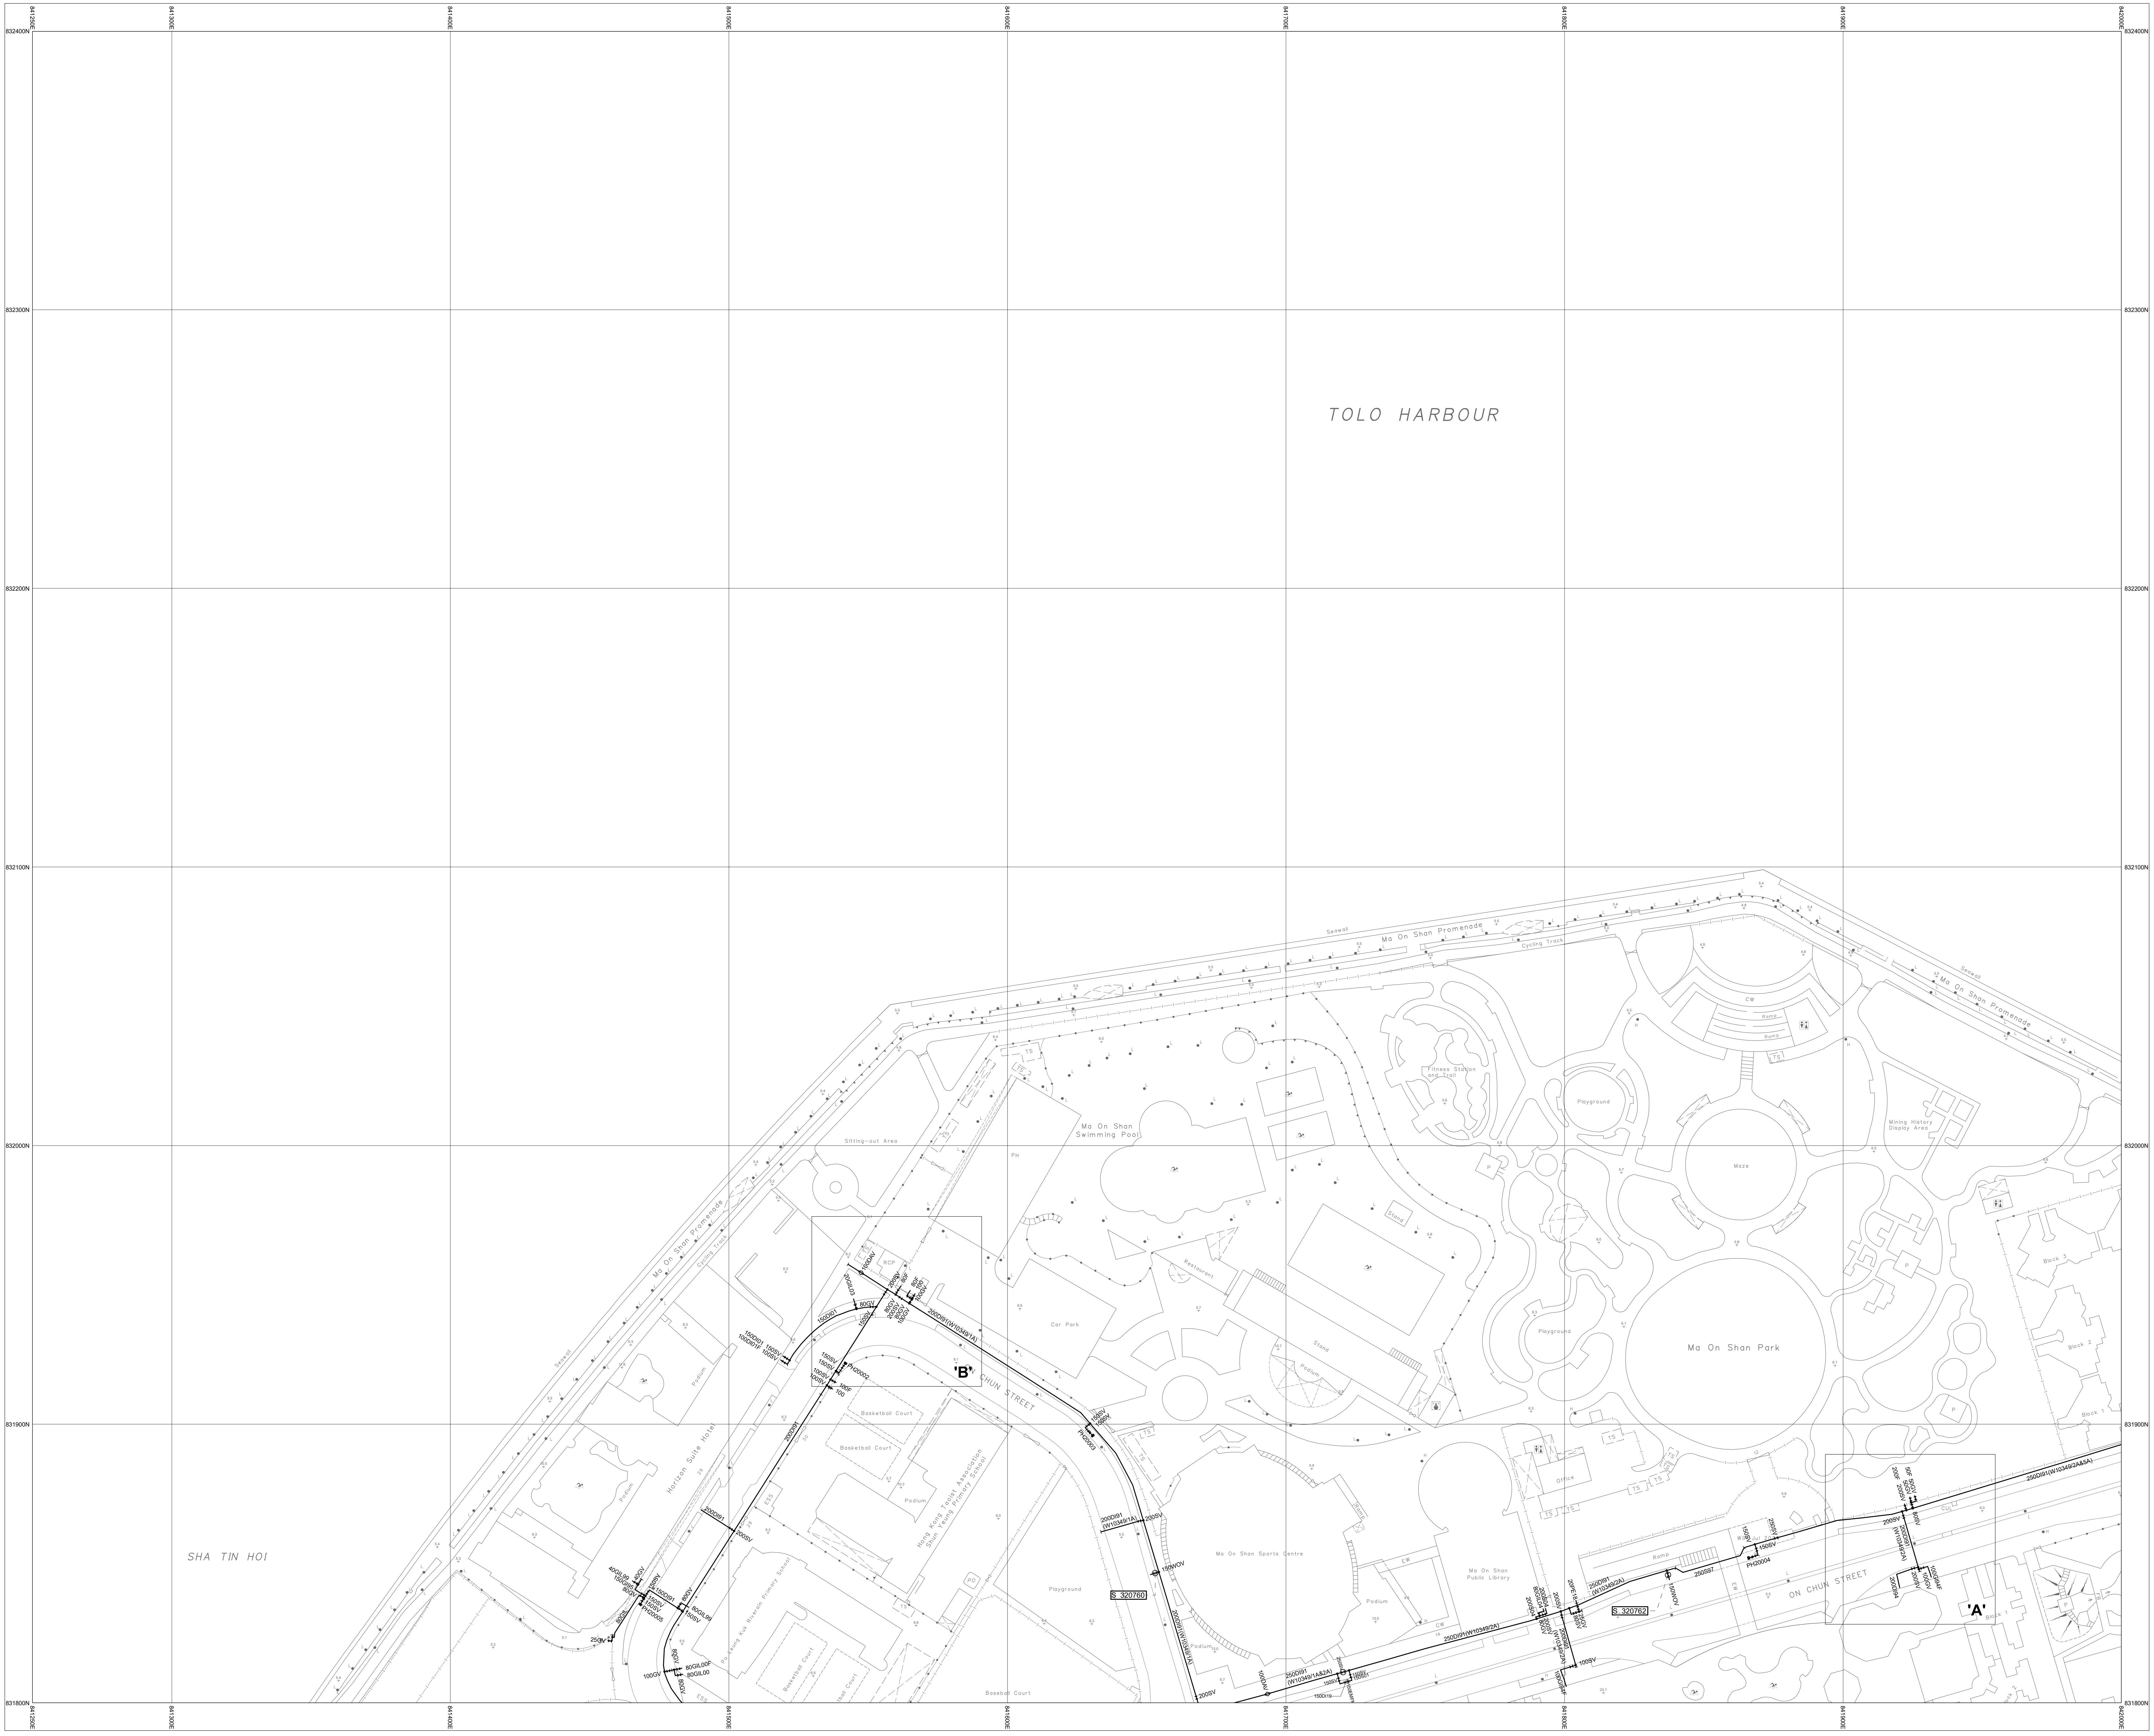
TOLO HARBOUR
SHA TIN HOI
Mo On Shan Promenade
Mo On Shan Swimming Pool
Mo On Shan Park
Mo On Shan Sports Centre
Ma On Shan Public Library
Car Park
Playground
Basketball Court
Podium
ON CHUN STREET
'A'
'B'
S_320760
S_320762

7-NE-18D

NOTES:
1. FOR MAINS RECORDS SIGN CONVENTIONS AND DESIGNATIONS SEE SKETCH NO.3988.
2. DIMENSIONS OF MAINS ARE IN MILLIMETRES UNLESS OTHERWISE SPECIFIED.
3. ALL LEVELS ARE IN METRES ABOVE PRINCIPAL DATUM.

Basemap Date Updated On: 23/12/2024

SCALE 1:1 000

METRES 20 10 0 20 40 60 80 100 METRES

FRESH WATER MAINS RECORD PLAN

TOLO HARBOUR

THIS IS A COMPUTER PRINTOUT,
NO SIGNATURE IS REQUIRED.

COPYRIGHT RESERVED

DATE REVISED : 05/03/2025

SIGNED
C.S. CHIN
CE/MNE
DATE: 23/04/1999

DRAWING NO.
W67880/ 7-NE-18B

Water Supplies Department
HONG KONG

© The Government of the Hong Kong SAR, Map reproduced with permission of the Director of Lands