| INSET 'A' | INSET 'B' | INSET 'C' | INSET 'D' | INSET 'E' | INSET 'F' |
|---|---|---|---|---|---|

7-NE-17D

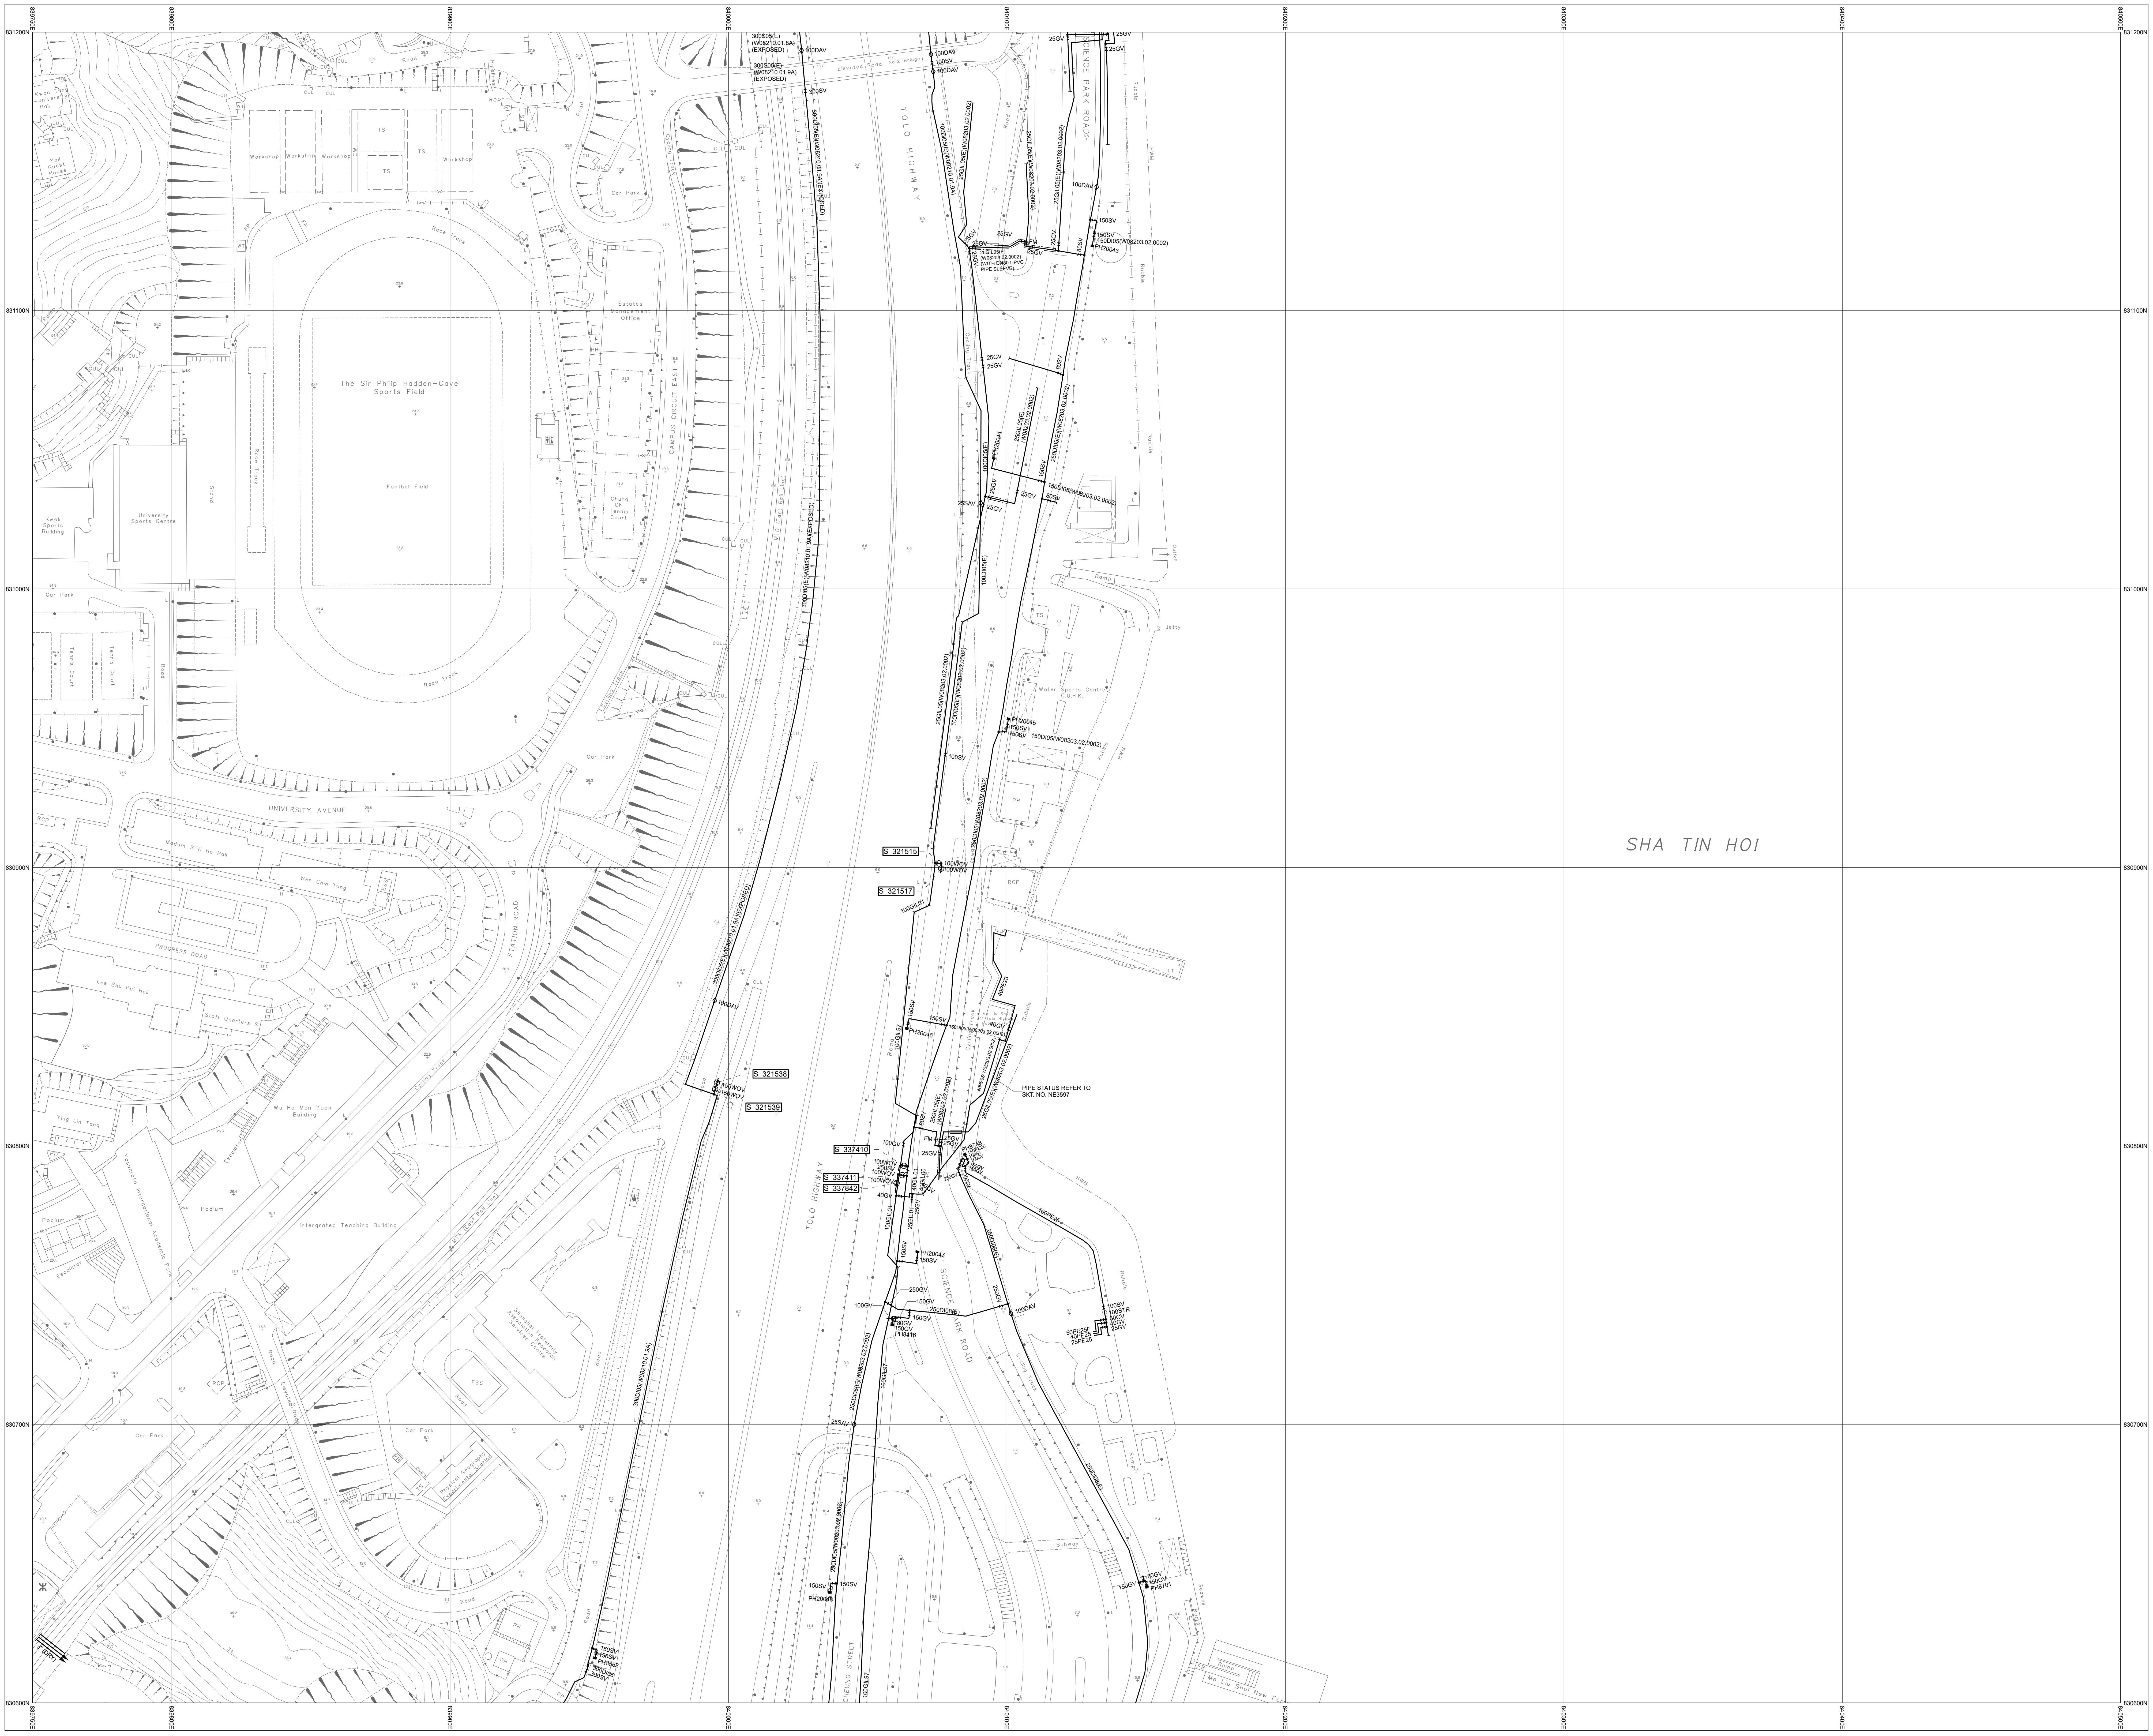
7-NE-22A
7-NE-23A
SHA TIN HOI
TOLO HIGHWAY
SCIENCE PARK ROAD
UNIVERSITY AVENUE
CAMPUS CIRCUIT EAST
STATION ROAD
PROGRESS ROAD
CHEUNG STREET
The Sir Philip Haddon-Cave Sports Field
University Sports Centre
Estates Management Office
Water Sports Centre C.U.H.K.
Intergrated Teaching Building
Car Park
Football Field
PIPE STATUS REFER TO SKT. NO. NE3597
S 321515
S 321517
S 321538
S 321539
S 337410
S 337411
S 337842

7-NE-22D

NOTES:

1. FOR MAINS RECORDS SIGN CONVENTIONS AND DESIGNATIONS SEE SKETCH NO.3988.
2. DIMENSIONS OF MAINS ARE IN MILLIMETRES UNLESS OTHERWISE SPECIFIED.
3. ALL LEVELS ARE IN METRES ABOVE PRINCIPAL DATUM.

Basemap Data Updated On: 05/01/2026

SCALE 1:1 000

METRES 20 10 0 20 40 60 80 100 METRES

THIS IS A COMPUTER PRINTOUT,
NO SIGNATURE IS REQUIRED.

# FRESH WATER MAINS RECORD PLAN

## TOLO HIGHWAY, CHINESE UNIVERSITY

COPYRIGHT RESERVED

DATE REVISED : 05/10/2026

DRAWING NO.
W67880/ 7-NE-22B

SIGNED
C.S. CHIN
CE/MNE
DATE: 23/04/1999

Water Supplies Department
HONG KONG

© The Government of the Hong Kong SAR, Map reproduced with permission of the Director of Lands