INSET 'A'	INSET 'B'	INSET 'C'	INSET 'D'	INSET 'E'	INSET 'F'

7-NW-3A

7-NW-2D

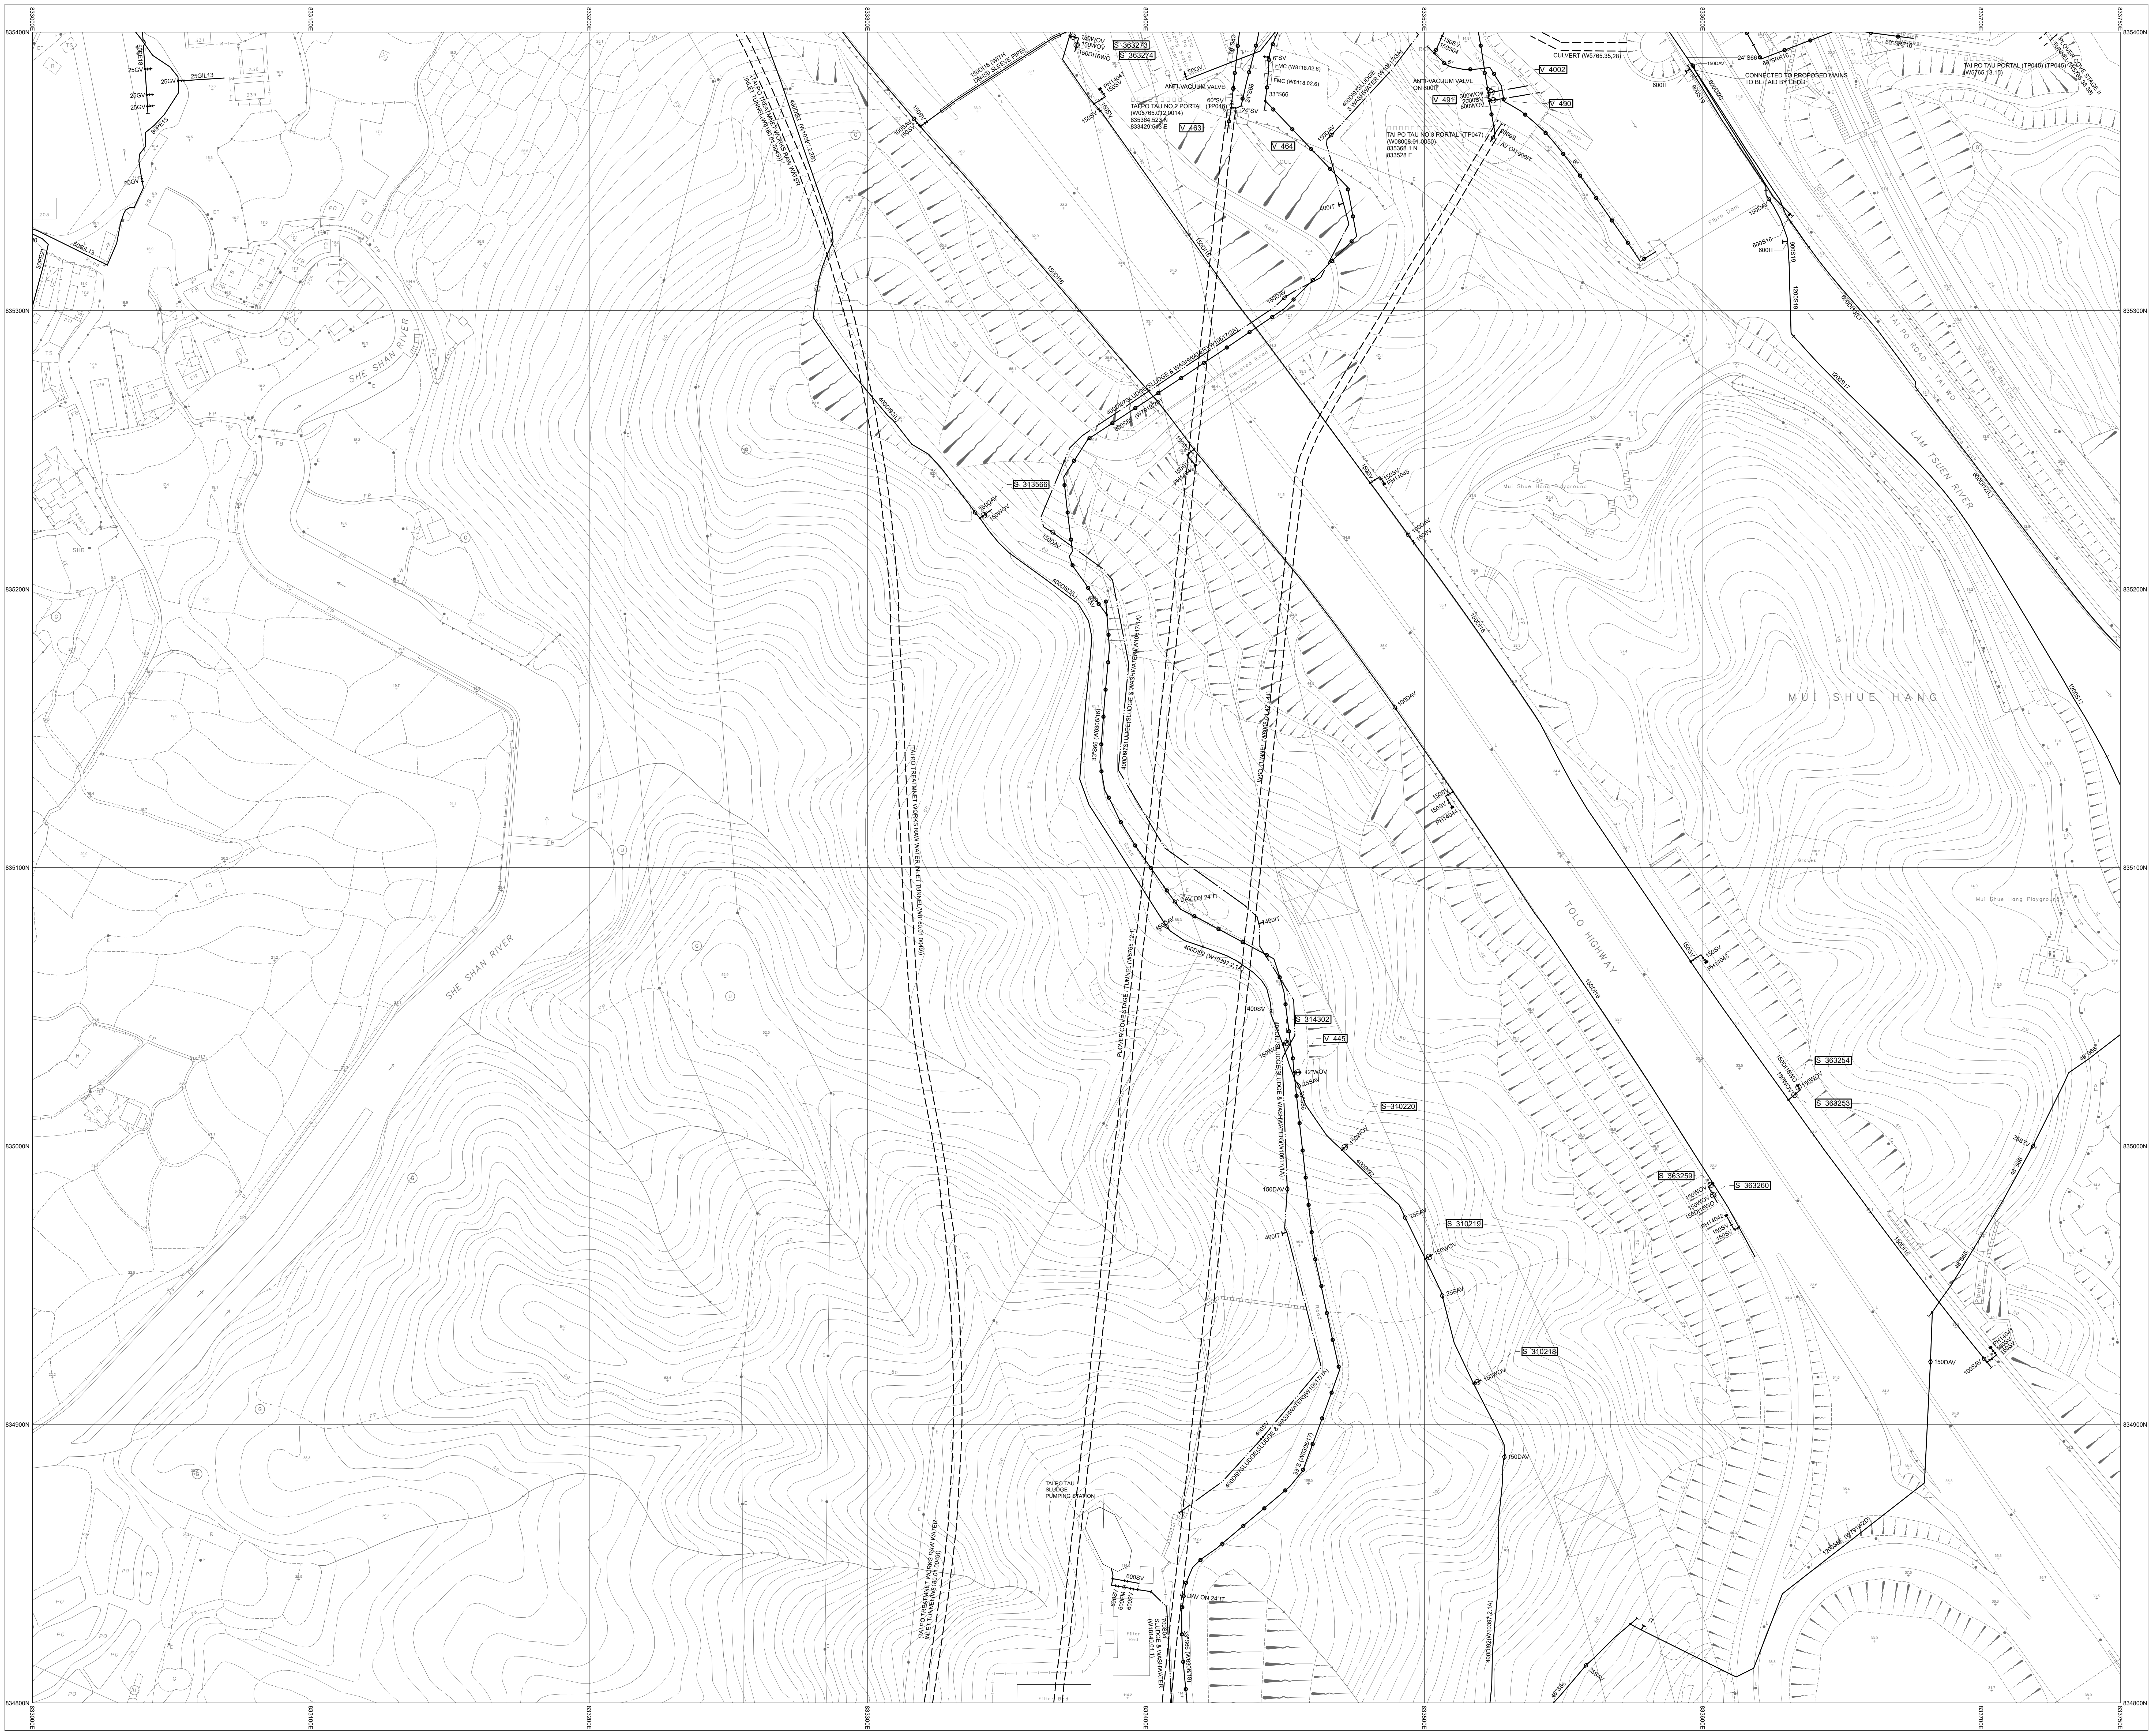
SHE SHAN RIVER
SHE SHAN RIVER
TAI PO TAU NO.2 PORTAL (TP046)
TAI PO TAU NO.3 PORTAL (TP047)
ANTI-VACUUM VALVE
CULVERT (W5765.35.26)
CONNECTED TO PROPOSED MAINS TO BE LAID BY CEDD
TAI PO TAU PORTAL (TP045)
TAI PO ROAD - TAI WO
LAM TSUEN RIVER
MUI SHUE HANG
TOLO HIGHWAY
TAI PO TAU SLUDGE PUMPING STATION
B. 313566
B. 314302
V. 445
B. 310220
B. 310219
B. 310218
B. 363259
B. 363260
B. 363254
B. 368252
V. 4002
V. 490
V. 491
V. 463
V. 464
835400N
835300N
835200N
835100N
835000N
834900N
834800N

7-NW-3D

7-NW-8A

NOTES:

1. FOR MAINS RECORDS SIGN CONVENTIONS AND DESIGNATIONS SEE SKETCH NO.3988.
2. DIMENSIONS OF MAINS ARE IN MILLIMETRES UNLESS OTHERWISE SPECIFIED.
3. ALL LEVELS ARE IN METRES ABOVE PRINCIPAL DATUM.

Basemap Date Updated On: 05/01/2026

SCALE 1:1 000

METRES 20 10 0 20 40 60 80 100 METRES

THIS IS A COMPUTER PRINTOUT,
NO SIGNATURE IS REQUIRED.

FRESH WATER MAINS RECORD PLAN

WSD TUNNEL, MUI SHUE HANG

COPYRIGHT RESERVED

DATE REVISED : 03/06/2026

SIGNED

C.S. CHIN
CE/MNE

DATE: 15/02/1999

DRAWING NO.

W67880/ 7-NW-3C

Water Supplies Department
HONG KONG

© The Government of the Hong Kong SAR, Map reproduced with permission of the Director of Lands