INSET 'A'	INSET 'B'	INSET 'C'	INSET 'D'	INSET 'E'	INSET 'F'

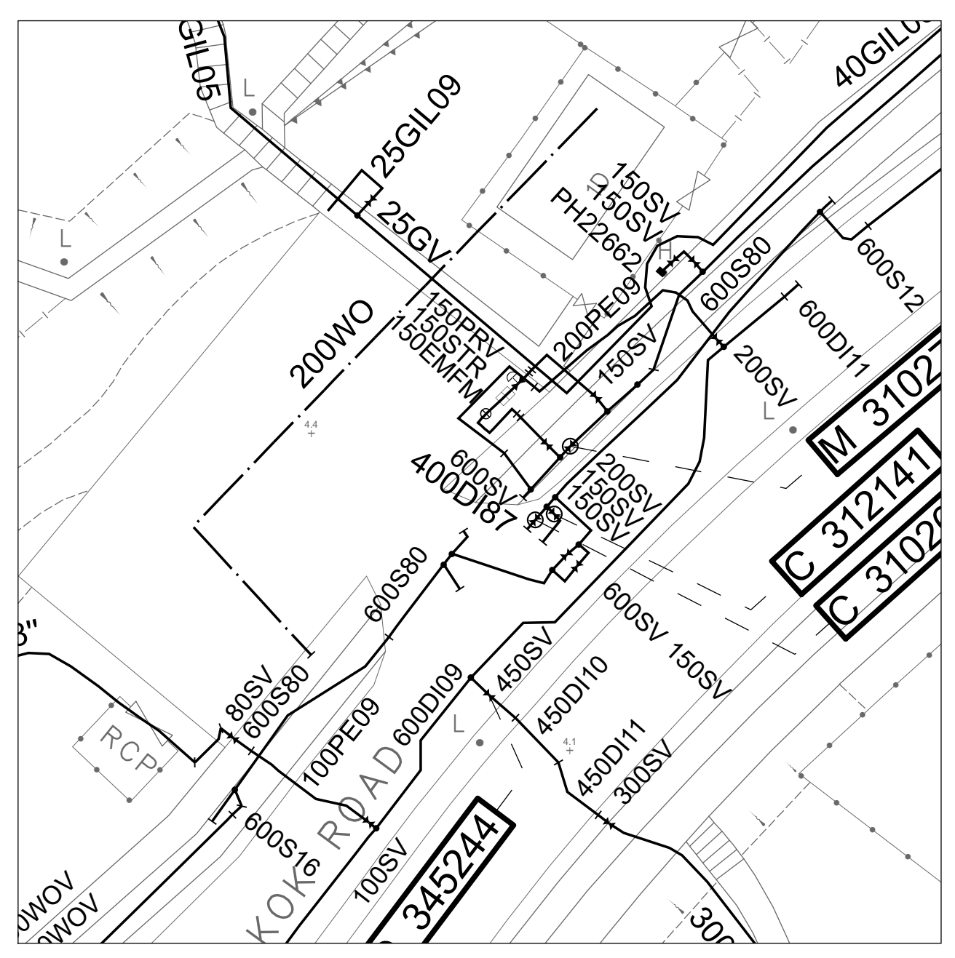

25GIL09
25GV
150SV
150SV
200WO
200PE09
150SV
600S80
600DI11
600S12
200SV
M 3102
C 312141
C 3102
400DI07
600S80
100PE09
450SV
450DI10
600SV
150SV
450DI11
300SV
KOK ROAD
345244
RCP

Scale 1:500

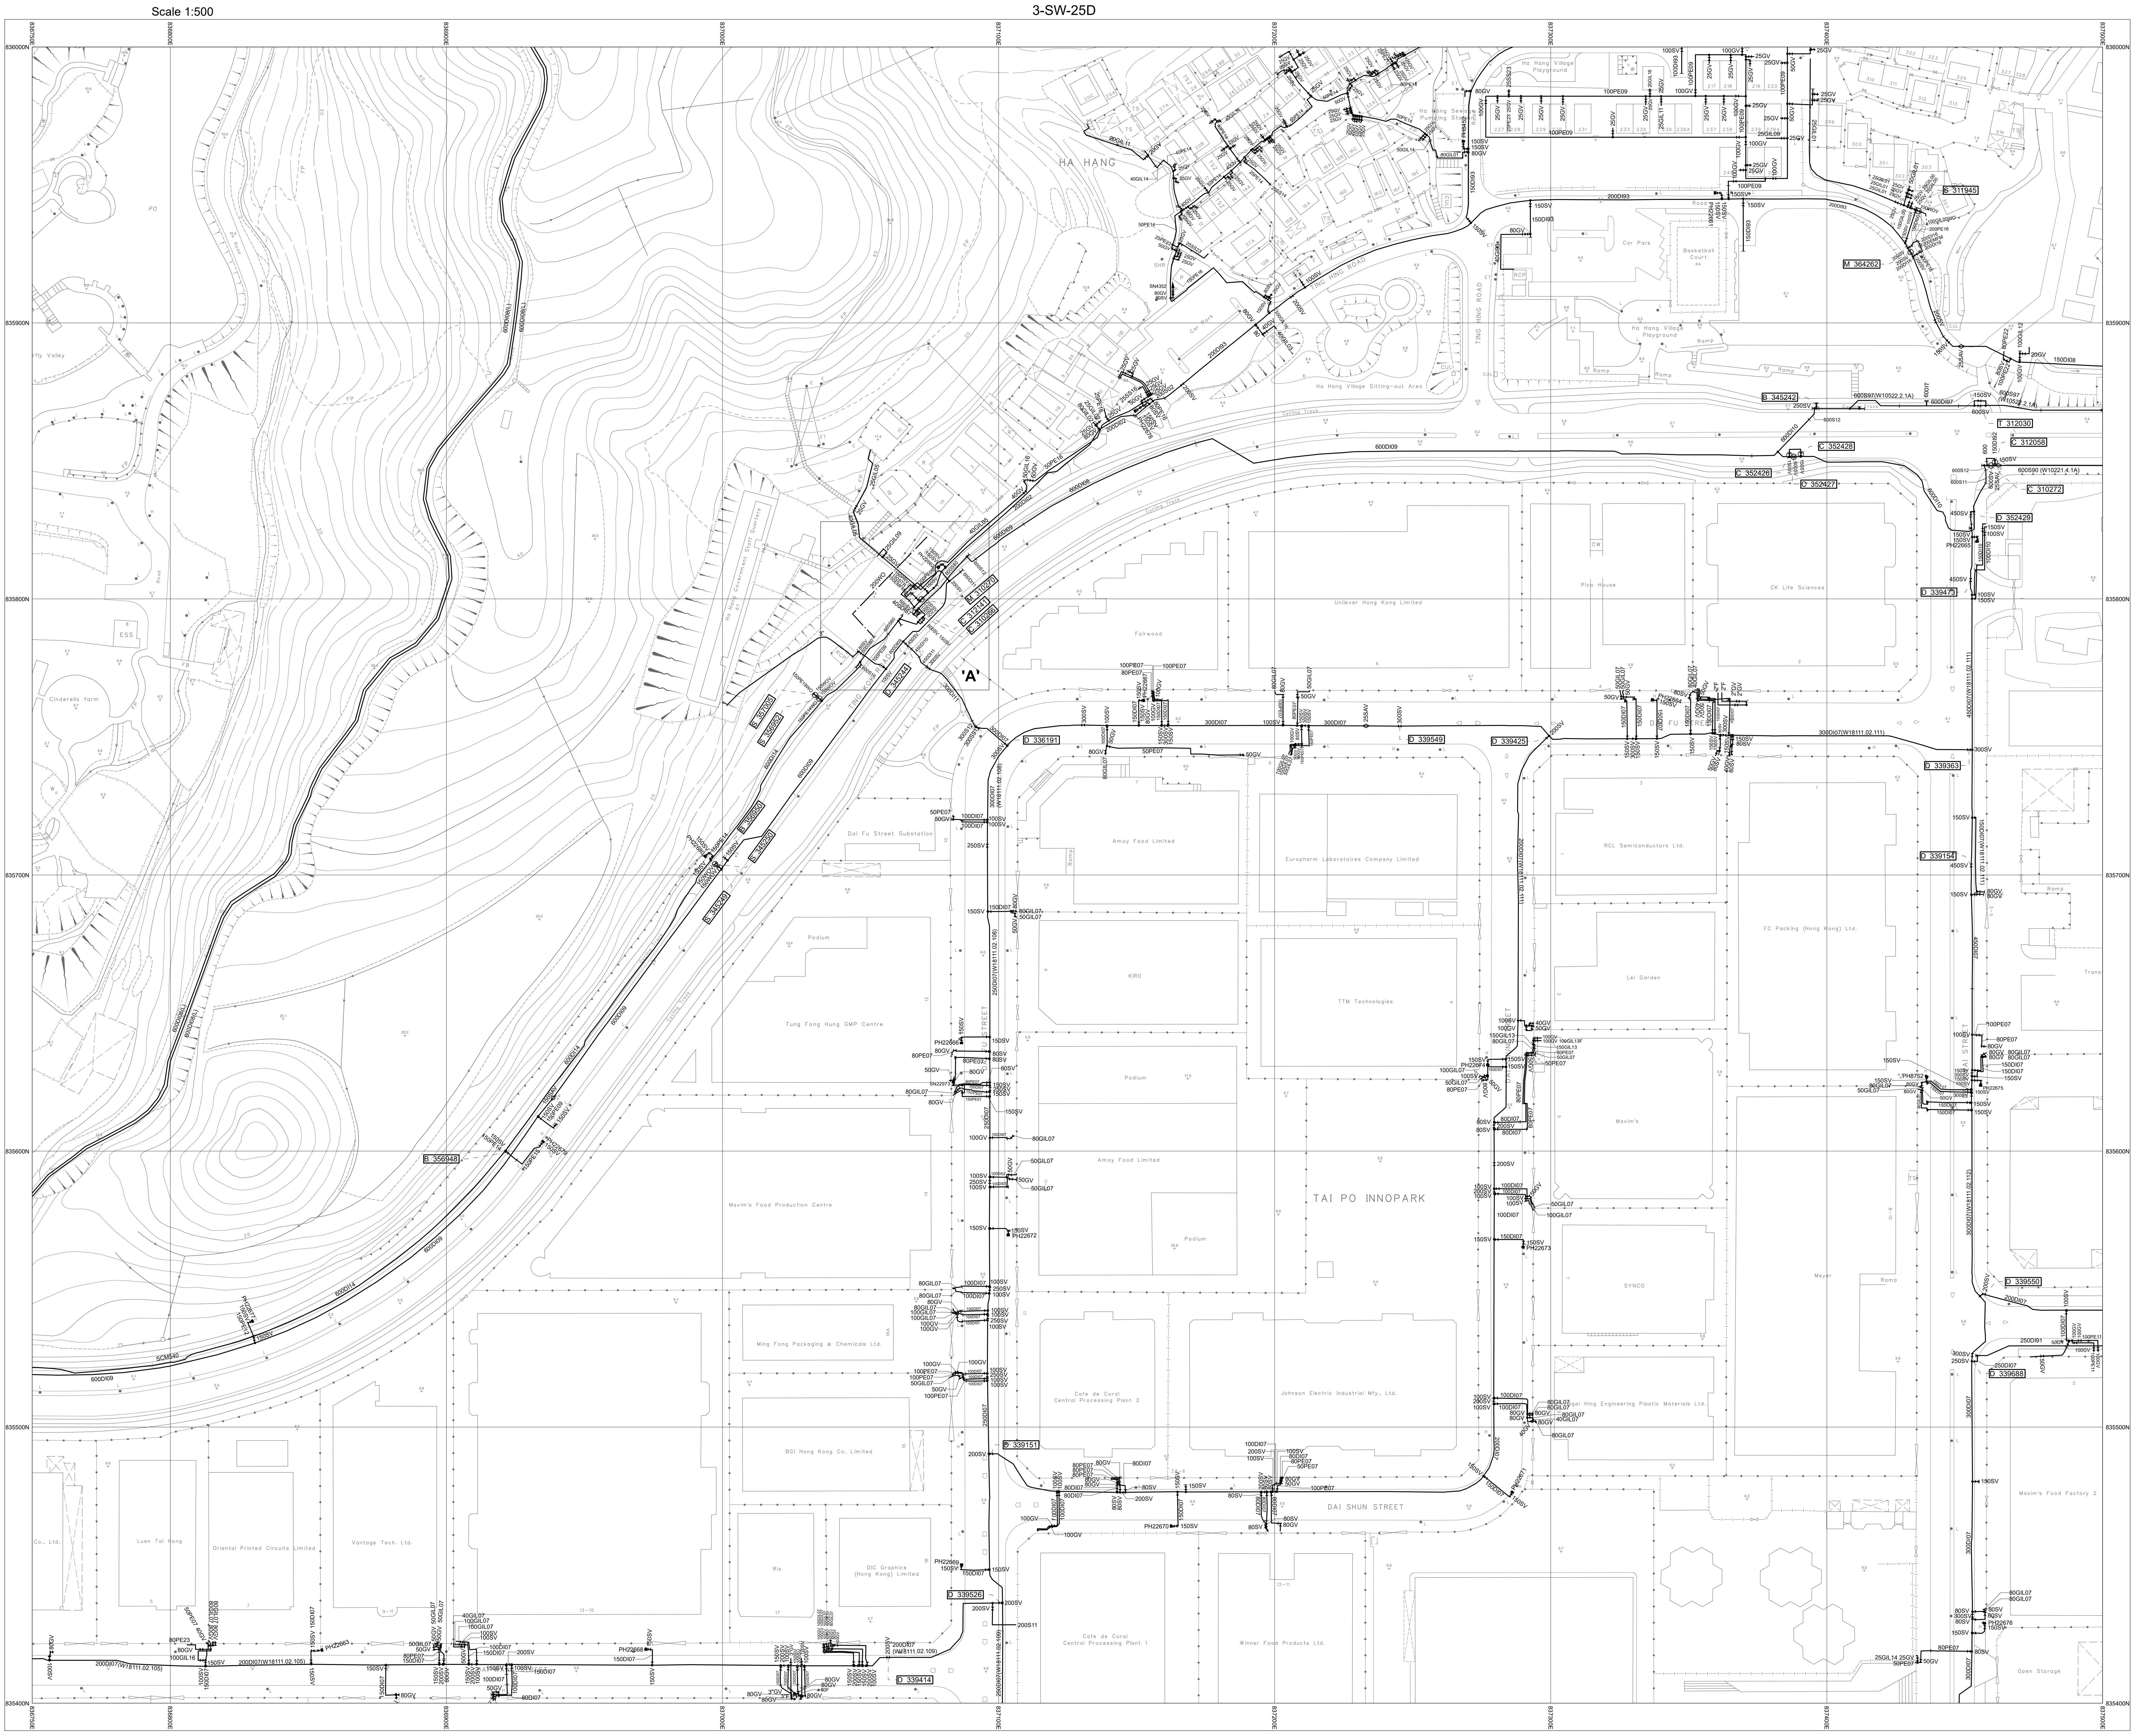

3-SW-25D
7-NW-5A
7-NE-1A
7-NW-5D
HA HANG
'A'
TAI PO INNOPARK
DAI SHUN STREET
TING HONG ROAD
Ha Hang Village Playground
Car Park
Basketball Court
Dai Fu Street Substation
Amoy Food Limited
Europharm Laboratories Company Limited
RCL Semiconductors Ltd.
TTM Technologies
Unilever Hong Kong Limited
Pilot House
CK Life Sciences
Lei Garden
FC Packing (Hong Kong) Ltd.
Maxim's
Maxim's Food Production Centre
Tung Fong Hung GMP Centre
Ming Fung Packaging & Chemicals Ltd.
BGI Hong Kong Co. Limited
Cafe de Coral Central Processing Plant 2
Cafe de Coral Central Processing Plant 1
Johnson Electric Industrial Mfy. Ltd.
Winner Food Products Ltd.
SIIC Graphics (Hong Kong) Limited
SYNCO
Meyer
Luen Tai Hong
Oriental Printed Circuits Limited
Vantage Tech. Ltd.
Cinderella farm
Fairy Valley
300DI07(W18111.02.111)
200DI07(W18111.02.105)
600DI09
SCM540
835400N
835500N
835600N
835700N
835800N
835900N
836000N
836750E
836800E
836900E

NOTES:

1. FOR MAINS RECORDS SIGN CONVENTIONS AND DESIGNATIONS SEE SKETCH NO.3988.
2. DIMENSIONS OF MAINS ARE IN MILLIMETRES UNLESS OTHERWISE SPECIFIED.
3. ALL LEVELS ARE IN METRES ABOVE PRINCIPAL DATUM.

Basemap Date Updated On: 05/01/2026

SCALE 1:1 000

METRES 20 10 0 20 40 60 80 100 METRES

THIS IS A COMPUTER PRINTOUT,
NO SIGNATURE IS REQUIRED.

FRESH WATER MAINS RECORD PLAN

TING KOK ROAD, HA HANG

COPYRIGHT RESERVED

DATE REVISED : 03/09/2026

DRAWING NO.

W67880/ 7-NW-5B

SIGNED C.S. CHIN
CE/MNE
DATE: 15/02/1999

Water Supplies Department
HONG KONG

© The Government of the Hong Kong SAR, Map reproduced with permission of the Director of Lands