INSET 'A'	INSET 'B'	INSET 'C'	INSET 'D'	INSET 'E'	INSET 'F'

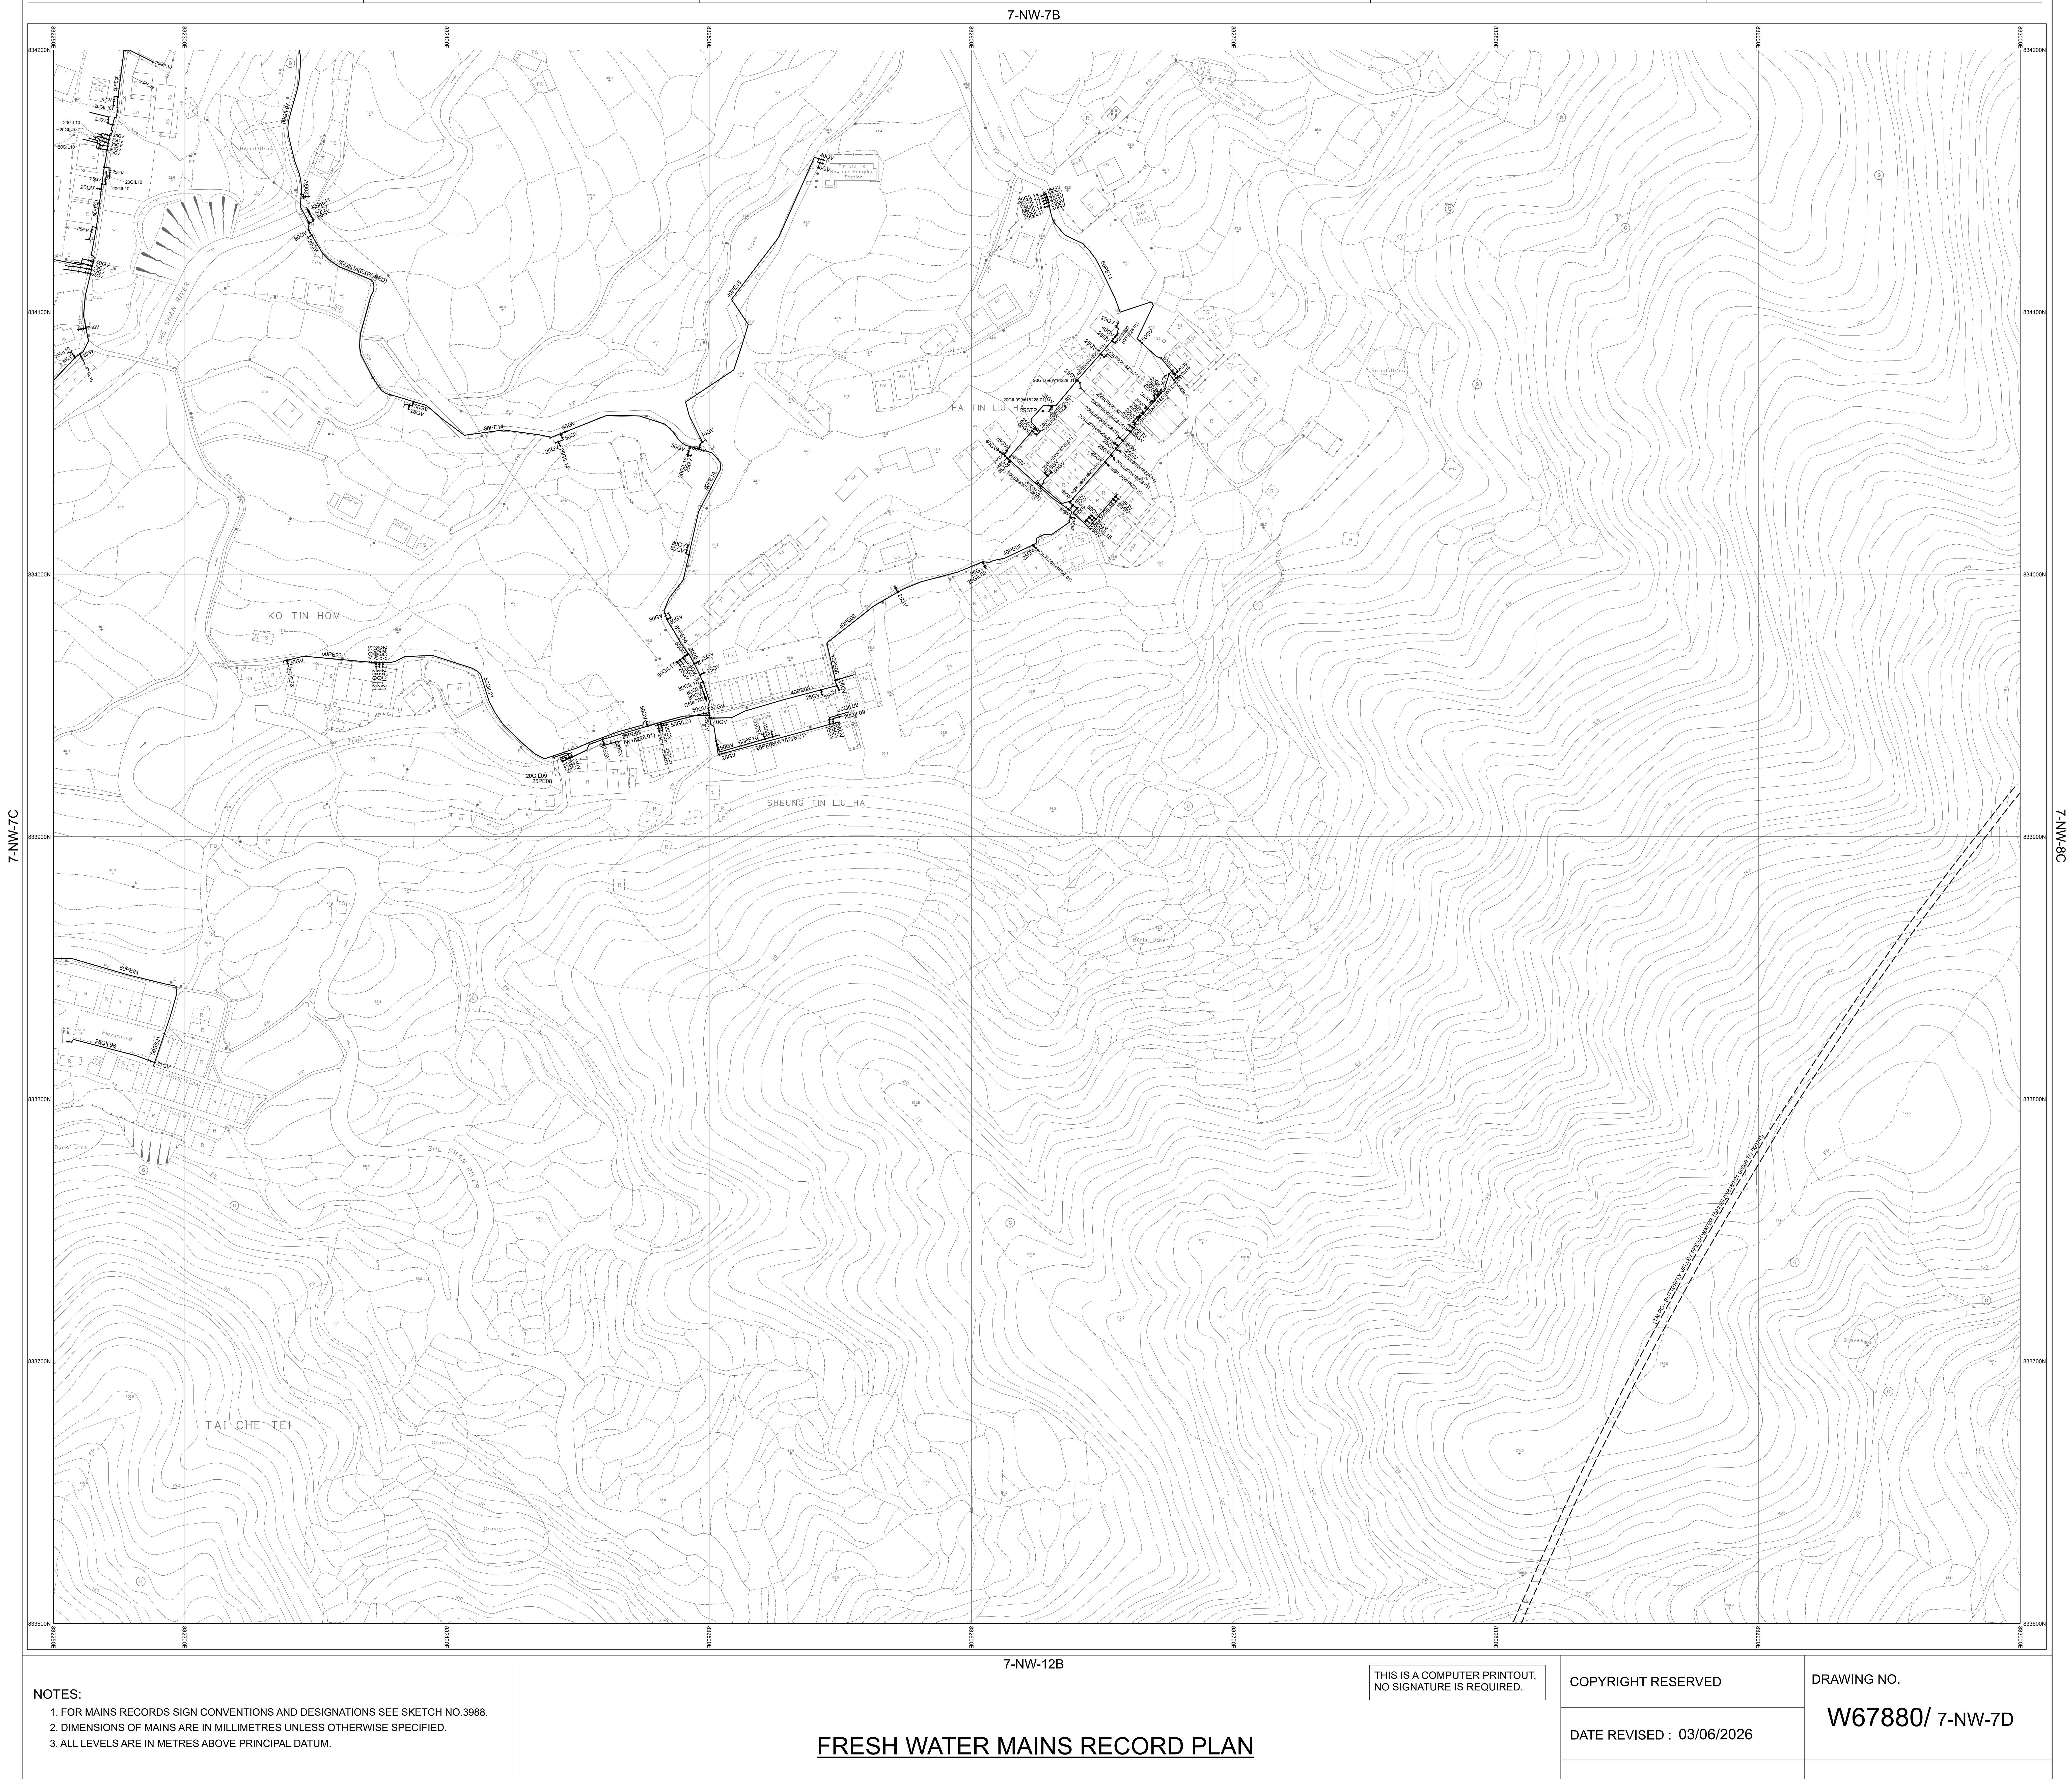
7-NW-7B
7-NW-7C
7-NW-8C
7-NW-12B
834200N
834100N
834000N
833900N
833800N
833700N
833600N
KO TIN HOM
HA TIN LIU HA
SHEUNG TIN LIU HA
TAI CHE TEI
SHE SHAN RIVER

NOTES:

1. FOR MAINS RECORDS SIGN CONVENTIONS AND DESIGNATIONS SEE SKETCH NO.3988.
2. DIMENSIONS OF MAINS ARE IN MILLIMETRES UNLESS OTHERWISE SPECIFIED.
3. ALL LEVELS ARE IN METRES ABOVE PRINCIPAL DATUM.

Basemap Date Updated On: 05/01/2026

SCALE 1:1 000

METRES 20 10 0 20 40 60 80 100 METRES

THIS IS A COMPUTER PRINTOUT,
NO SIGNATURE IS REQUIRED.

FRESH WATER MAINS RECORD PLAN

SHEUNG TIN LIU HA, TAI CHE TEI

COPYRIGHT RESERVED

DATE REVISED : 03/06/2026

SIGNED
C.S. CHIN
CE/MNE
DATE: 15/02/1999

DRAWING NO.
W67880/ 7-NW-7D

Water Supplies Department
HONG KONG

© The Government of the Hong Kong SAR, Map reproduced with permission of the Director of Lands