INSET 'A'	INSET 'B'	INSET 'C'	INSET 'D'	INSET 'E'	INSET 'F'

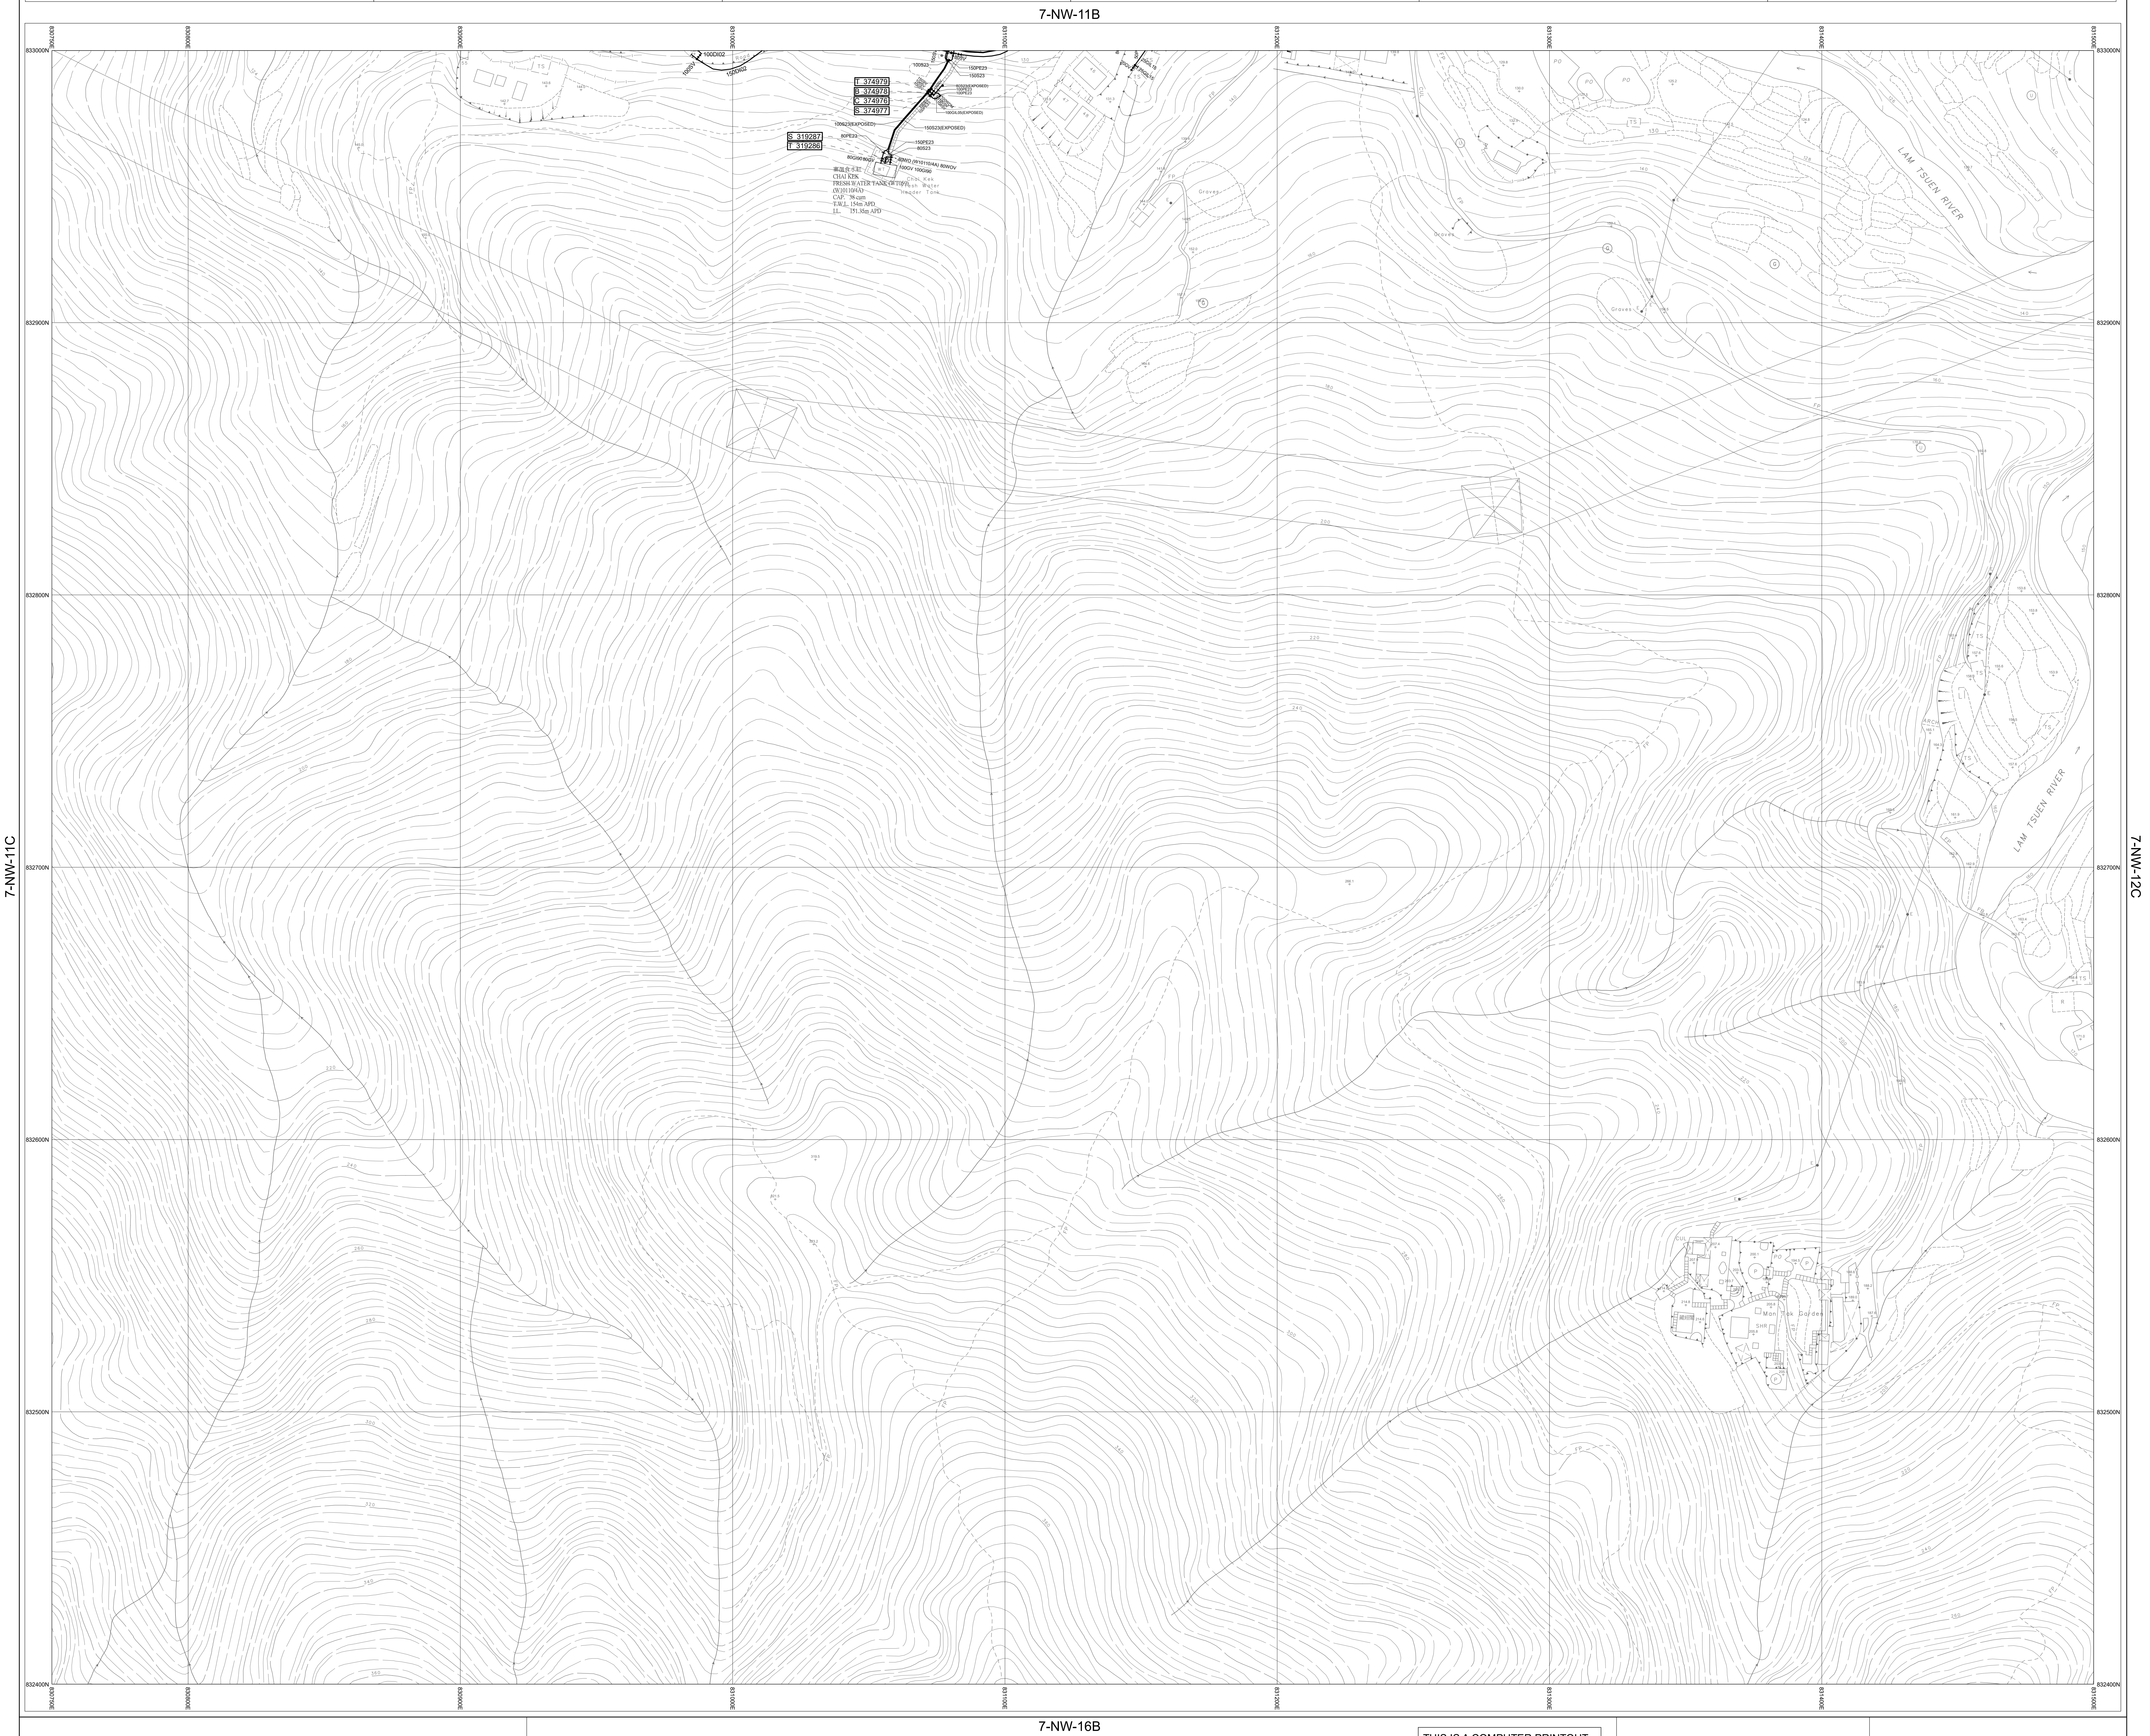
7-NW-11B
7-NW-11C
7-NW-12C
7-NW-16B
830750E
830800E
830900E
831000E
831100E
831200E
831300E
831400E
831500E
833000N
832900N
832800N
832700N
832600N
832500N
832400N
T 374979
B 374978
C 374976
S 374977
S 319287
T 319286
100S23
150PE23
150S23
80SV
150SV
100SV
80S23(EXPOSED)
100PE23
100WDM
100GIL05(EXPOSED)
100S23(EXPOSED)
150S23(EXPOSED)
80PE23
80S23
80GI90 80GV
80WO (W10110/4A) 80WOV
100GV 100GI90
WT
寨乪食水缸
CHAI KEK
FRESH WATER TANK (WT059)
(W10110/4A)
CAP. 38 cum
T.W.L. 154m APD
I.L. 151.35m APD
Chai Kek
Fresh Water
Header Tank
LAM TSUEN RIVER
LAM TSUEN RIVER
360
260

THIS IS A COMPUTER PRINTOUT,
NO SIGNATURE IS REQUIRED.

NOTES:

1. FOR MAINS RECORDS SIGN CONVENTIONS AND DESIGNATIONS SEE SKETCH NO.3988.
2. DIMENSIONS OF MAINS ARE IN MILLIMETRES UNLESS OTHERWISE SPECIFIED.
3. ALL LEVELS ARE IN METRES ABOVE PRINCIPAL DATUM.

Basemap Date Updated On: 23/12/2024

SCALE 1:1 000

METRES 20 10 0 20 40 60 80 100 METRES

FRESH WATER MAINS RECORD PLAN

LAM TSUEN RIVER, NG TUNG CHAI

COPYRIGHT RESERVED

DATE REVISED : 05/03/2025

DRAWING NO.
W67880/ 7-NW-11D

SIGNED
C.S. CHIN
CE/MNE
DATE: 15/02/1999

Water Supplies Department
HONG KONG

© The Government of the Hong Kong SAR, Map reproduced with permission of the Director of Lands