INSET 'A' | INSET 'B' | INSET 'C' | INSET 'D' | INSET 'E' | INSET 'F'

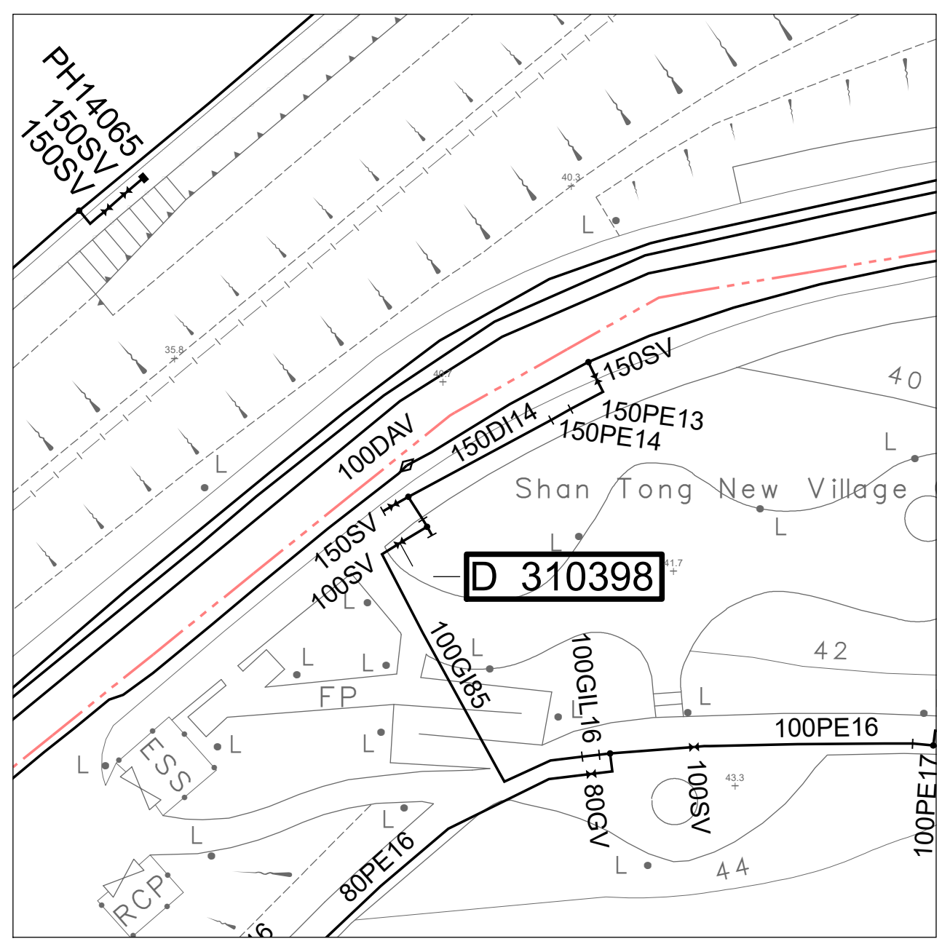
PH14065
150SV
150SV
100DAV
150DI14
150SV
150PE13
150PE14
Shan Tong New Village
D 310398
150SV
100SV
100GIU5
100GIU16
100SV
80GV
100PE16
100PE17
80PE16
FP
40
42
44

Scale 1:500

7-NW-9D

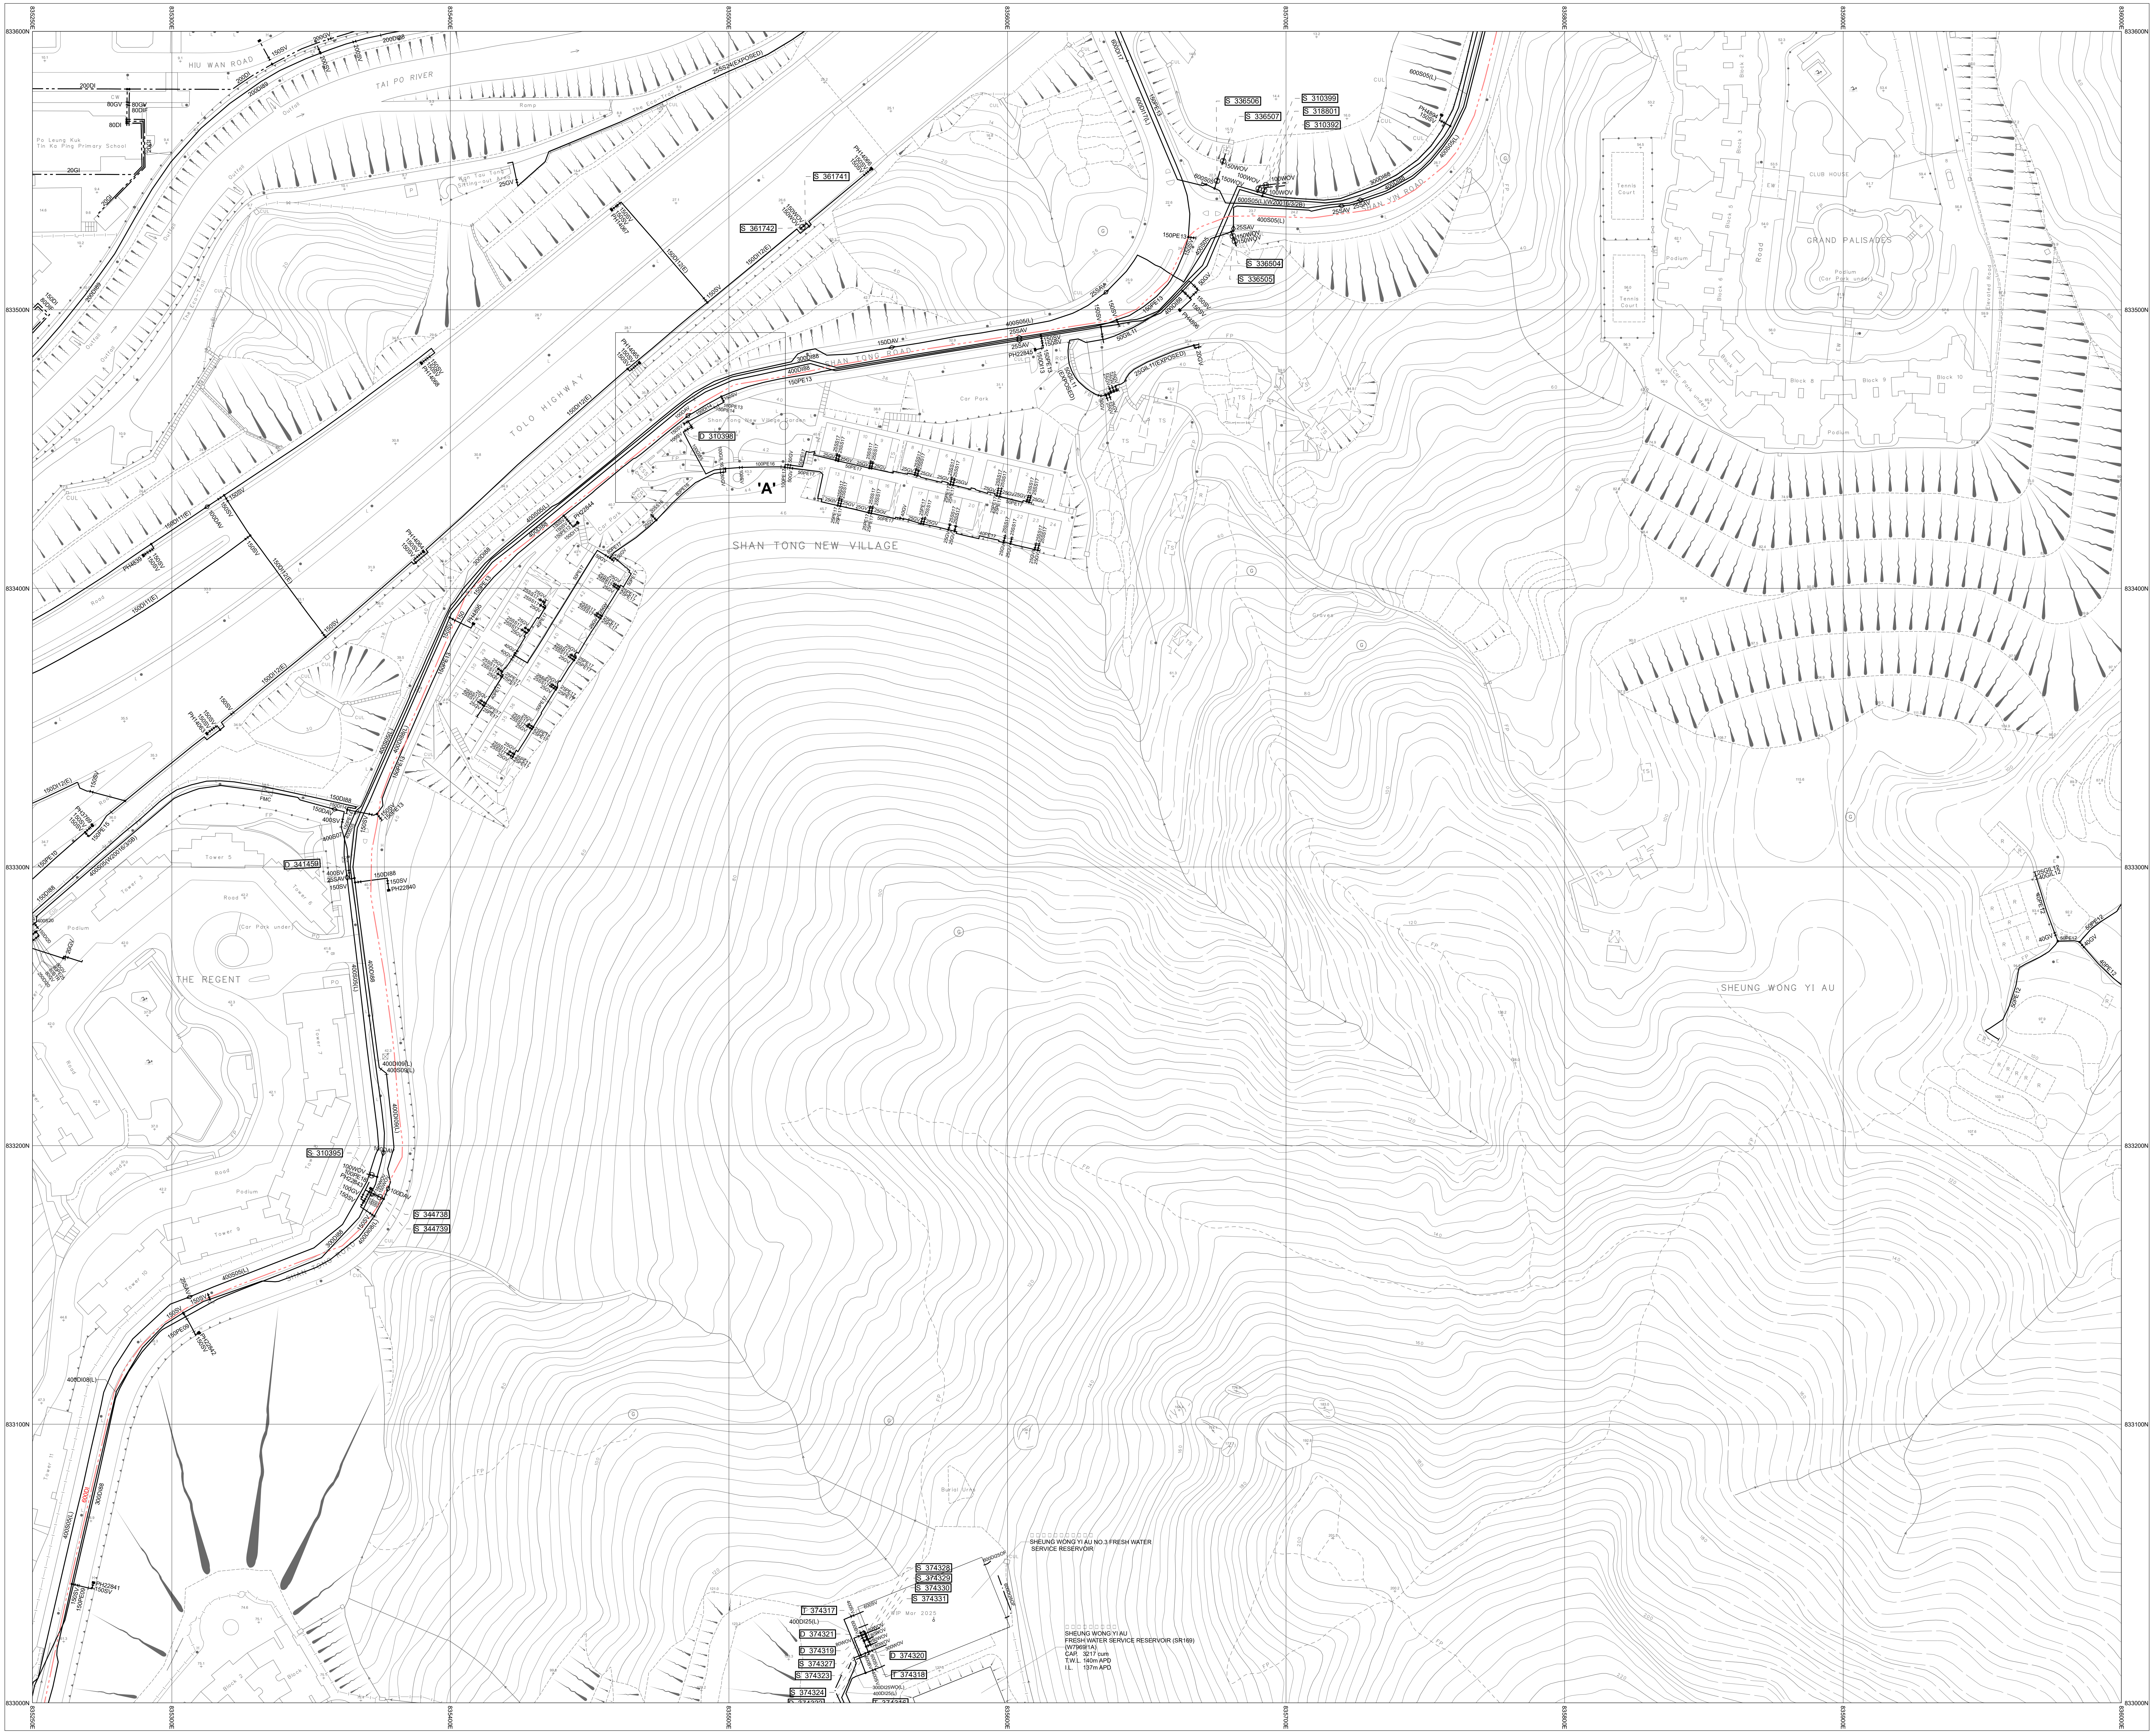
7-NW-14A
7-NW-15A
HIU WAN ROAD
TAI PO RIVER
TOLO HIGHWAY
SHAN TONG ROAD
SHAN TONG NEW VILLAGE
'A'
D 310398
THE REGENT
GRAND PALISADES
CLUB HOUSE
SHEUNG WONG YI AU
833600N
833500N
833400N
833300N
833200N
833100N
833000N
835250E
835300E
835400E
835600E
SHEUNG WONG YI AU NO.3 FRESH WATER SERVICE RESERVOIR
SHEUNG WONG YI AU
FRESH WATER SERVICE RESERVOIR (SR169)
(W7969/1A)
CAP. 3217 cum
T.W.L. 140m APD
I.L. 137m APD
600DI25OF

7-NW-14D

NOTES:

1. FOR MAINS RECORDS SIGN CONVENTIONS AND DESIGNATIONS SEE SKETCH NO.3988.
2. DIMENSIONS OF MAINS ARE IN MILLIMETRES UNLESS OTHERWISE SPECIFIED.
3. ALL LEVELS ARE IN METRES ABOVE PRINCIPAL DATUM.

Basemap Date Updated On: 05/01/2026

SCALE 1:1 000

METRES 20 10 0 20 40 60 80 100 METRES

THIS IS A COMPUTER PRINTOUT,
NO SIGNATURE IS REQUIRED.

FRESH WATER MAINS RECORD PLAN

TOLO HIGHWAY, SHAN TONG NEW VILLAGE

COPYRIGHT RESERVED

DATE REVISED : 05/10/2026

DRAWING NO.

W67880/ 7-NW-14B

SIGNED

C.S. CHIN
CE/MNE

DATE: 15/02/1999

Water Supplies Department
HONG KONG

© The Government of the Hong Kong SAR, Map reproduced with permission of the Director of Lands