
INSET 'A'	INSET 'B'	INSET 'C'	INSET 'D'	INSET 'E'	INSET 'F'

7-NW-10C

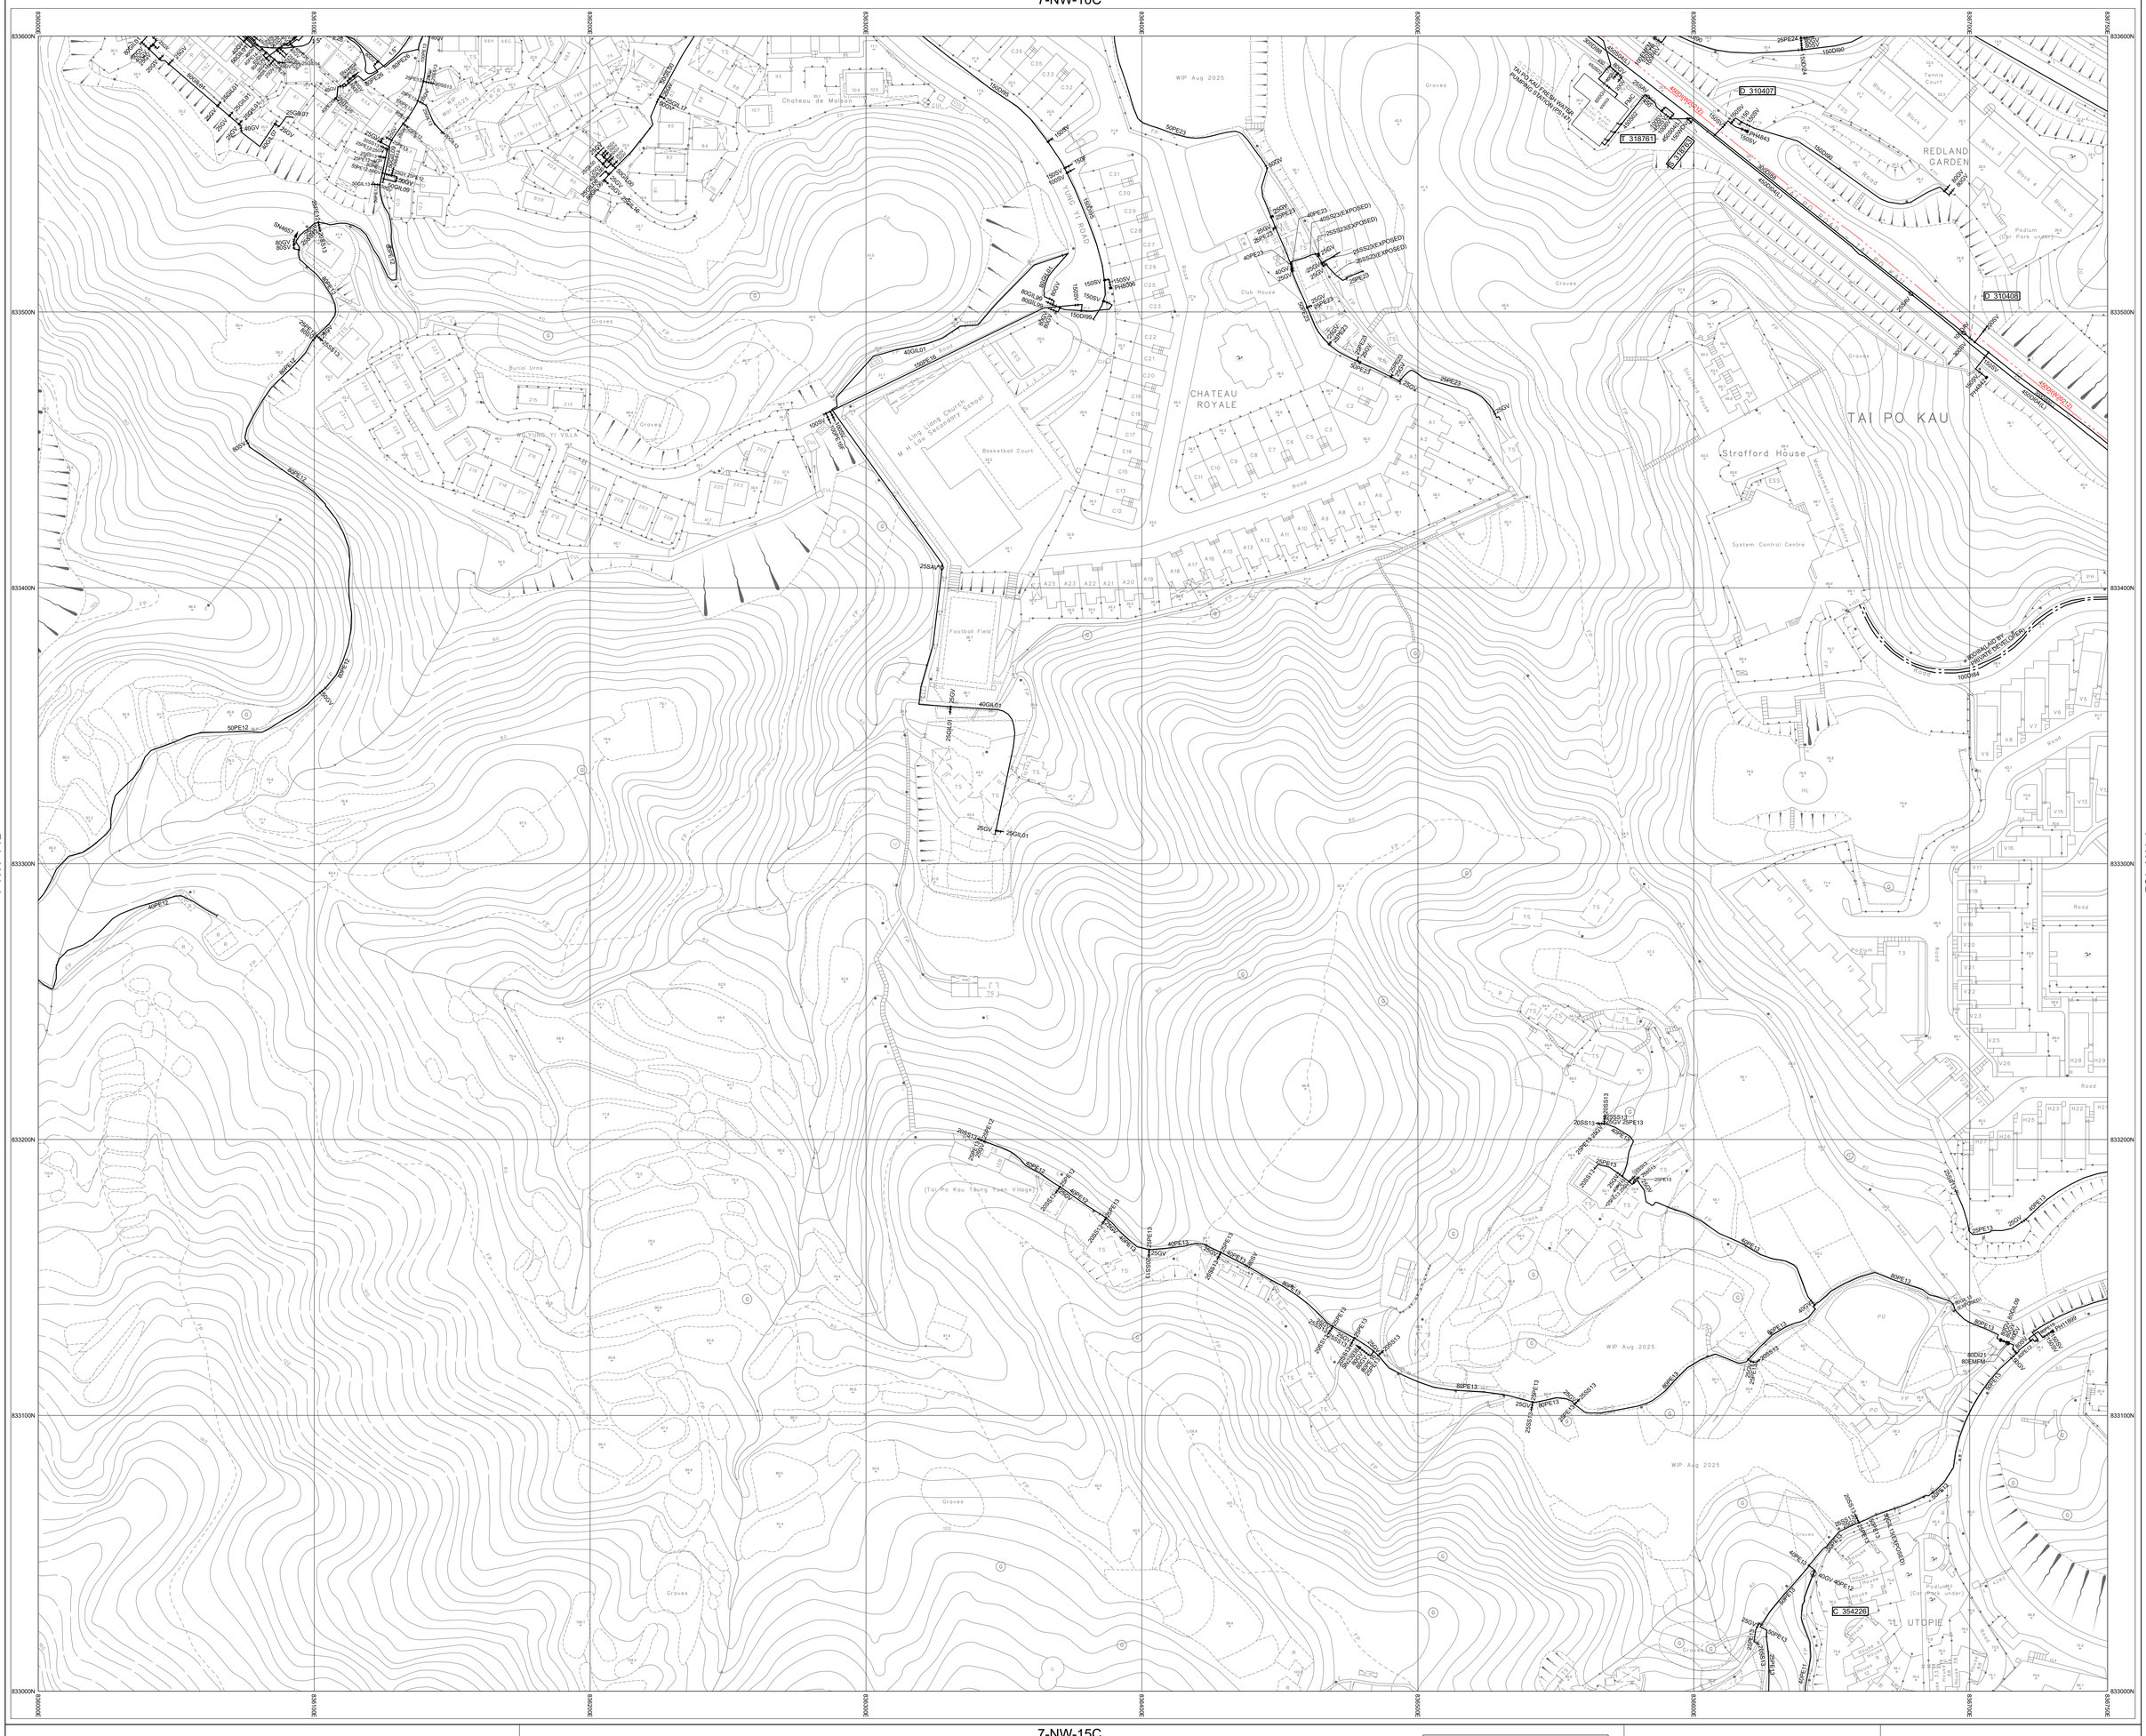

7-NW-15C

NOTES:

1. FOR MAINS RECORDS SIGN CONVENTIONS AND DESIGNATIONS SEE SKETCH NO.3988.
2. DIMENSIONS OF MAINS ARE IN MILLIMETRES UNLESS OTHERWISE SPECIFIED.
3. ALL LEVELS ARE IN METRES ABOVE PRINCIPAL DATUM.

Basemap Date Updated On: 05/01/2026

SCALE 1:1 000

METRES 20 10 0 20 40 60 80 100 METRES

THIS IS A COMPUTER PRINTOUT, NO SIGNATURE IS REQUIRED.

FRESH WATER MAINS RECORD PLAN

TAI PO ROAD, TAI PO KAU

COPYRIGHT RESERVED

DATE REVISED : 14/08/2026

DRAWING NO.

W67880/ 7-NW-15A

SIGNED

C.S. CHIN
CE/MNE

DATE: 15/02/1999

Water Supplies Department
HONG KONG

© The Government of the Hong Kong SAR, Map reproduced with permission of the Director of Lands