INSET 'A' | INSET 'B' | INSET 'C' | INSET 'D' | INSET 'E' | INSET 'F'

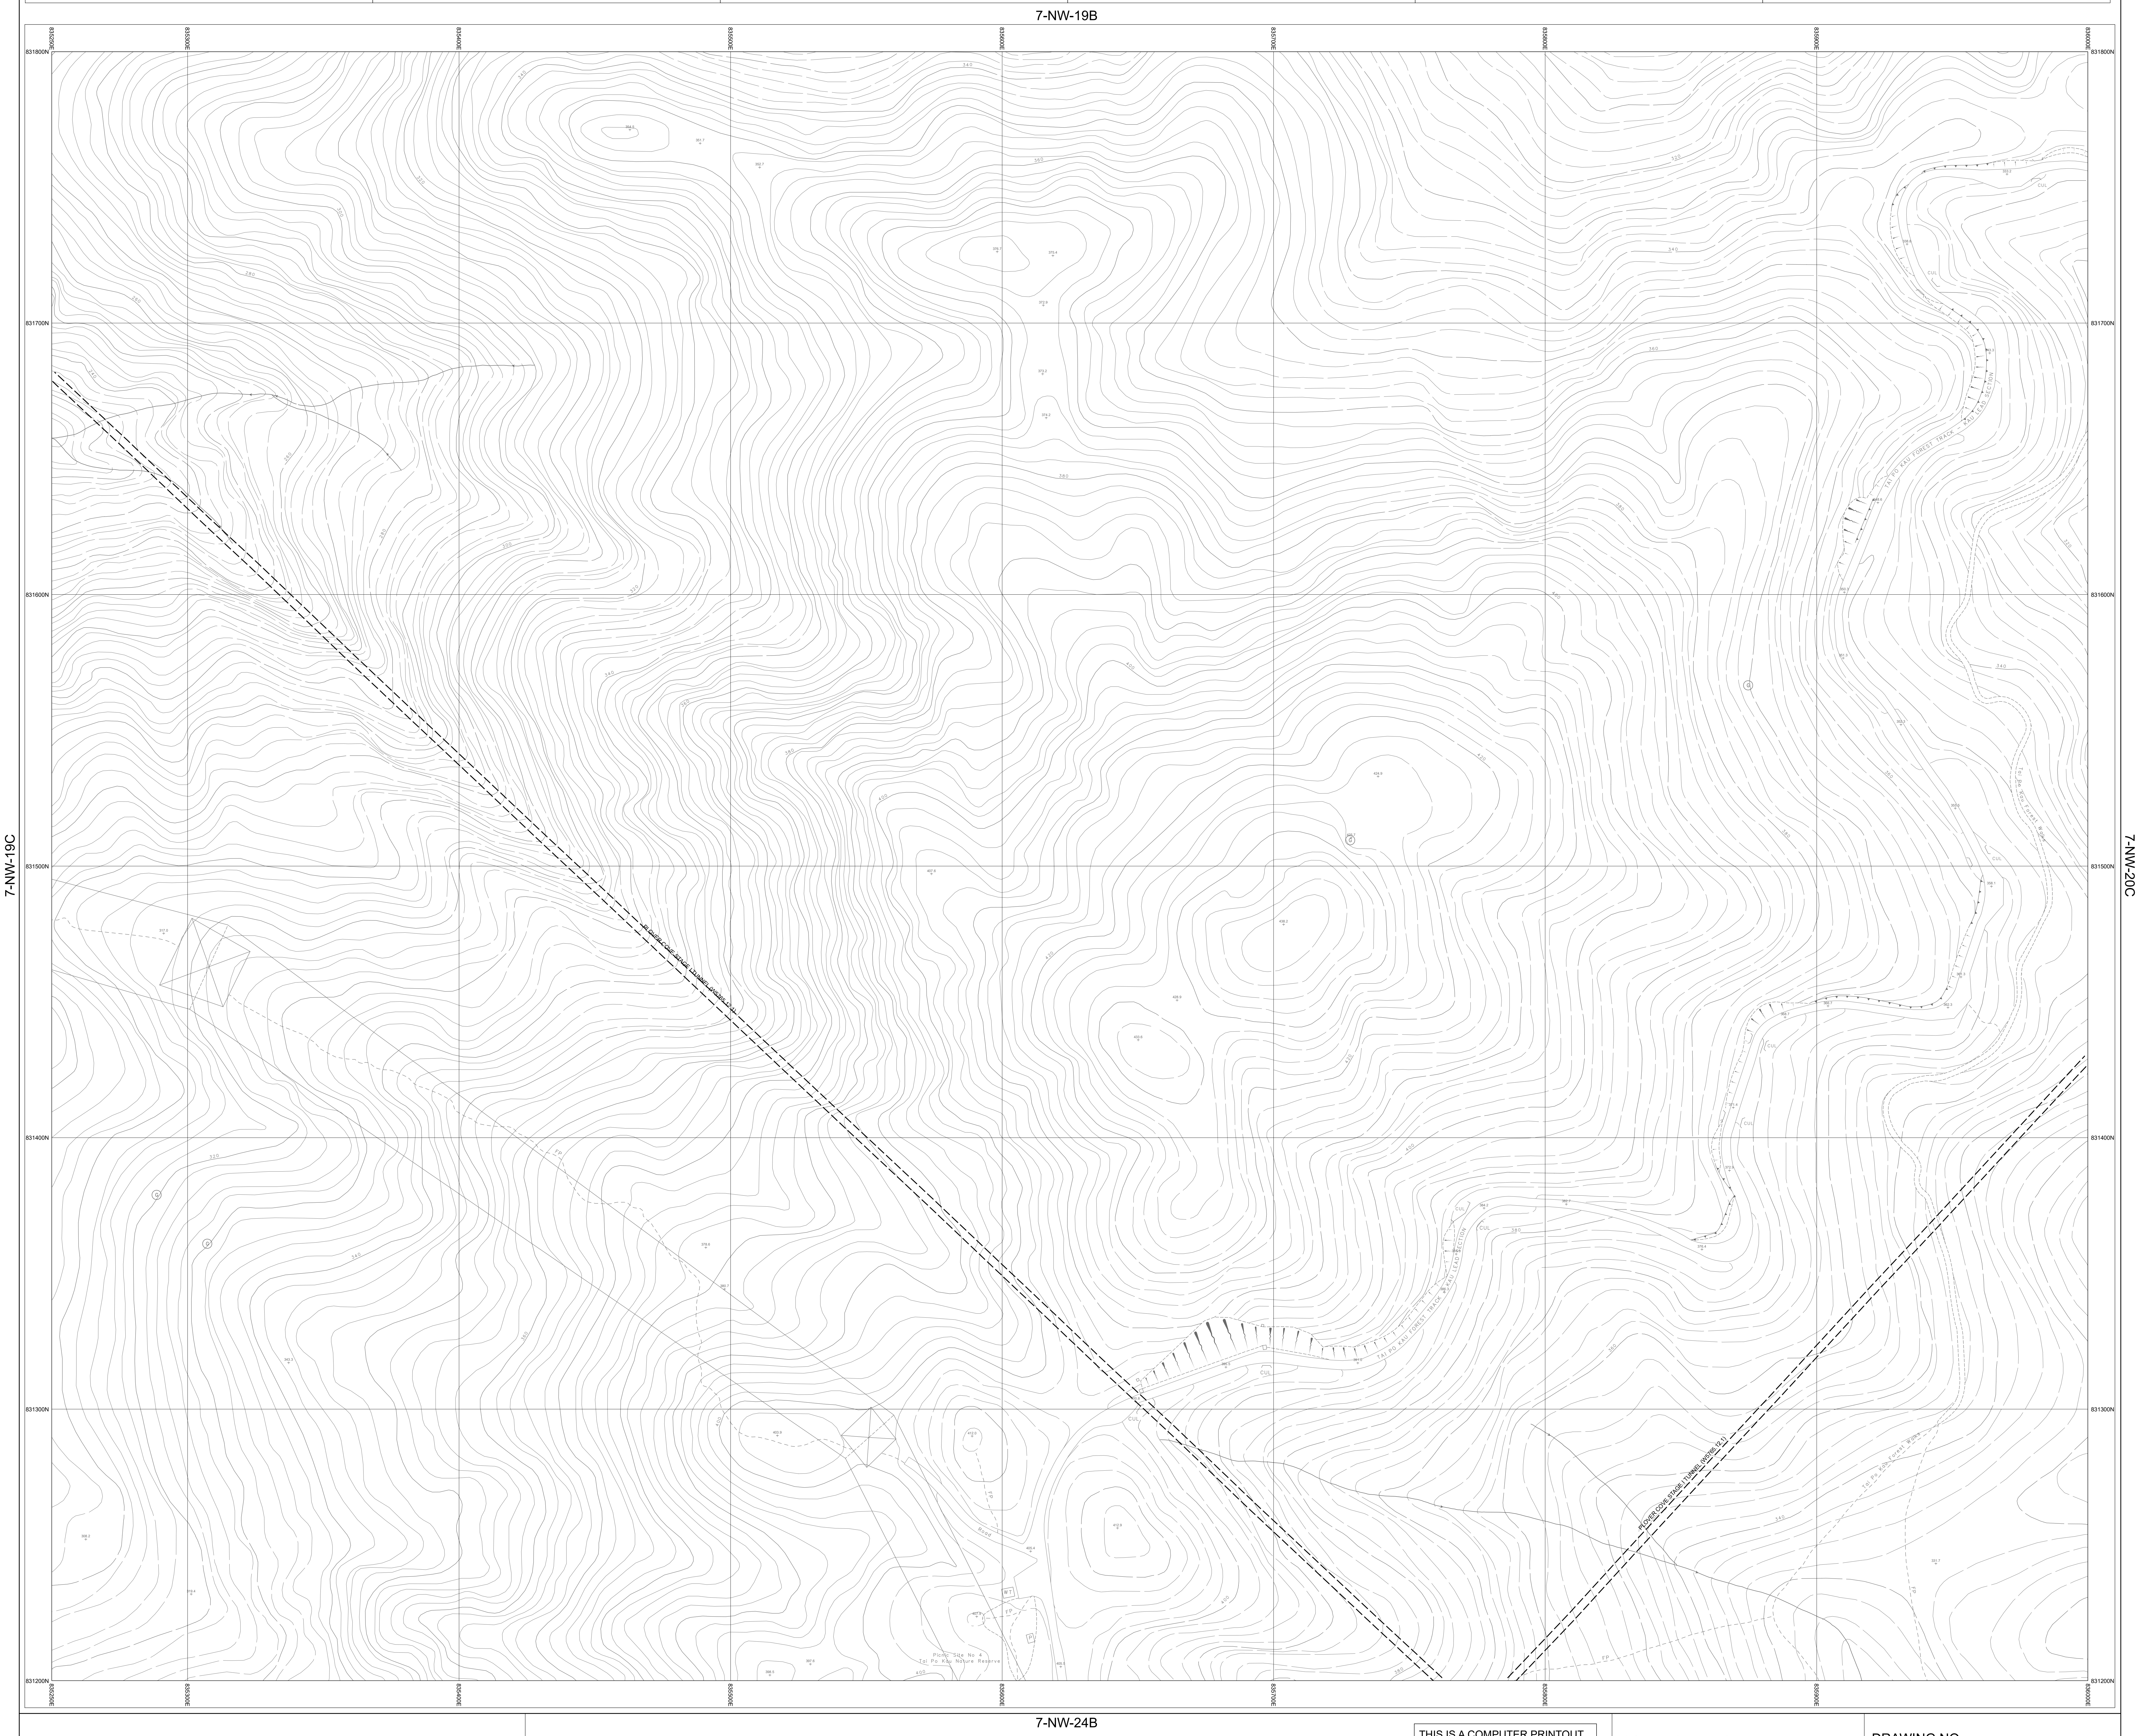
7-NW-19B
7-NW-19C
7-NW-20C
7-NW-24B
PLOVER COVE STAGE I TUNNEL (W5765.12.1)
PLOVER COVE STAGE I TUNNEL (W5765.12.1)
Picnic Site No 4
Tai Po Kau Nature Reserve
FP
360
340
380
400
831200N
835250E
835300E
835400E
835500E
835600E
835800E
835900E
836000E

NOTES:

1. FOR MAINS RECORDS SIGN CONVENTIONS AND DESIGNATIONS SEE SKETCH NO.3988.
2. DIMENSIONS OF MAINS ARE IN MILLIMETRES UNLESS OTHERWISE SPECIFIED.
3. ALL LEVELS ARE IN METRES ABOVE PRINCIPAL DATUM.

Basemap Date Updated On: 23/12/2024

SCALE 1:1 000

METRES 20 10 0 20 40 60 80 100 METRES

THIS IS A COMPUTER PRINTOUT,
NO SIGNATURE IS REQUIRED.

FRESH WATER MAINS RECORD PLAN

SHING MUN COUNTRY PARK, LEAD MINE PASS

COPYRIGHT RESERVED

DATE REVISED : 30/12/2024

DRAWING NO.
W67880/ 7-NW-19D

SIGNED
C.S. CHIN
CE/MNE
DATE: 15/02/1999

Water Supplies Department
HONG KONG

© The Government of the Hong Kong SAR, Map reproduced with permission of the Director of Lands