INSET 'A'

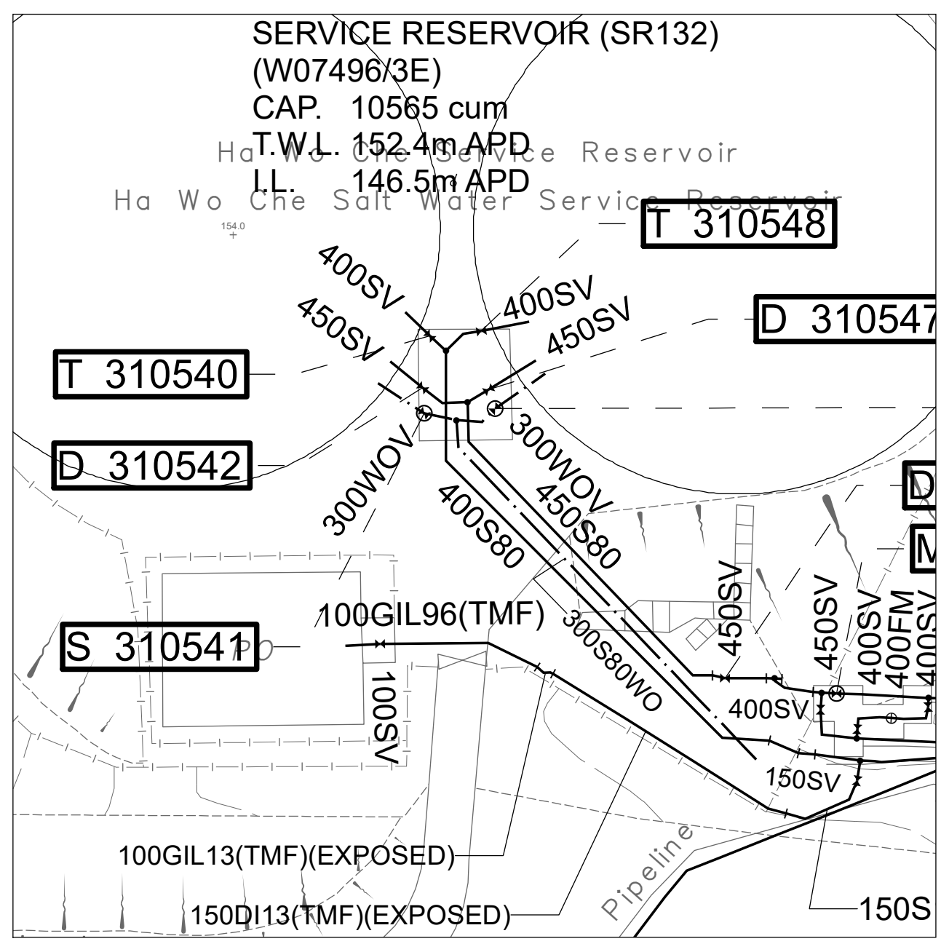

Scale 1:500

INSET 'B'

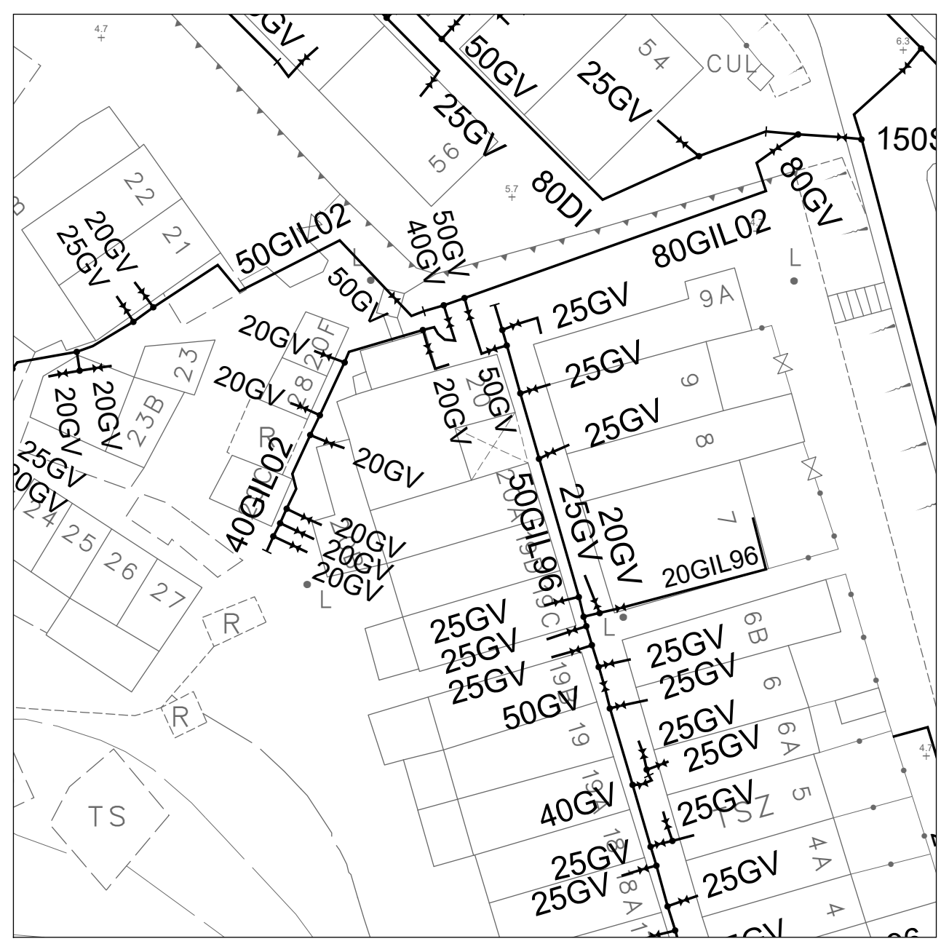

Scale 1:500

INSET 'C'

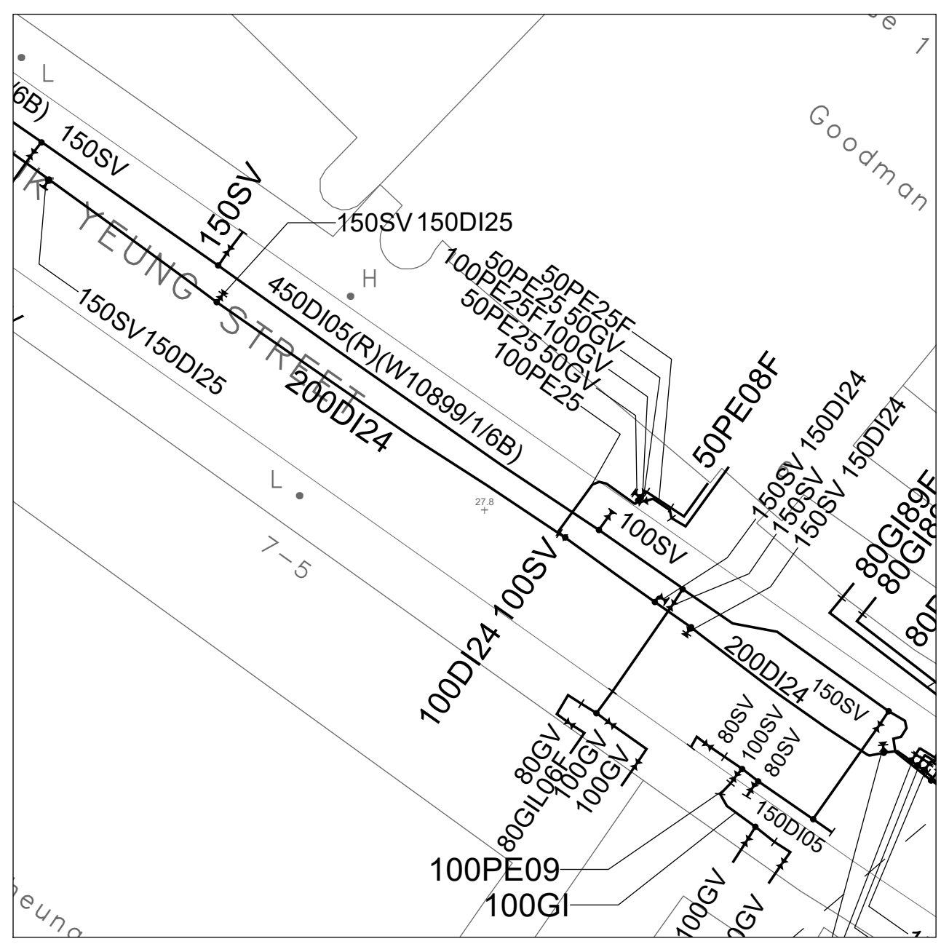

Scale 1:500

INSET 'D'

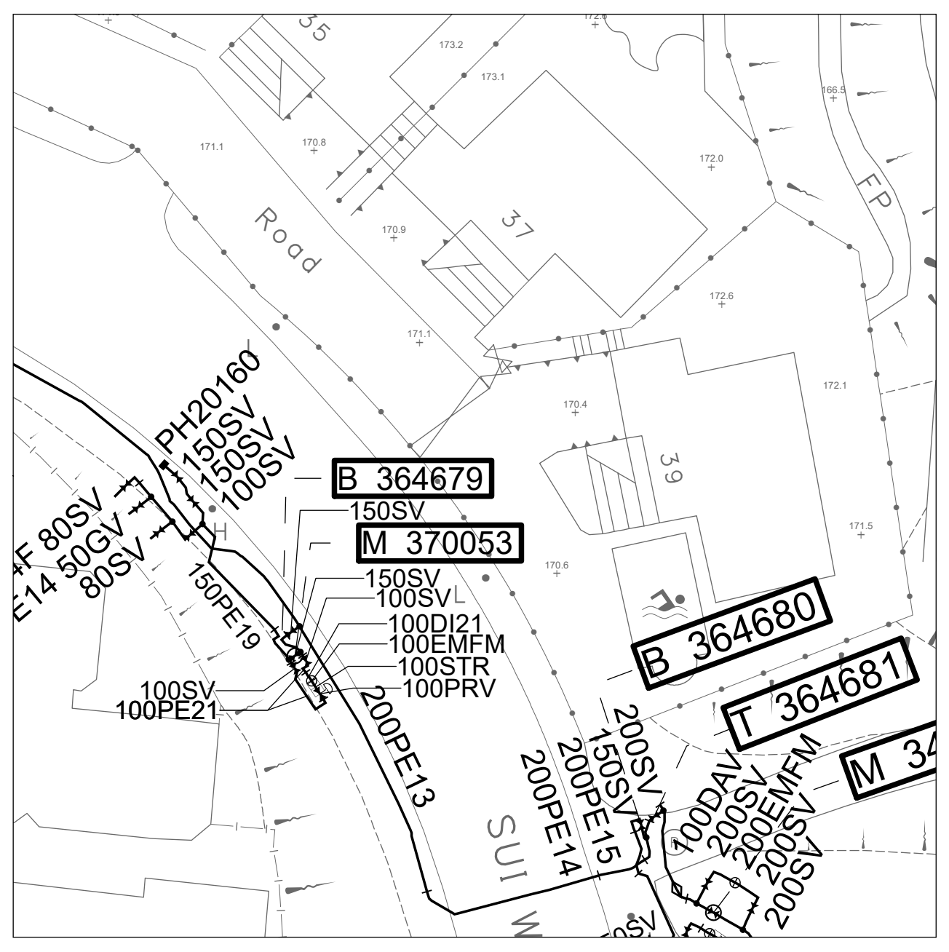

Scale 1:500

INSET 'E'

INSET 'F'

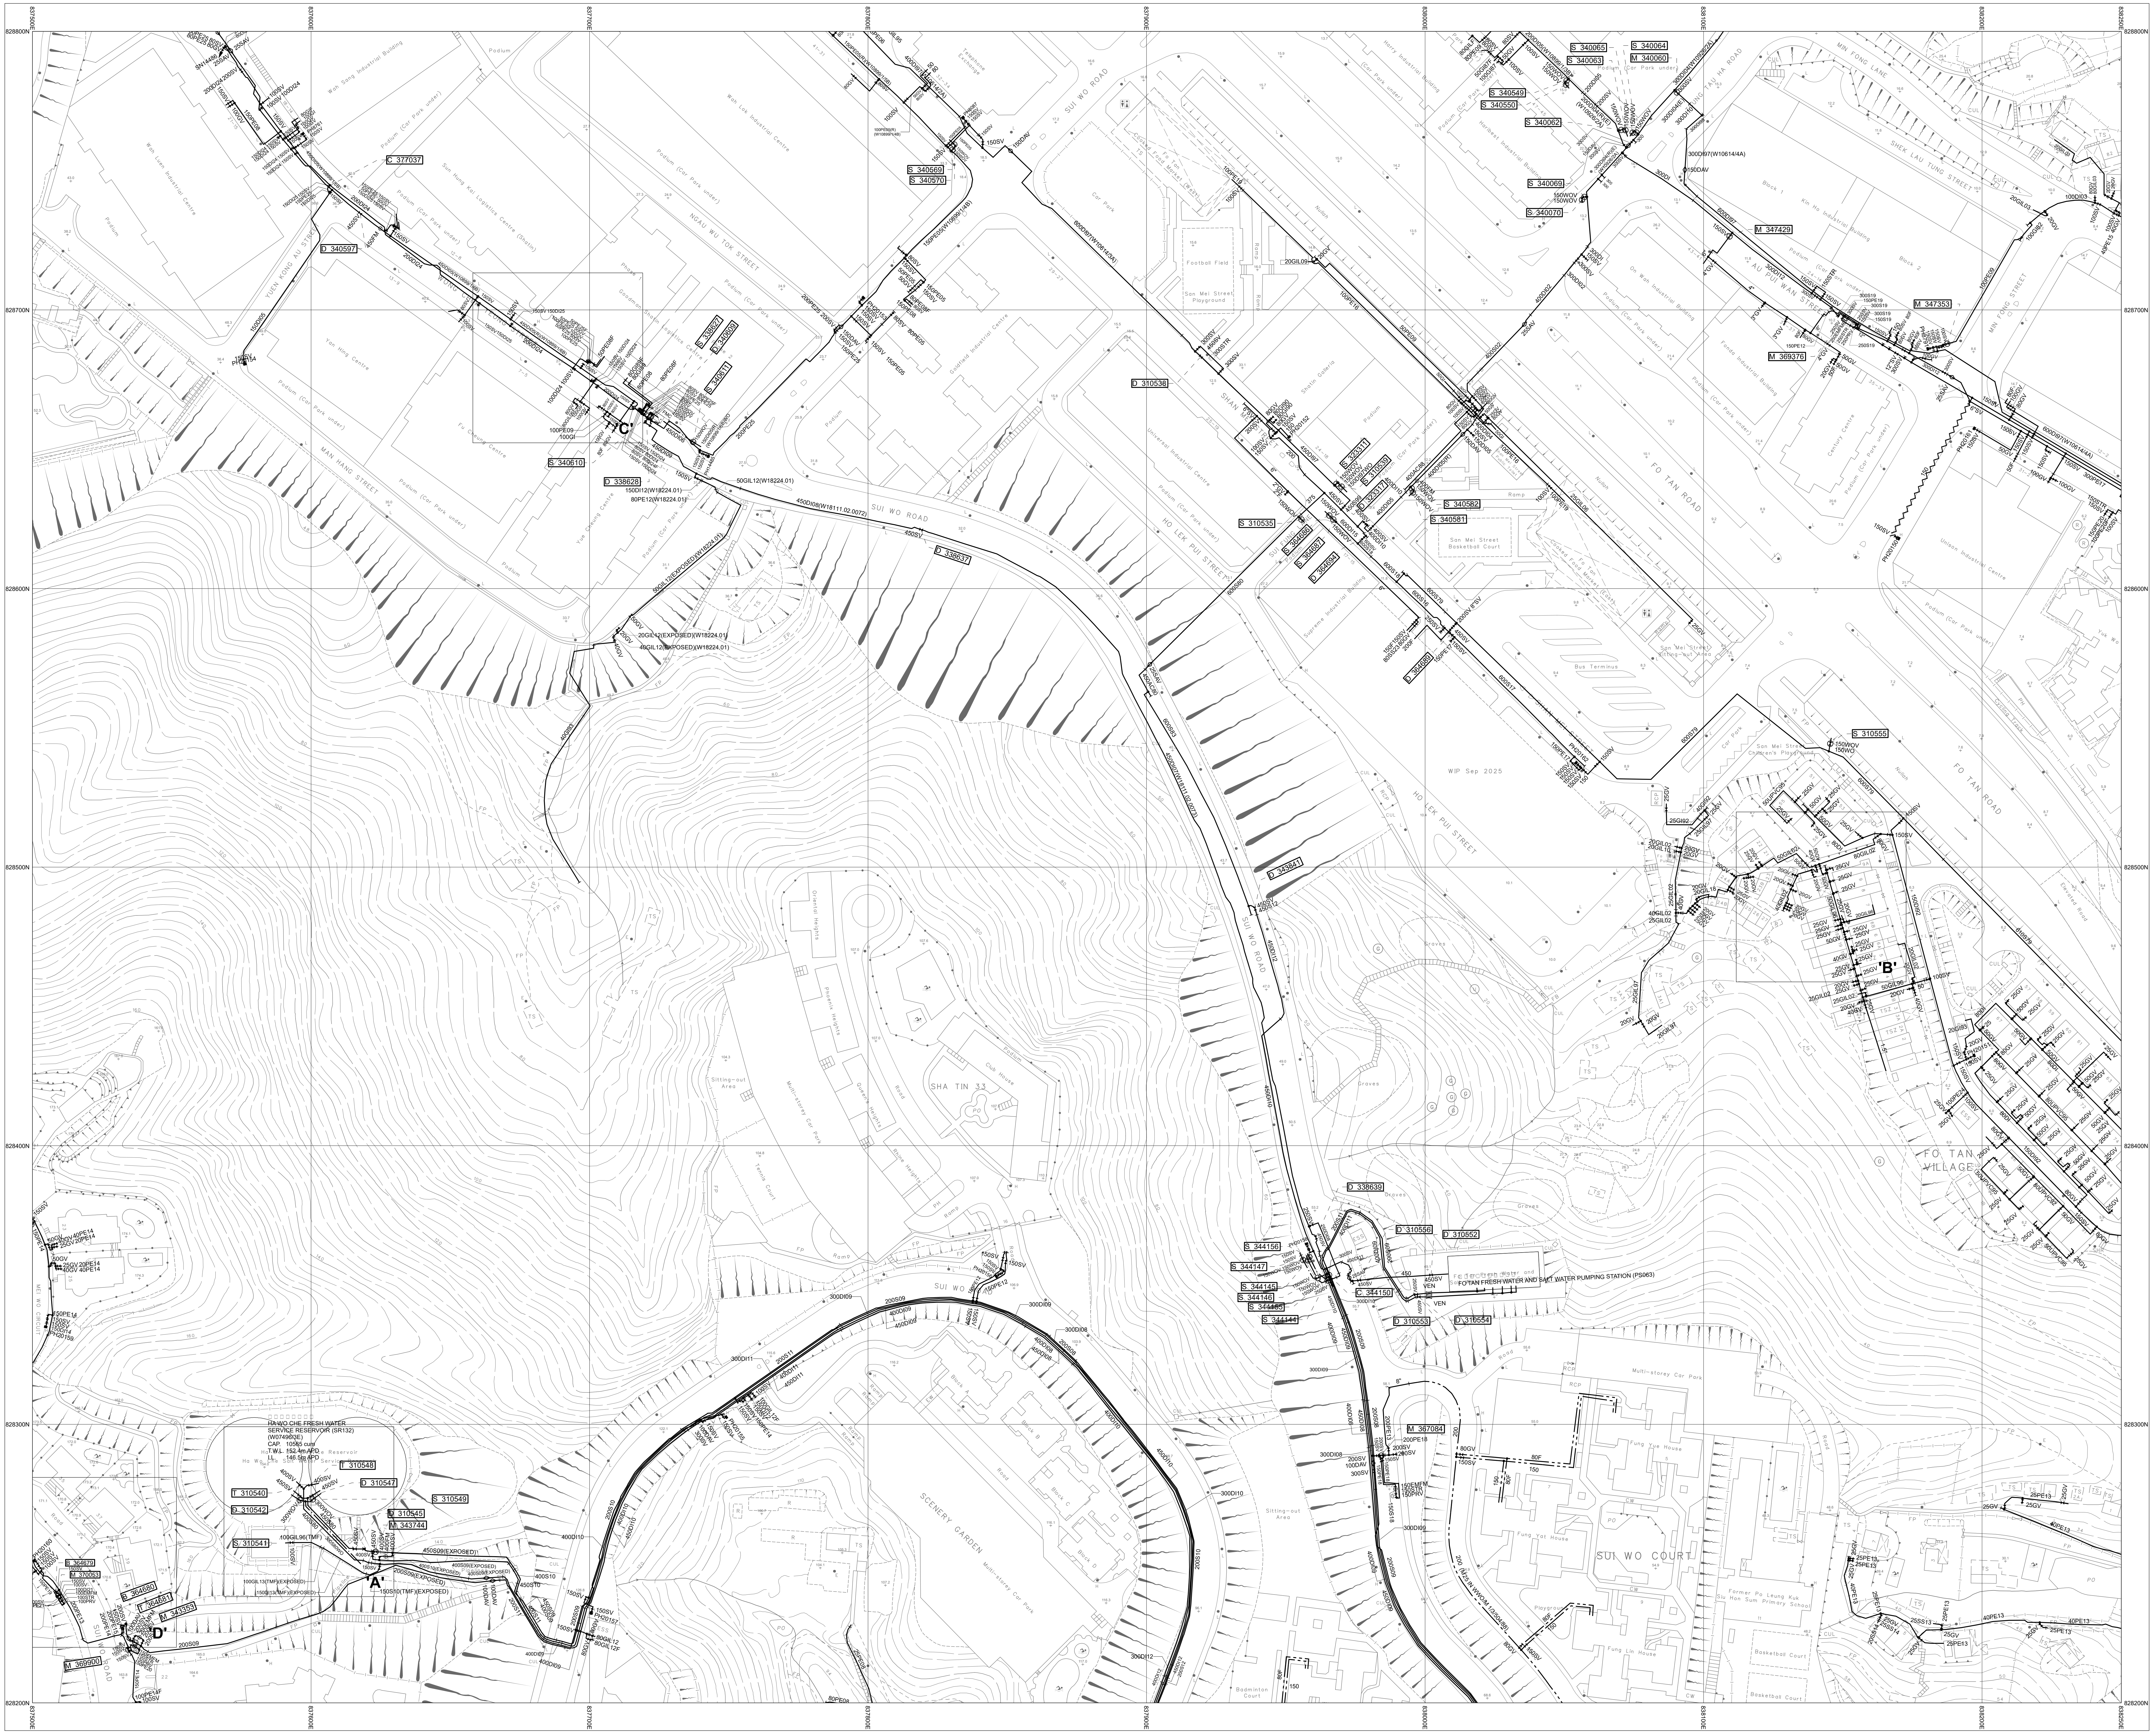

NOTES:

1. FOR MAINS RECORDS SIGN CONVENTIONS AND DESIGNATIONS SEE SKETCH NO.3988.
2. DIMENSIONS OF MAINS ARE IN MILLIMETRES UNLESS OTHERWISE SPECIFIED.
3. ALL LEVELS ARE IN METRES ABOVE PRINCIPAL DATUM.

THIS IS A COMPUTER PRINTOUT,
NO SIGNATURE IS REQUIRED.

COPYRIGHT RESERVED

DRAWING NO.

W67880/ 7-SE-6A

DATE REVISED : 03/06/2026

FRESH WATER MAINS RECORD PLAN

SUI WO ROAD, FO TAN

Basemap Date Updated On: 05/01/2026

SCALE 1:1 000

METRES 20 10 0 20 40 60 80 100 METRES

SIGNED C.S. CHIN
CE/MNE
DATE: 23/04/1999

Water Supplies Department
HONG KONG

© The Government of the Hong Kong SAR, Map reproduced with permission of the Director of Lands