INSET 'A'	INSET 'B'	INSET 'C'	INSET 'D'	INSET 'E'	INSET 'F'

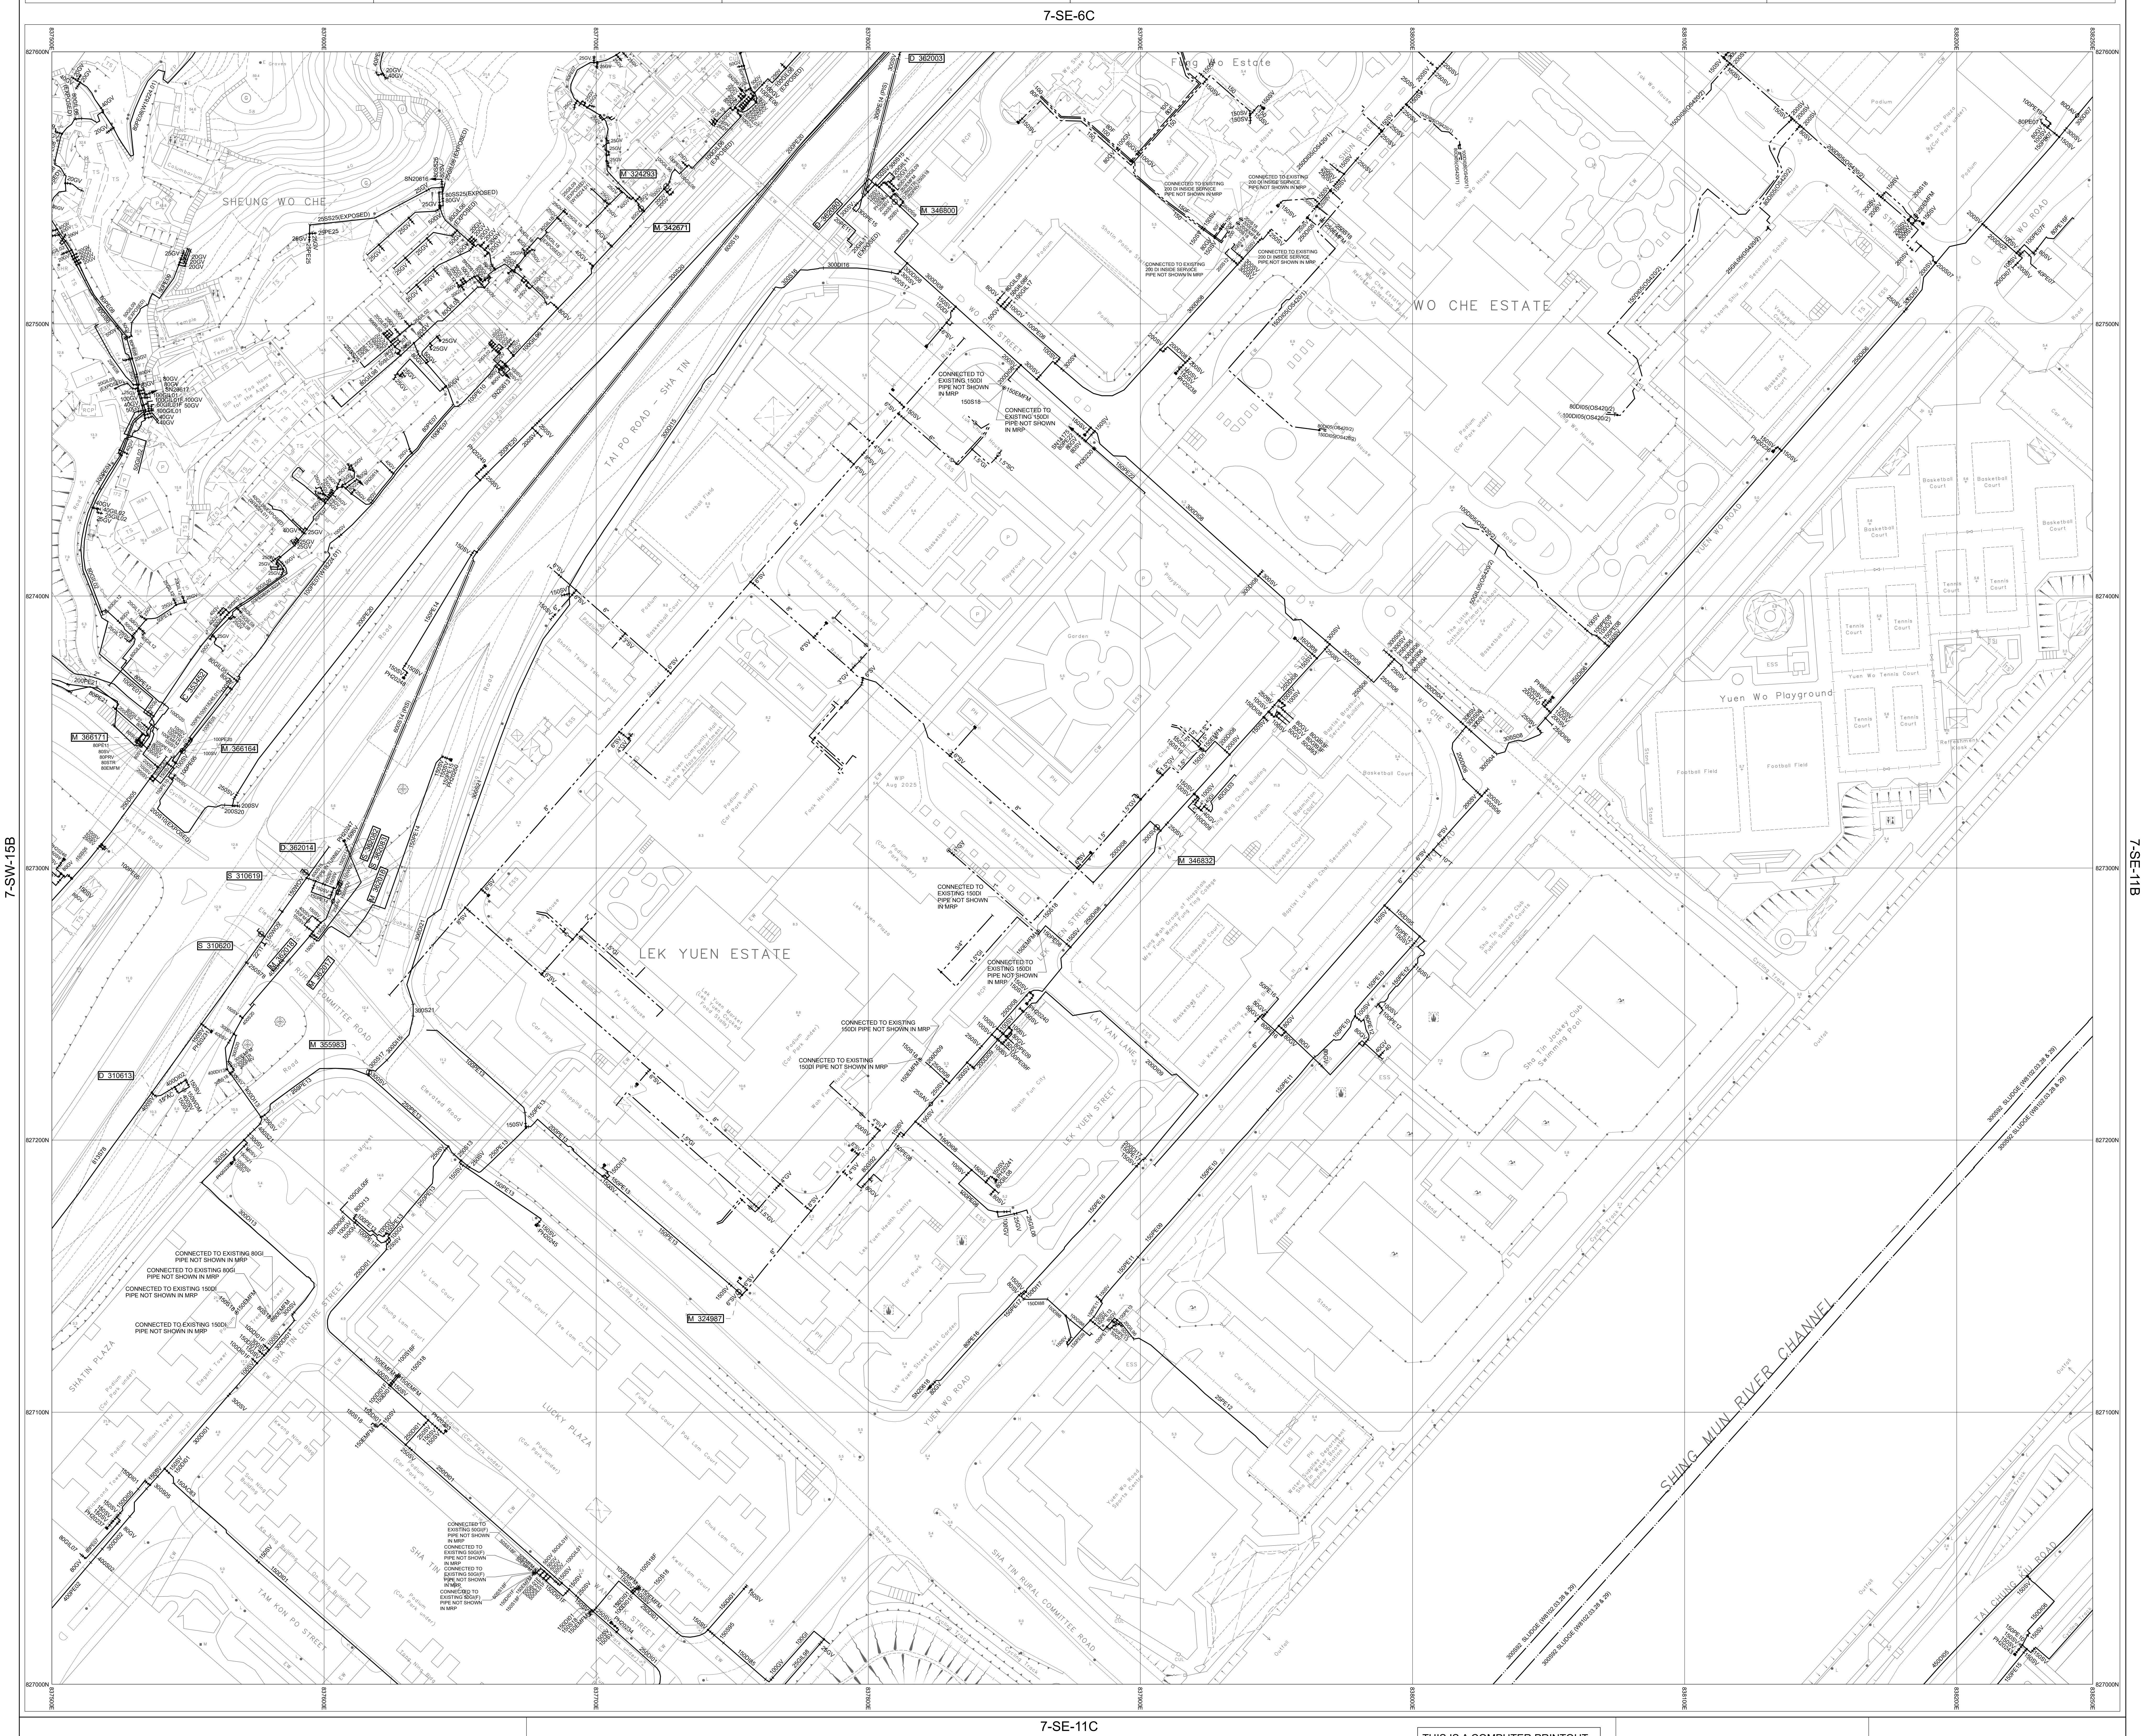
7-SE-6C
7-SW-15B
7-SE-11B
7-SE-11C
827600N
827500N
827400N
827300N
827200N
827100N
827000N
SHEUNG WO CHE
Fung Wo Estate
WO CHE ESTATE
TAI PO ROAD - SHA TIN
WO CHE STREET
LEK YUEN ESTATE
Yuen Wo Playground
Football Field
Basketball Court
Tennis Court
SHATIN PLAZA
LUCKY PLAZA
TAM KON PO STREET
YUEN WO ROAD
LEK YUEN STREET
SHA TIN RURAL COMMITTEE ROAD
SHING MUN RIVER CHANNEL
TAI CHUNG KIU ROAD
M_324253
M_342871
M_346800
D_362003
M_305171
M_366164
D_362014
B_310619
B_310620
M_355983
D_310613
M_346832
M_324987
CONNECTED TO EXISTING 150DI PIPE NOT SHOWN IN MRP
CONNECTED TO EXISTING 80GI PIPE NOT SHOWN IN MRP

NOTES:
1. FOR MAINS RECORDS SIGN CONVENTIONS AND DESIGNATIONS SEE SKETCH NO.3988.
2. DIMENSIONS OF MAINS ARE IN MILLIMETRES UNLESS OTHERWISE SPECIFIED.
3. ALL LEVELS ARE IN METRES ABOVE PRINCIPAL DATUM.

Basemap Data Updated On: 05/01/2026

SCALE 1:1 000

METRES 20 10 0 20 40 60 80 100 METRES

THIS IS A COMPUTER PRINTOUT,
NO SIGNATURE IS REQUIRED.

FRESH WATER MAINS RECORD PLAN

LEK YUEN ESTATE, SHA TIN

COPYRIGHT RESERVED

DATE REVISED : 05/10/2026

DRAWING NO.

W67880/ 7-SE-11A

SIGNED

C.S. CHIN
CE/MNE

DATE: 23/04/1999

Water Supplies Department
HONG KONG

© The Government of the Hong Kong SAR, Map reproduced with permission of the Director of Lands