INSET 'A'

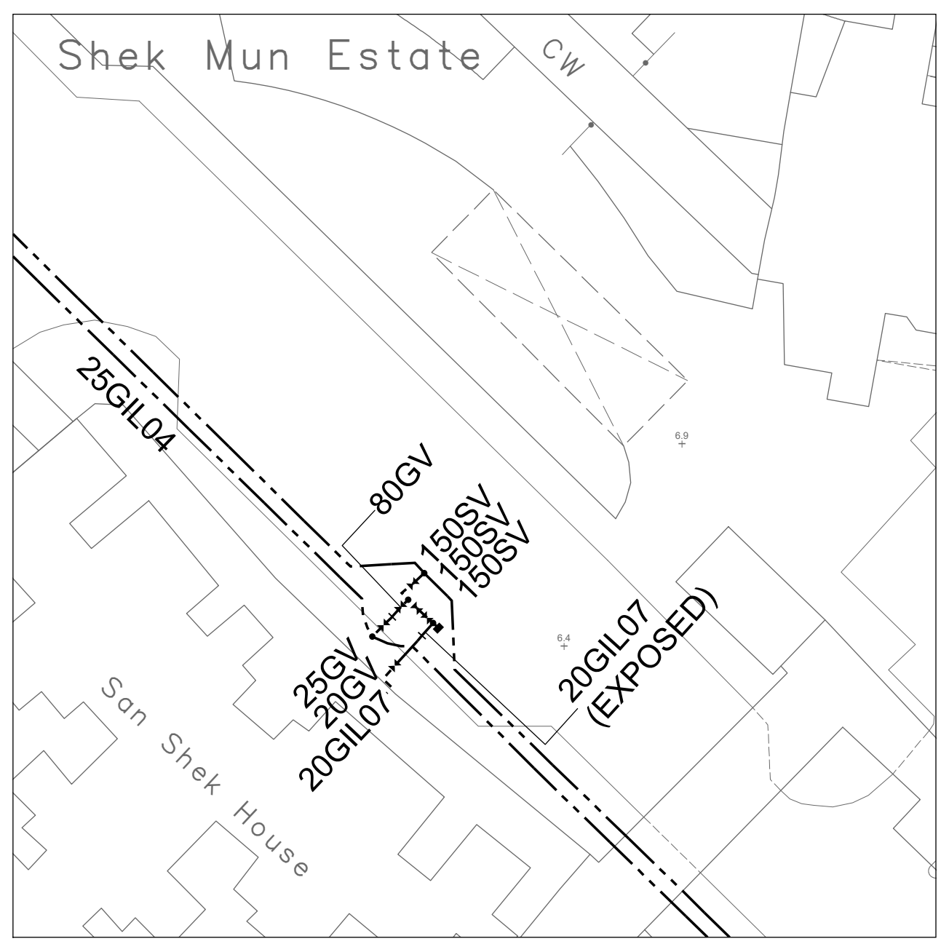

Scale 1:500

INSET 'B'

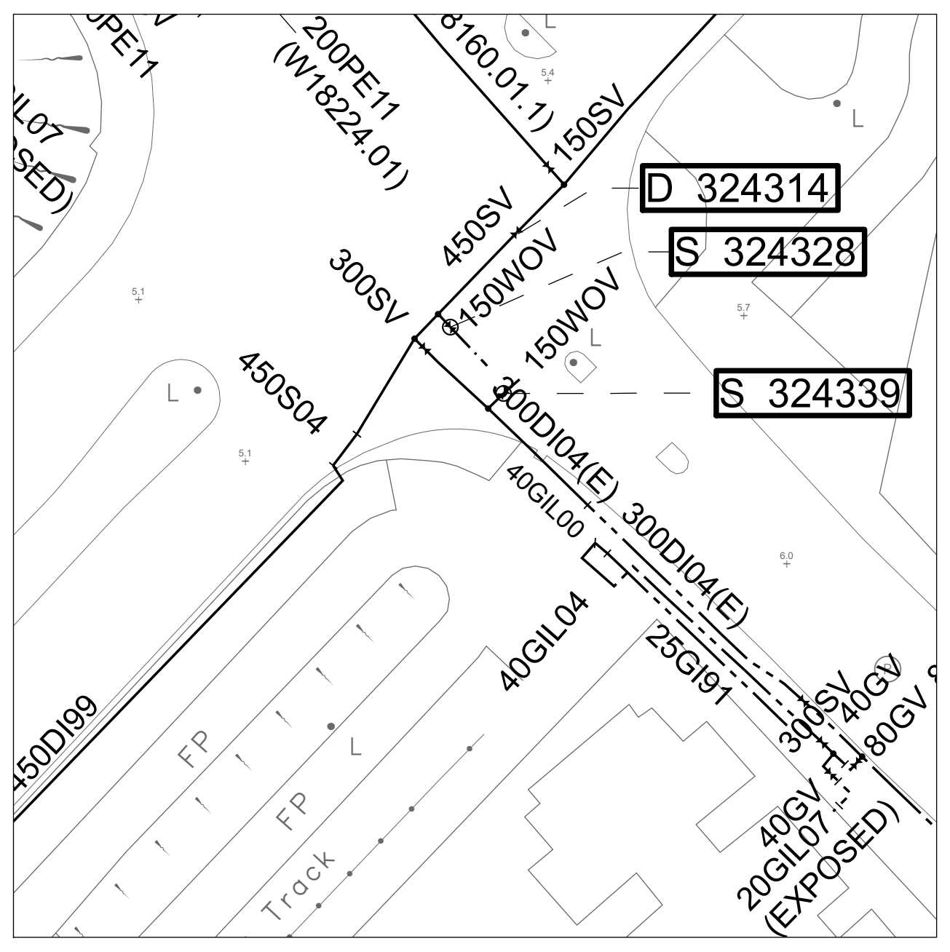

Scale 1:500

INSET 'C'

INSET 'D'

INSET 'E'

INSET 'F'

7-SE-7C

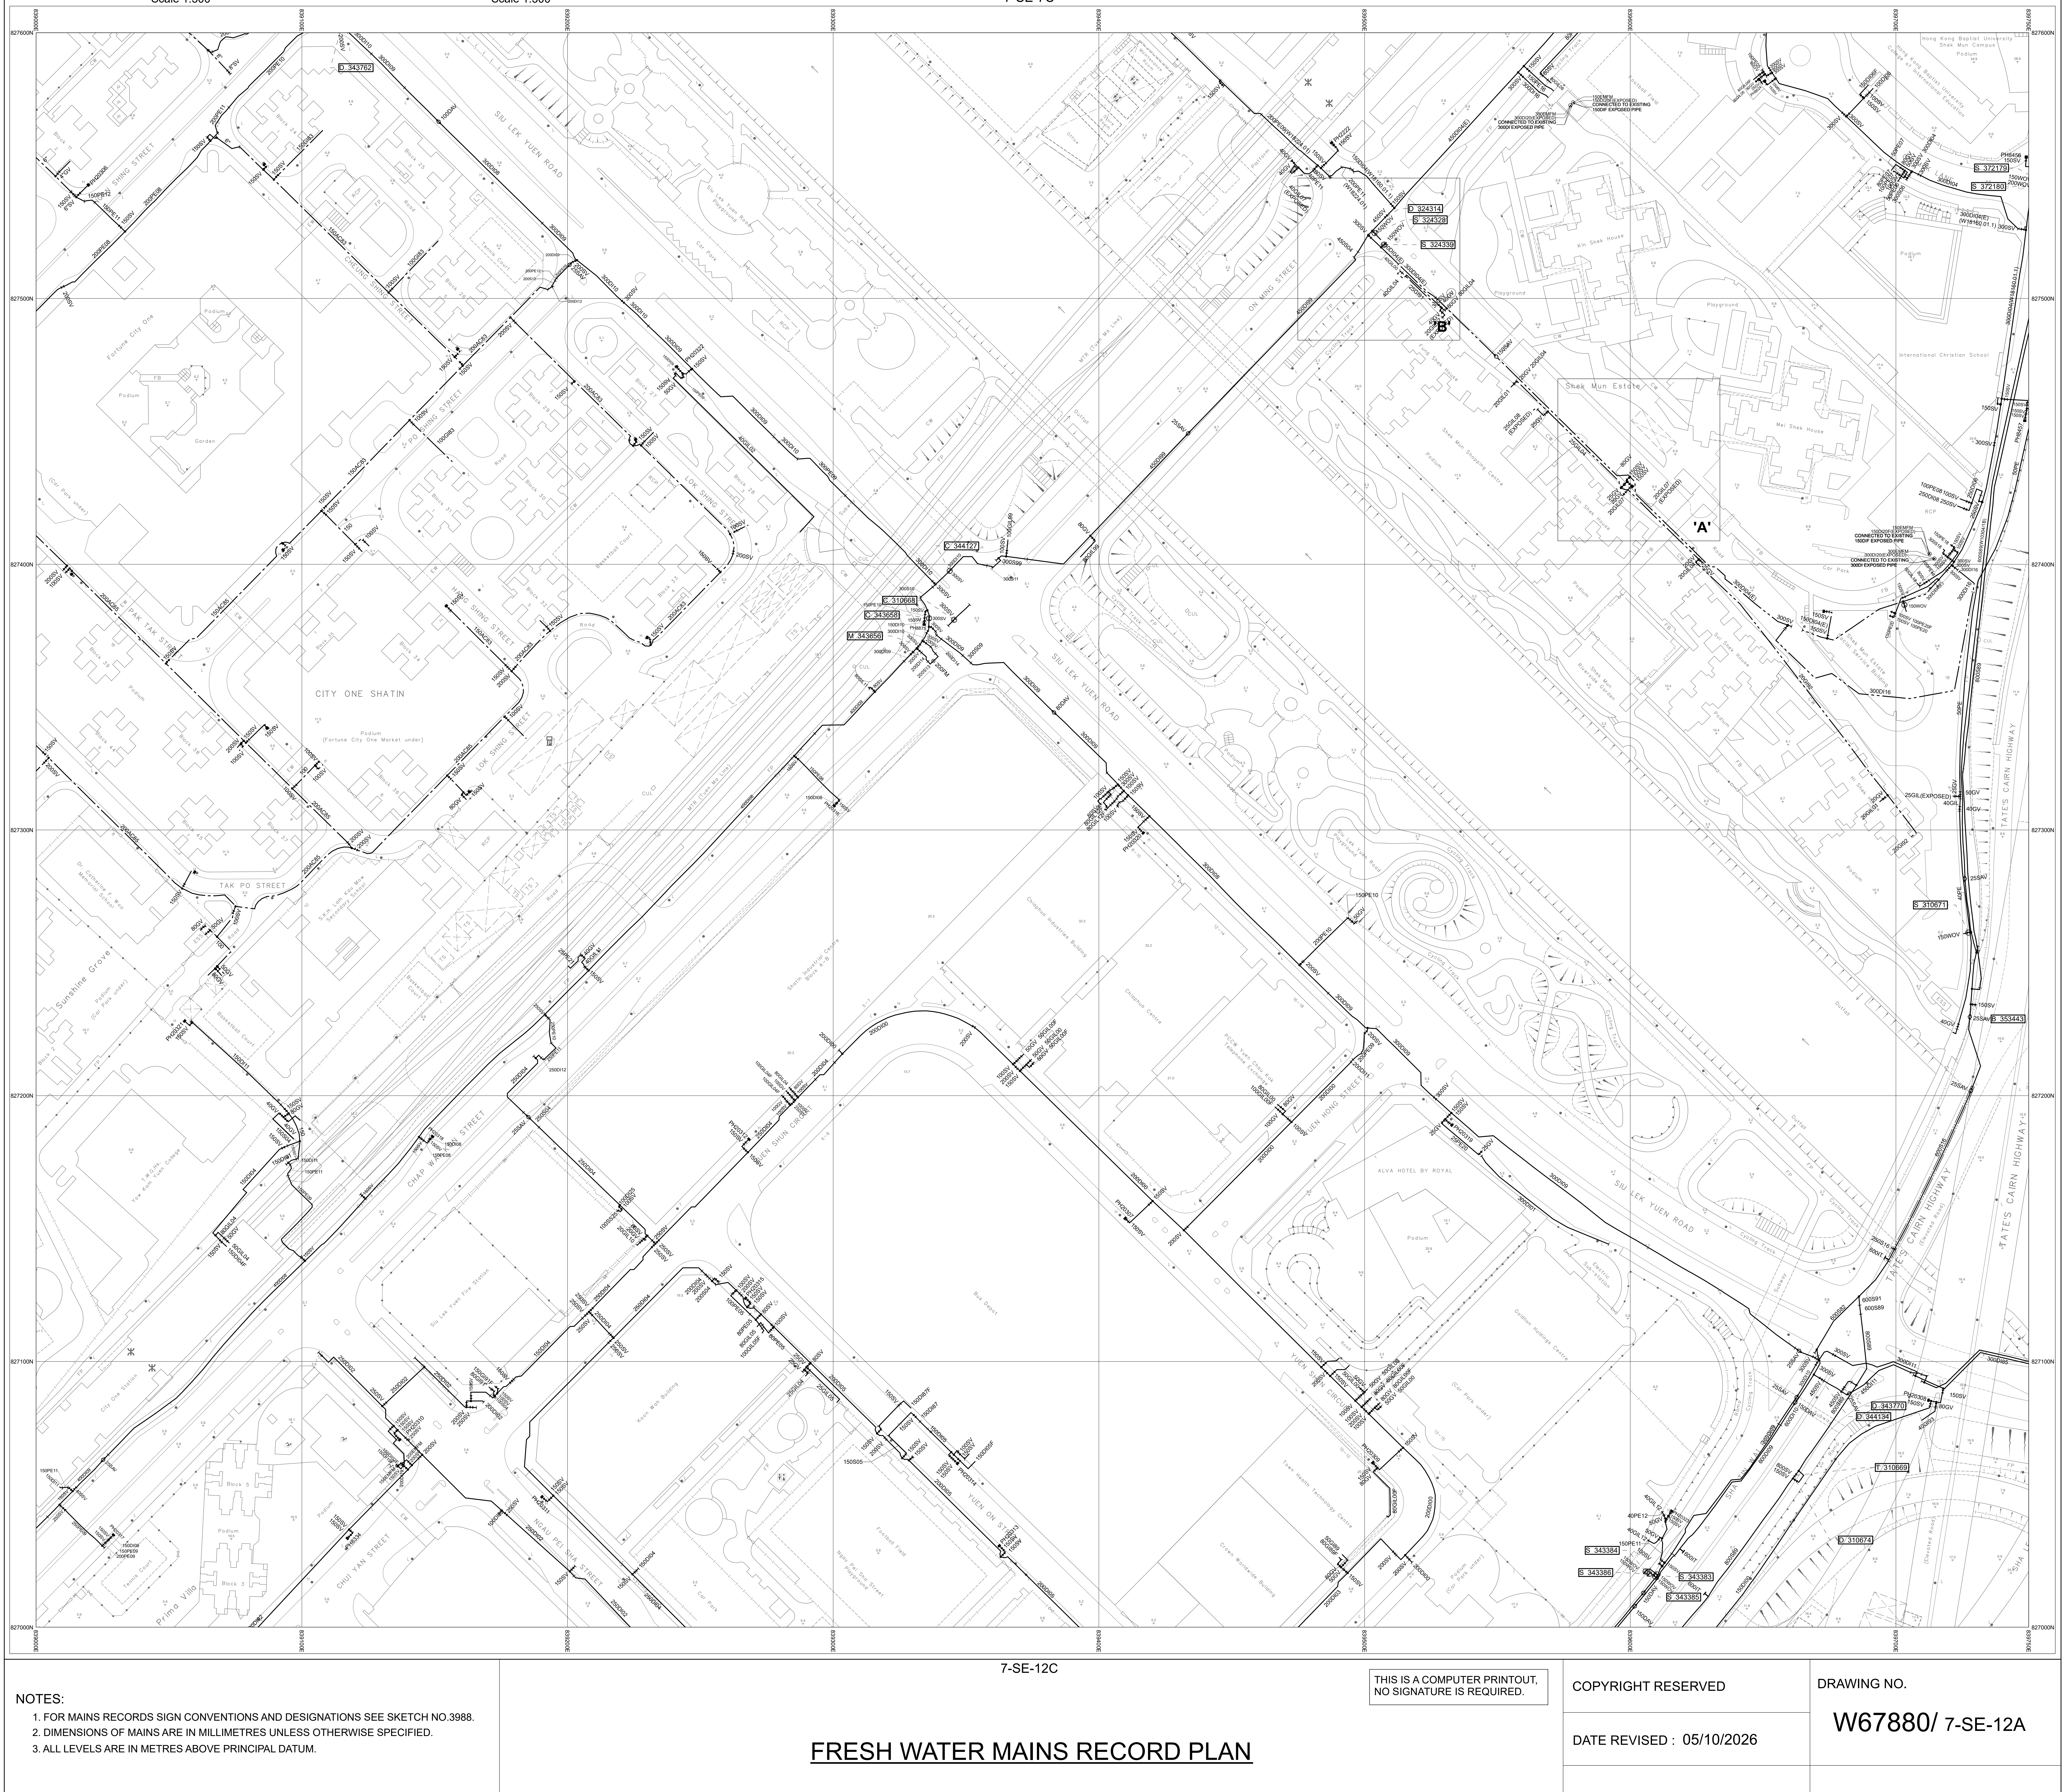

7-SE-12C

NOTES:
1. FOR MAINS RECORDS SIGN CONVENTIONS AND DESIGNATIONS SEE SKETCH NO.3988.
2. DIMENSIONS OF MAINS ARE IN MILLIMETRES UNLESS OTHERWISE SPECIFIED.
3. ALL LEVELS ARE IN METRES ABOVE PRINCIPAL DATUM.

Basemap Data Updated On: 05/01/2026

SCALE 1:1 000

METRES 20 10 0 20 40 60 80 100 METRES

FRESH WATER MAINS RECORD PLAN

CITY ONE SHATIN, SHA TIN

THIS IS A COMPUTER PRINTOUT, NO SIGNATURE IS REQUIRED.

COPYRIGHT RESERVED

DATE REVISED : 05/10/2026

SIGNED C.S. CHIN CE/MNE
DATE: 23/04/1999

DRAWING NO.
W67880/ 7-SE-12A

Water Supplies Department
HONG KONG

© The Government of the Hong Kong SAR, Map reproduced with permission of the Director of Lands