INSET 'A'

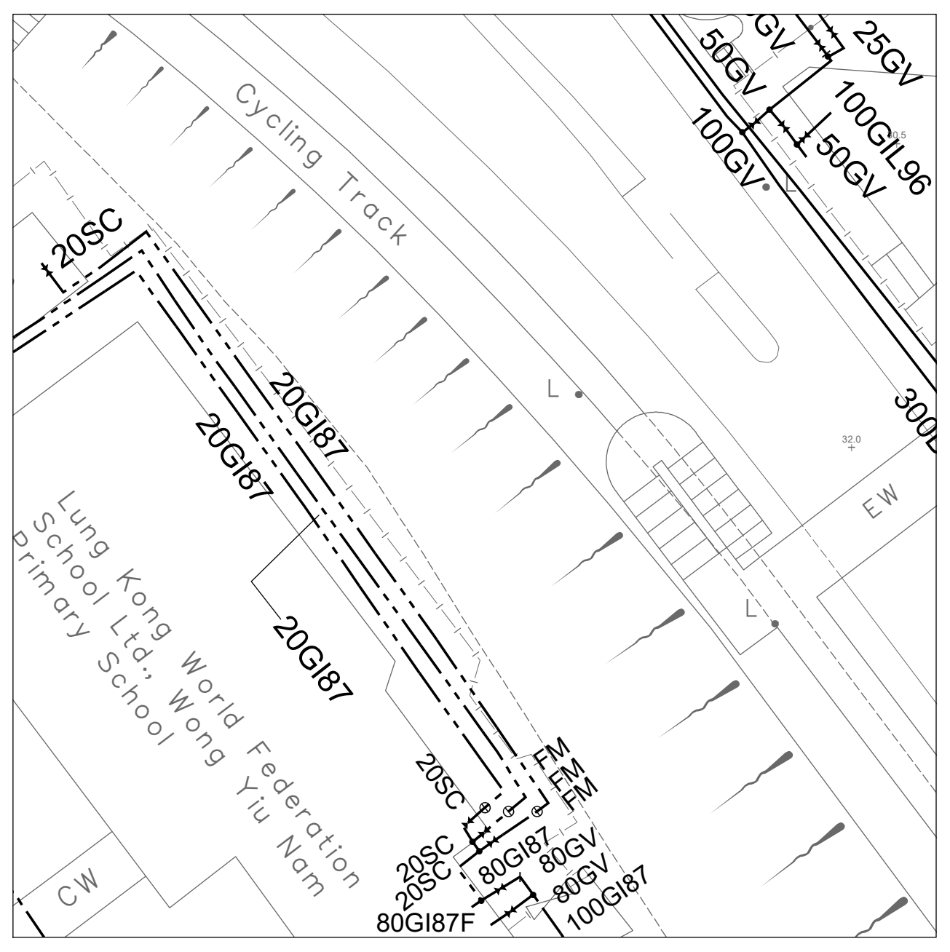
Cycling Track
25GV
50GV
100GIL96
100GV
50GV
20SC
20GI87
20GI87
20GI87
300
EW
Lung Kong World Federation School Ltd. Wong Yiu Nam Primary School
20SC
FM
80GI87
80GV
80GV
100GI87
80GI87F
CW

Scale 1:500

INSET 'B'

INSET 'C'

INSET 'D'

INSET 'E'

INSET 'F'

7-SE-7D

7-SE-12A

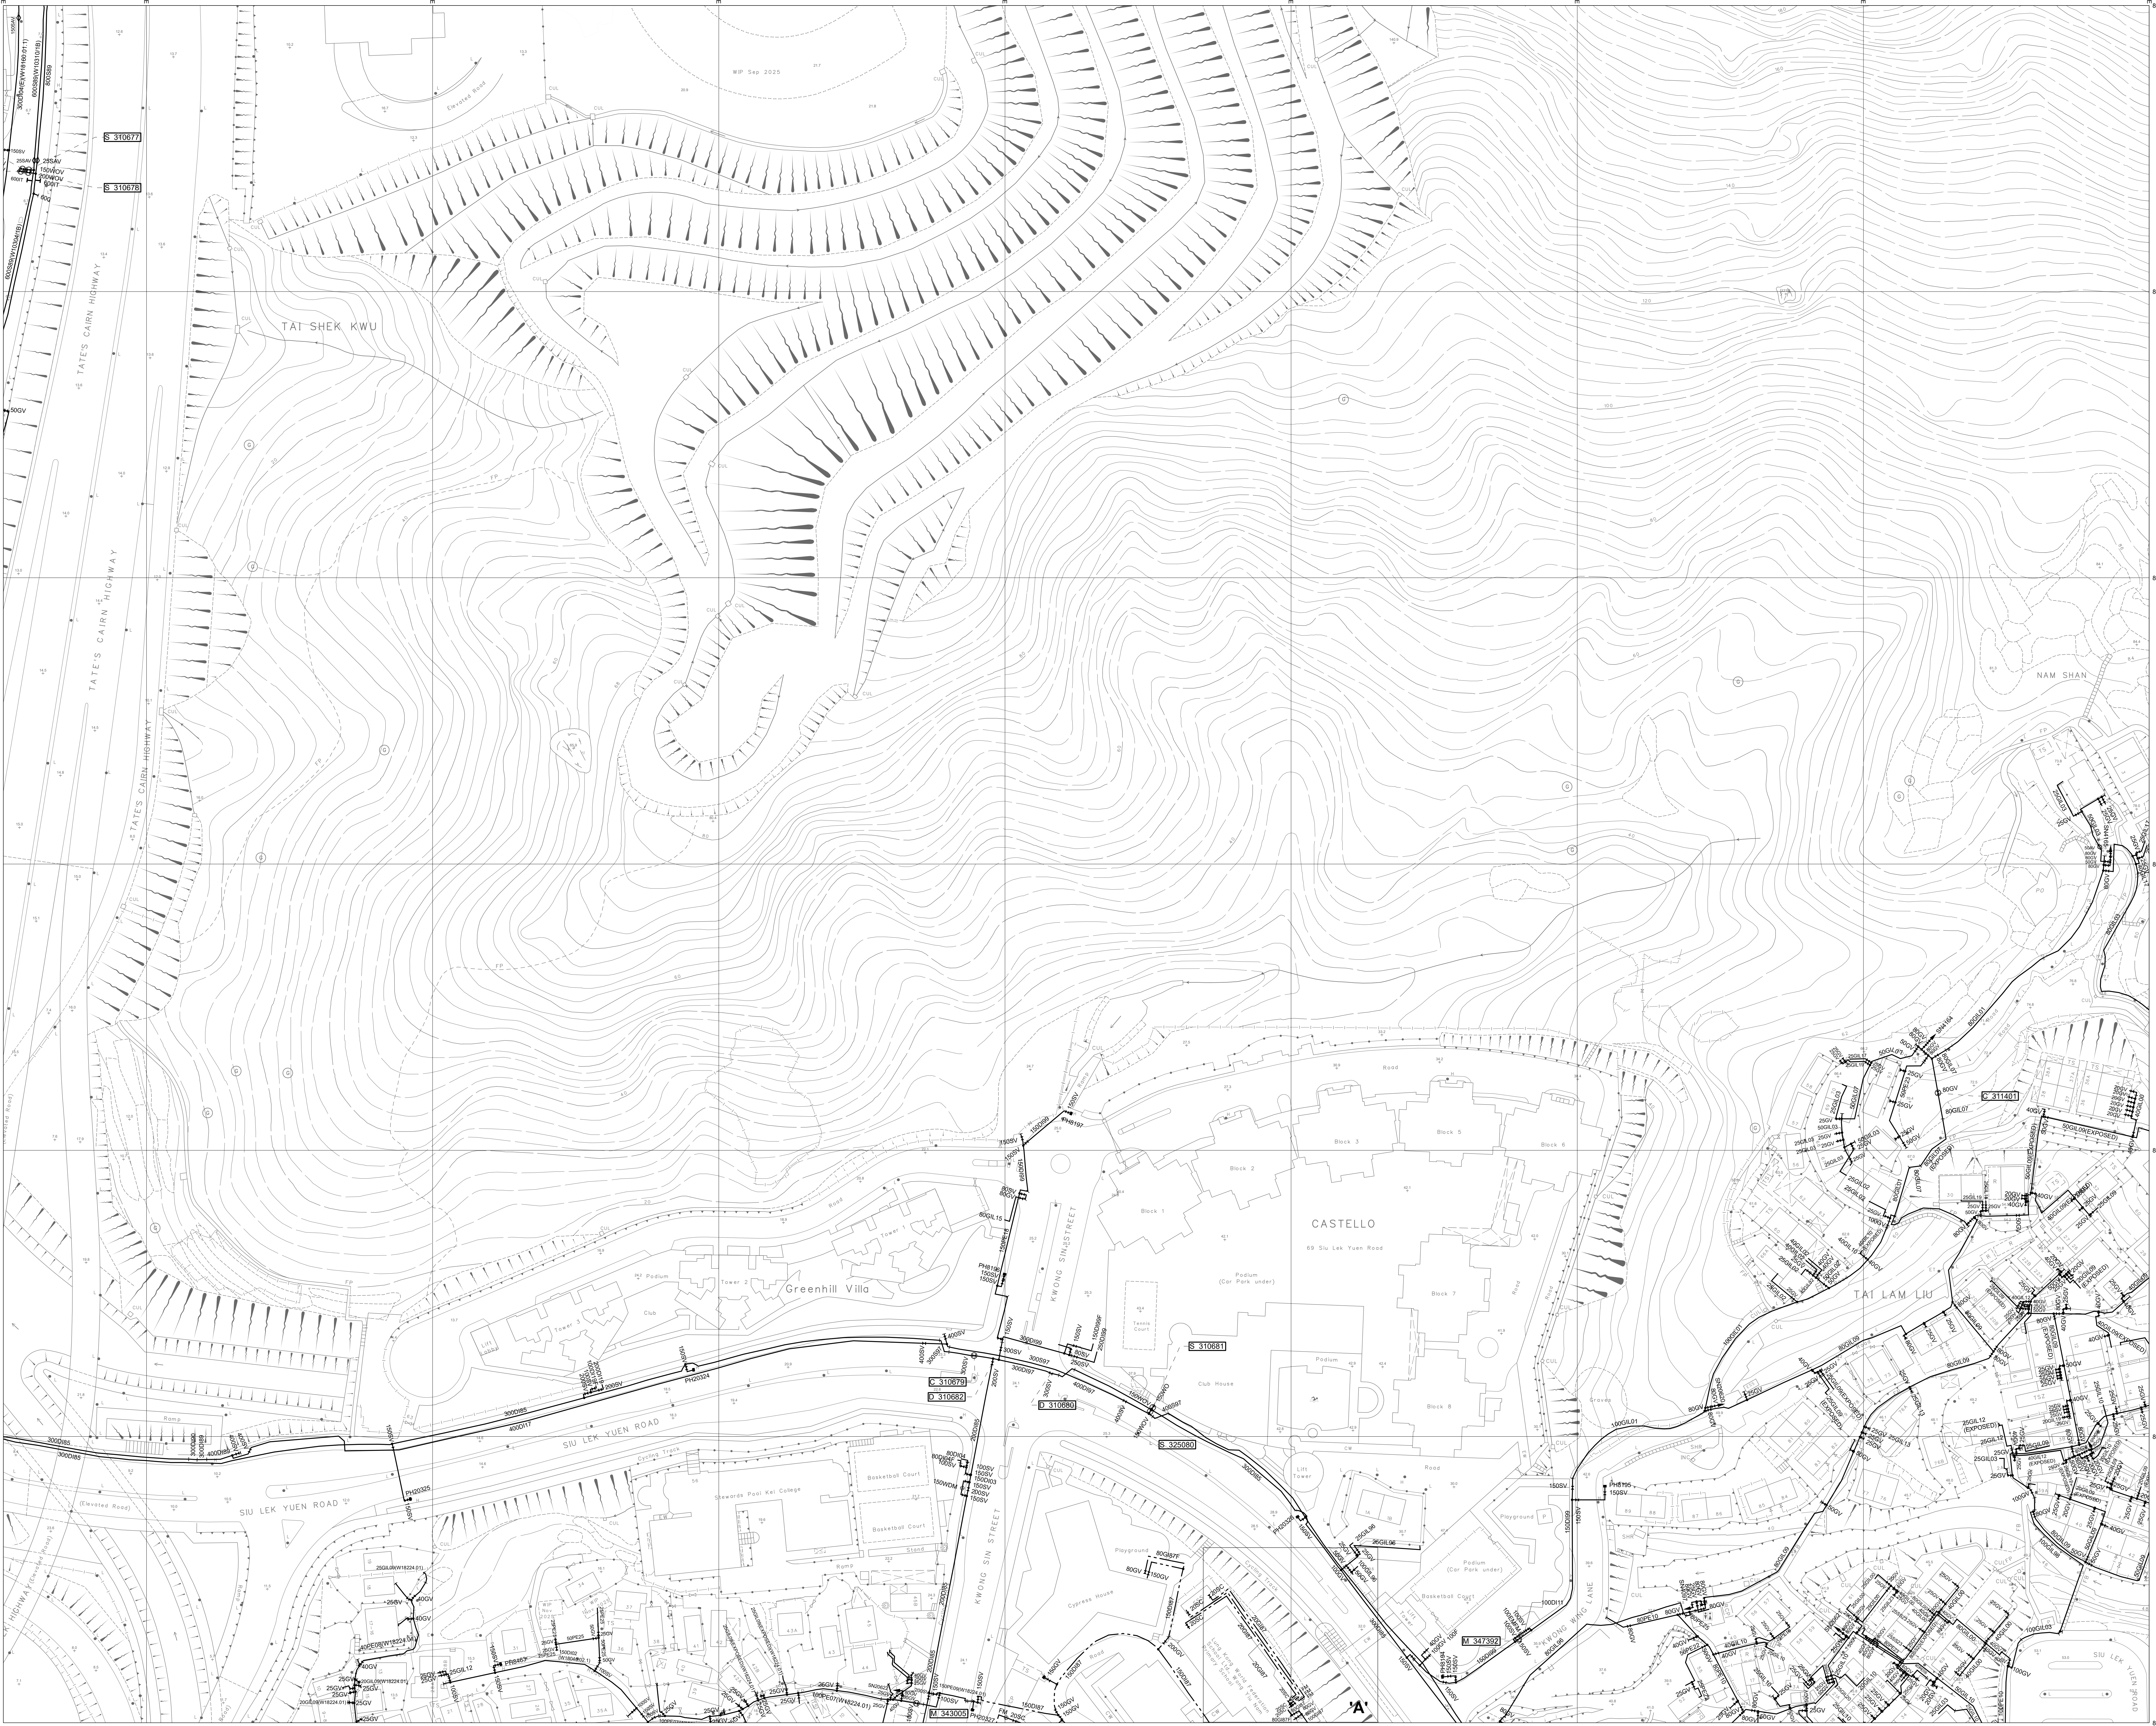
S 310677
S 310678
TAI SHEK KWU
TATE'S CAIRN HIGHWAY
TATE'S CAIRN HIGHWAY
TATE'S CAIRN HIGHWAY
NAM SHAN
CASTELLO
Greenhill Villa
KWONG SIN STREET
KWONG SIN STREET
SIU LEK YUEN ROAD
SIU LEK YUEN ROAD
TAI LAM LIU
S 310681
S 310679
D 310682
D 310680
S 325080
S 311461
M 347392
M 343003
'A'
827600N
827500N
827400N
827300N
827200N
827100N
827000N

7-SE-13A

7-SE-12D

NOTES:

1. FOR MAINS RECORDS SIGN CONVENTIONS AND DESIGNATIONS SEE SKETCH NO.3988.
2. DIMENSIONS OF MAINS ARE IN MILLIMETRES UNLESS OTHERWISE SPECIFIED.
3. ALL LEVELS ARE IN METRES ABOVE PRINCIPAL DATUM.

Basemap Date Updated On: 05/01/2026

SCALE 1:1 000

METRES 20 10 0 20 40 60 80 100 METRES

FRESH WATER MAINS RECORD PLAN

SIU LEK YUEN, TAI LAM LIU

THIS IS A COMPUTER PRINTOUT,
NO SIGNATURE IS REQUIRED.

COPYRIGHT RESERVED

DATE REVISED : 05/10/2026

DRAWING NO.

W67880/ 7-SE-12B

SIGNED

C.S. CHIN
CE/MNE
DATE: 23/04/1999

Water Supplies Department
HONG KONG

© The Government of the Hong Kong SAR, Map reproduced with permission of the Director of Lands