INSET 'A'	INSET 'B'	INSET 'C'	INSET 'D'	INSET 'E'	INSET 'F'

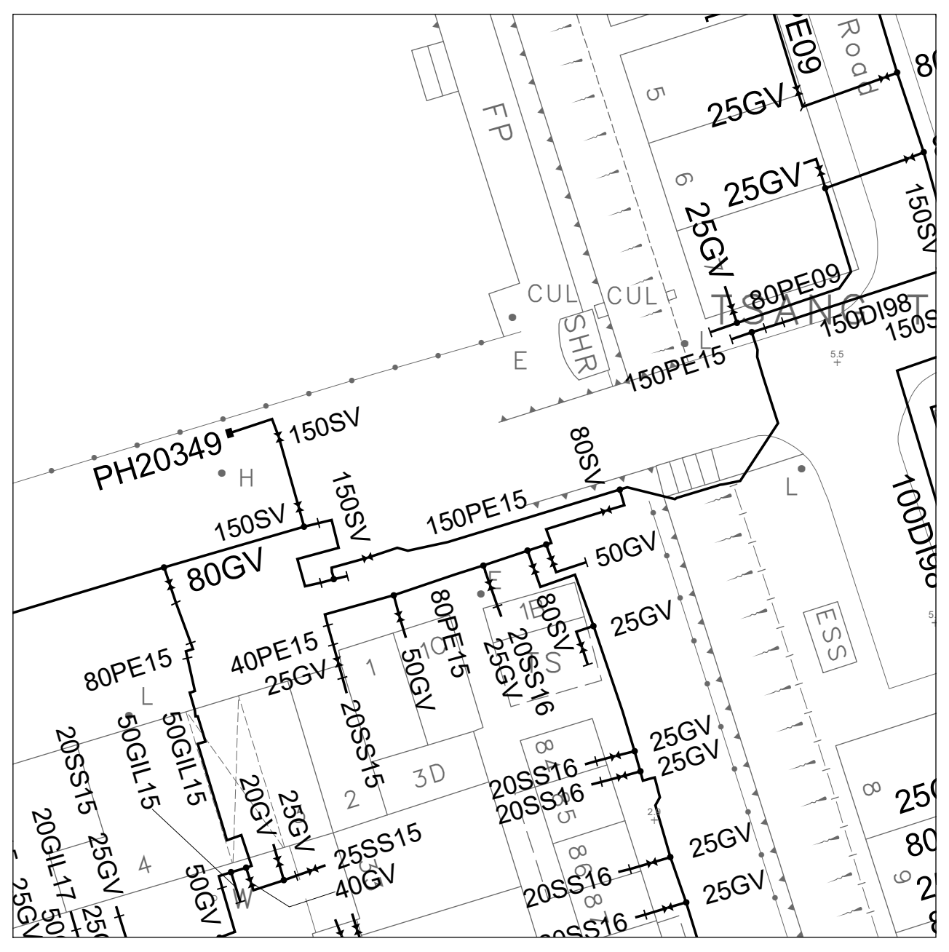
25GV
150SV
PH20349
80GV
150PE15
80PE15
40PE15
25GV
50GV
25SS15
20SS16
100DI

Scale 1:500

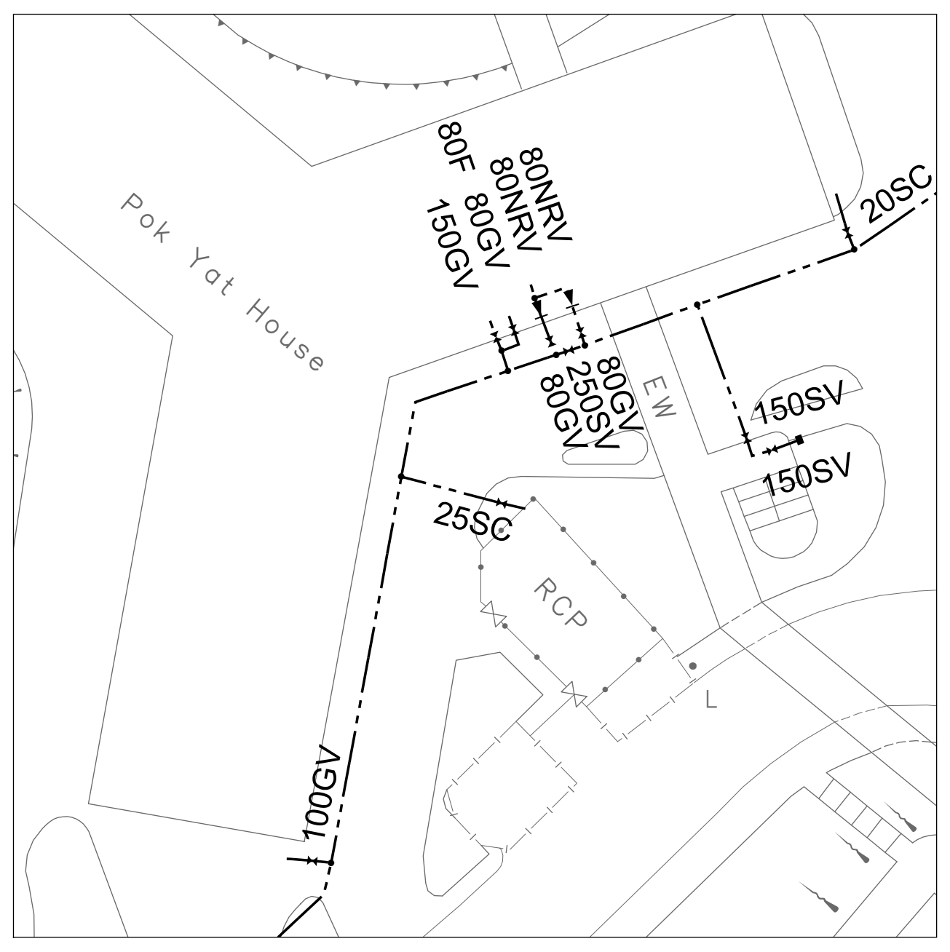
Pok Yat House
80NRV
80NRV
80GV
80F
150GV
20SC
150SV
150SV
25SC
RCP
100GV

Scale 1:500

7-SE-11C

7-SW-20B

7-SE-16B

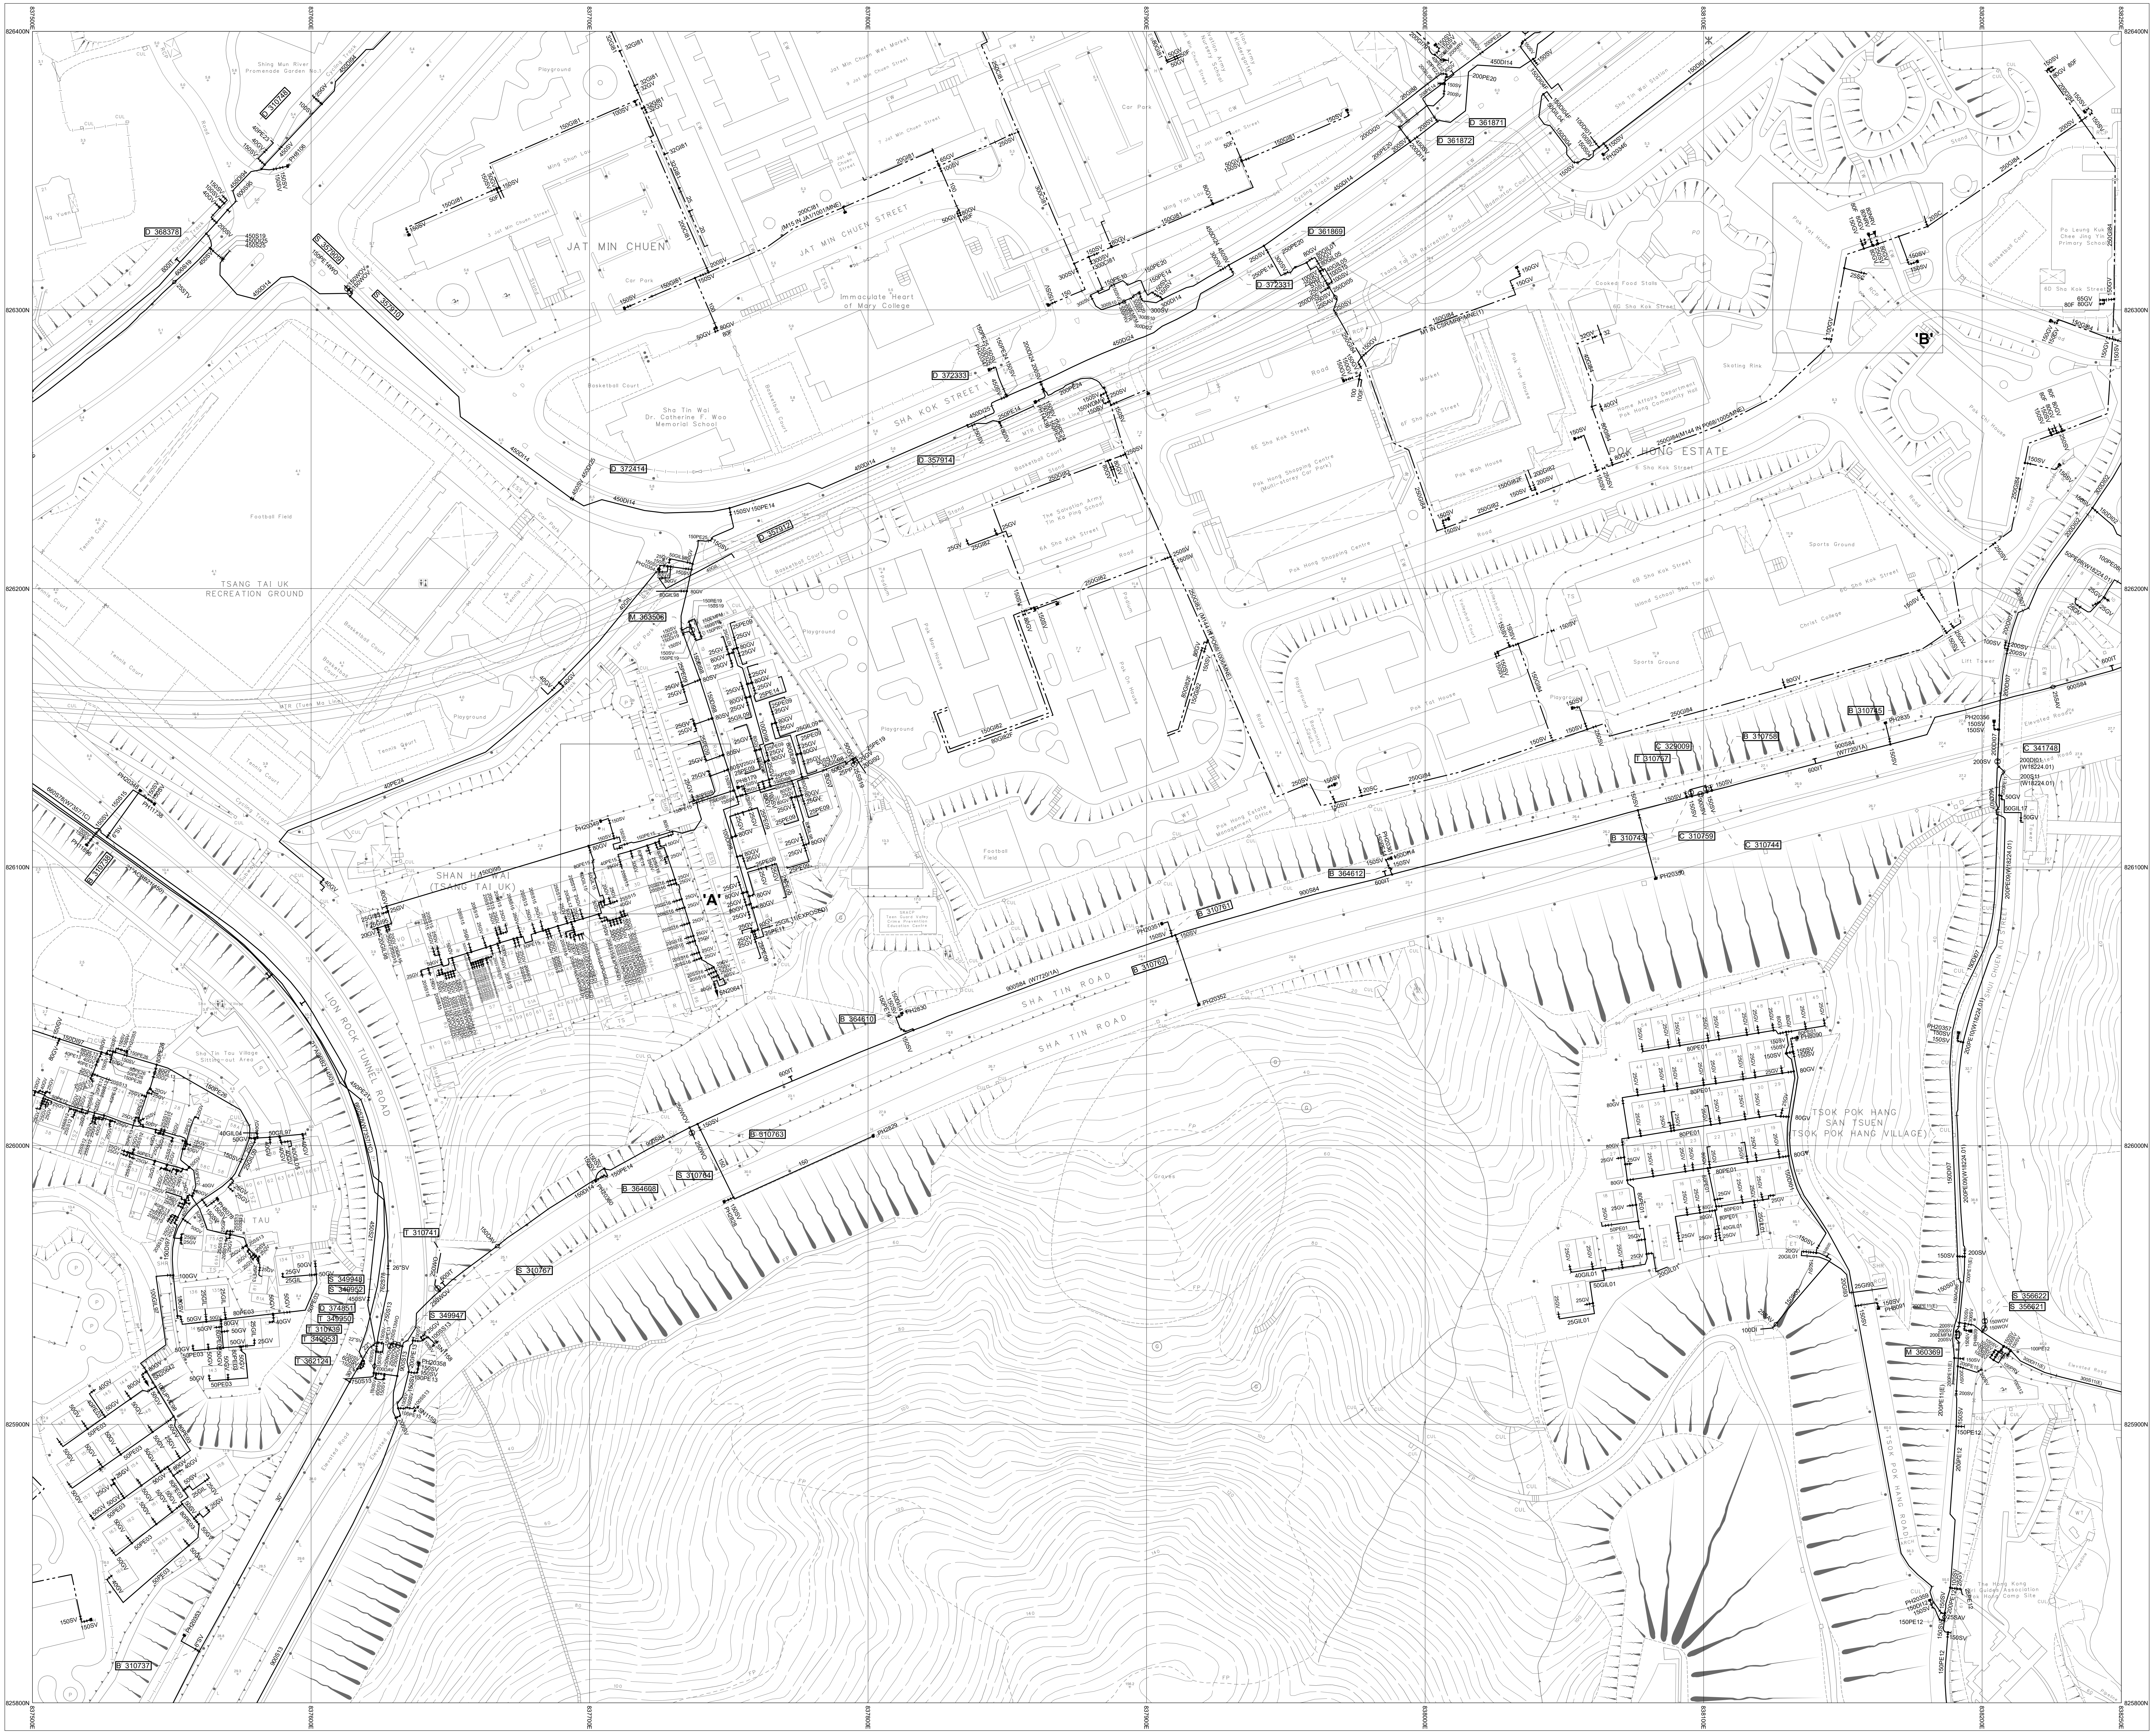
JAT MIN CHUEN
JAT MIN CHUEN STREET
Immaculate Heart of Mary College
SHA KOK STREET
POK HONG ESTATE
TSANG TAI UK RECREATION GROUND
SHAN HA WAI (TSANG TAI UK)
'A'
'B'
LION ROCK TUNNEL ROAD
SHA TIN ROAD
SHA TIN ROAD
TSOK POK HANG SAN TSUEN (TSOK POK HANG VILLAGE)
Pok Hong Shopping Centre
Football Field
Sports Ground

7-SE-16C

NOTES:

1. FOR MAINS RECORDS SIGN CONVENTIONS AND DESIGNATIONS SEE SKETCH NO.3988.
2. DIMENSIONS OF MAINS ARE IN MILLIMETRES UNLESS OTHERWISE SPECIFIED.
3. ALL LEVELS ARE IN METRES ABOVE PRINCIPAL DATUM.

Basemap Data Updated On: 05/01/2026

SCALE 1:1 000

METRES 20 10 0 20 40 60 80 100 METRES

THIS IS A COMPUTER PRINTOUT,
NO SIGNATURE IS REQUIRED.

FRESH WATER MAINS RECORD PLAN

SHA TIN ROAD, POK HONG ESTATE

COPYRIGHT RESERVED

DATE REVISED : 05/10/2026

DRAWING NO.

W67880/ 7-SE-16A

SIGNED
C.S. CHIN
CE/MNE
DATE: 23/04/1999

Water Supplies Department
HONG KONG

© The Government of the Hong Kong SAR, Map reproduced with permission of the Director of Lands