INSET 'A'

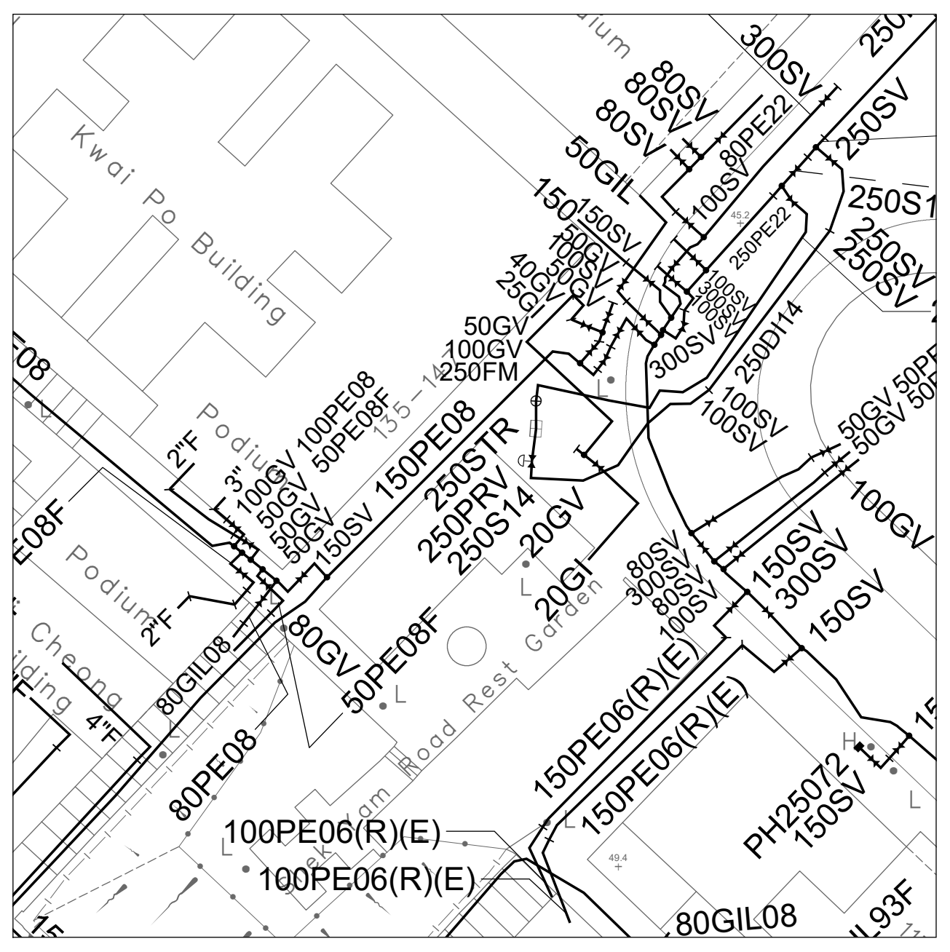

Scale 1:500

INSET 'B'

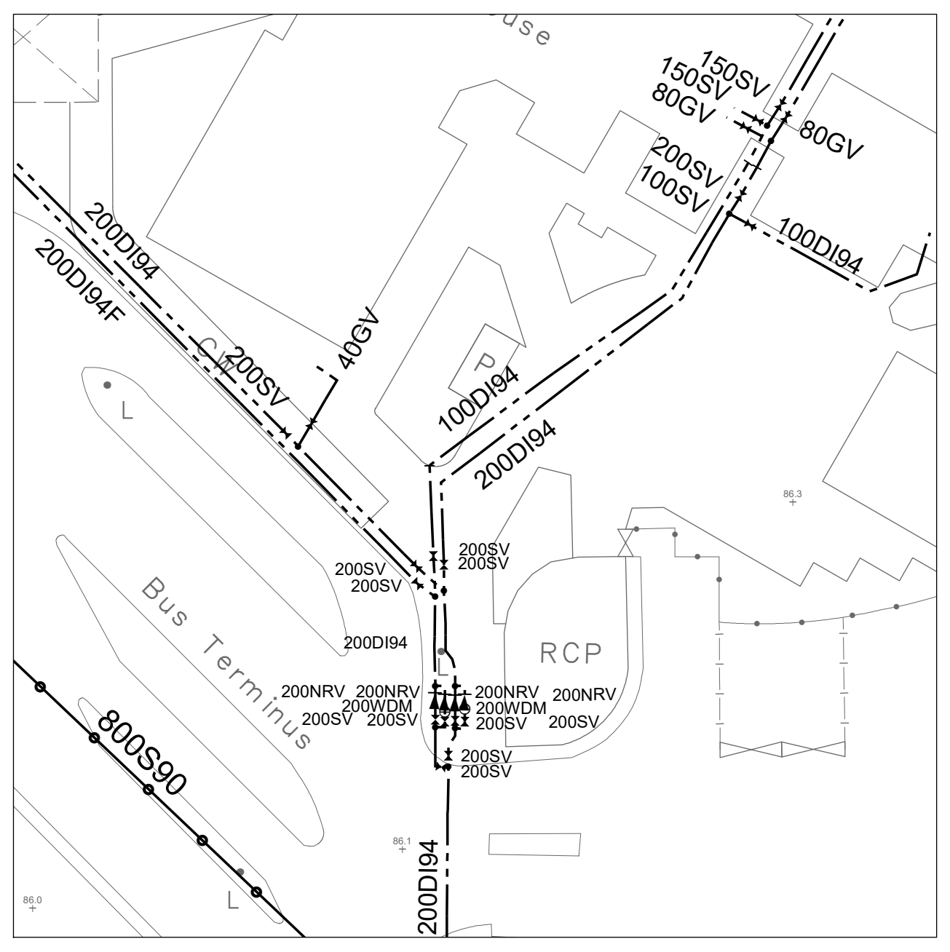

Scale 1:500

INSET 'C'

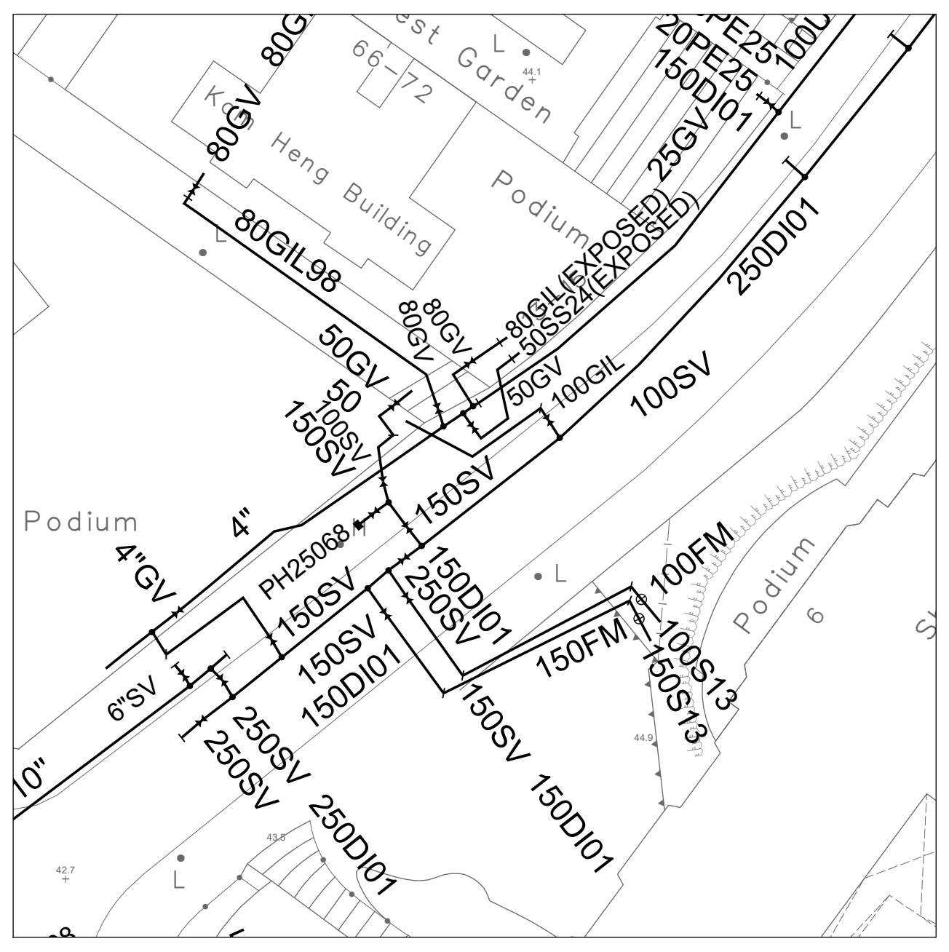

Scale 1:500

INSET 'D'

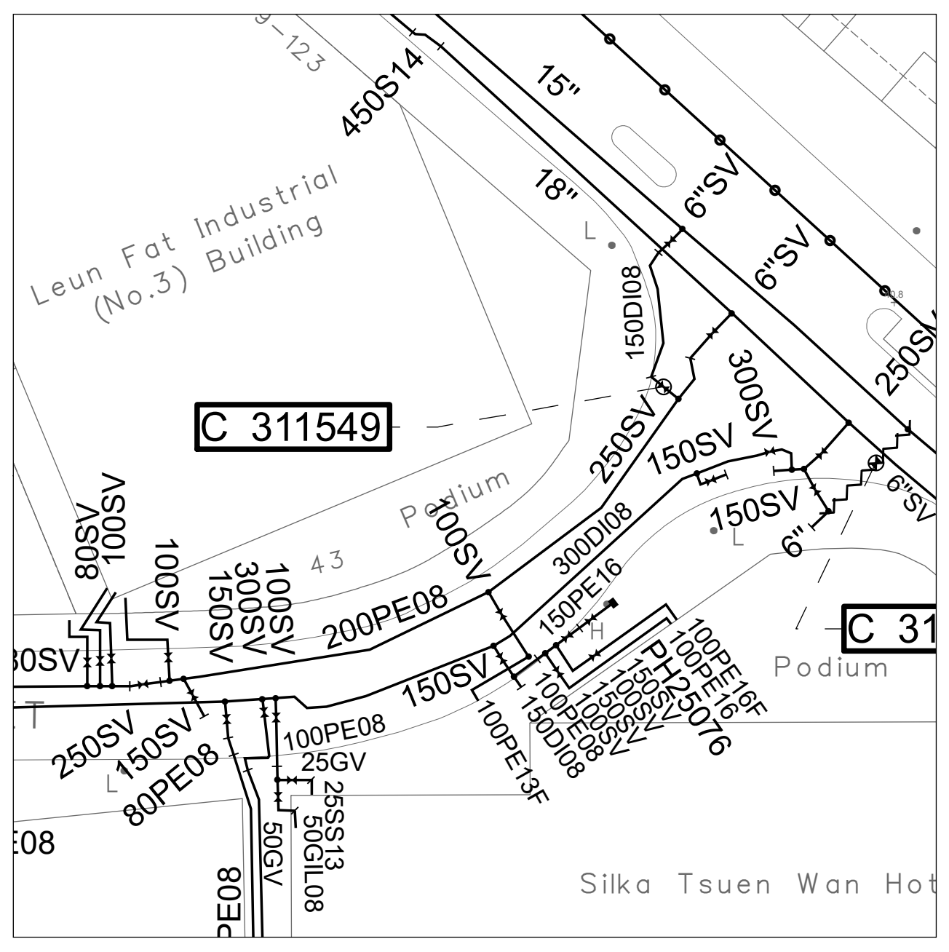

Scale 1:500

INSET 'E'

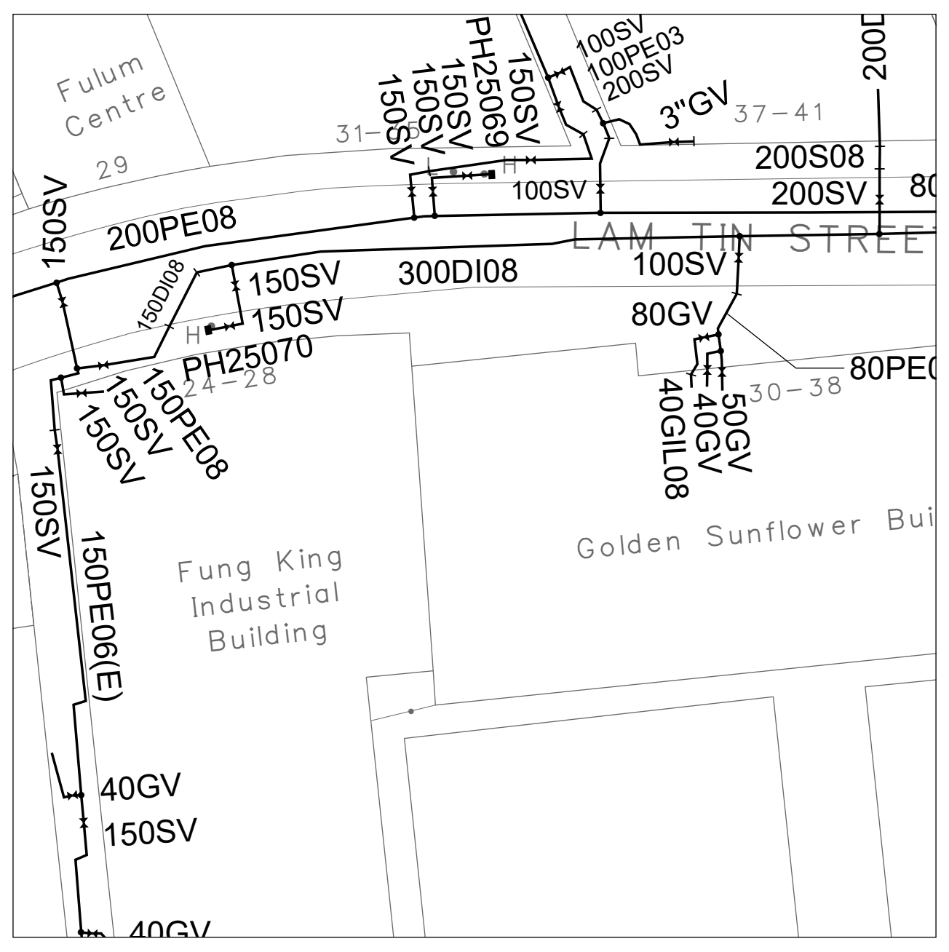

Scale 1:500

INSET 'F'

7-SW-17B

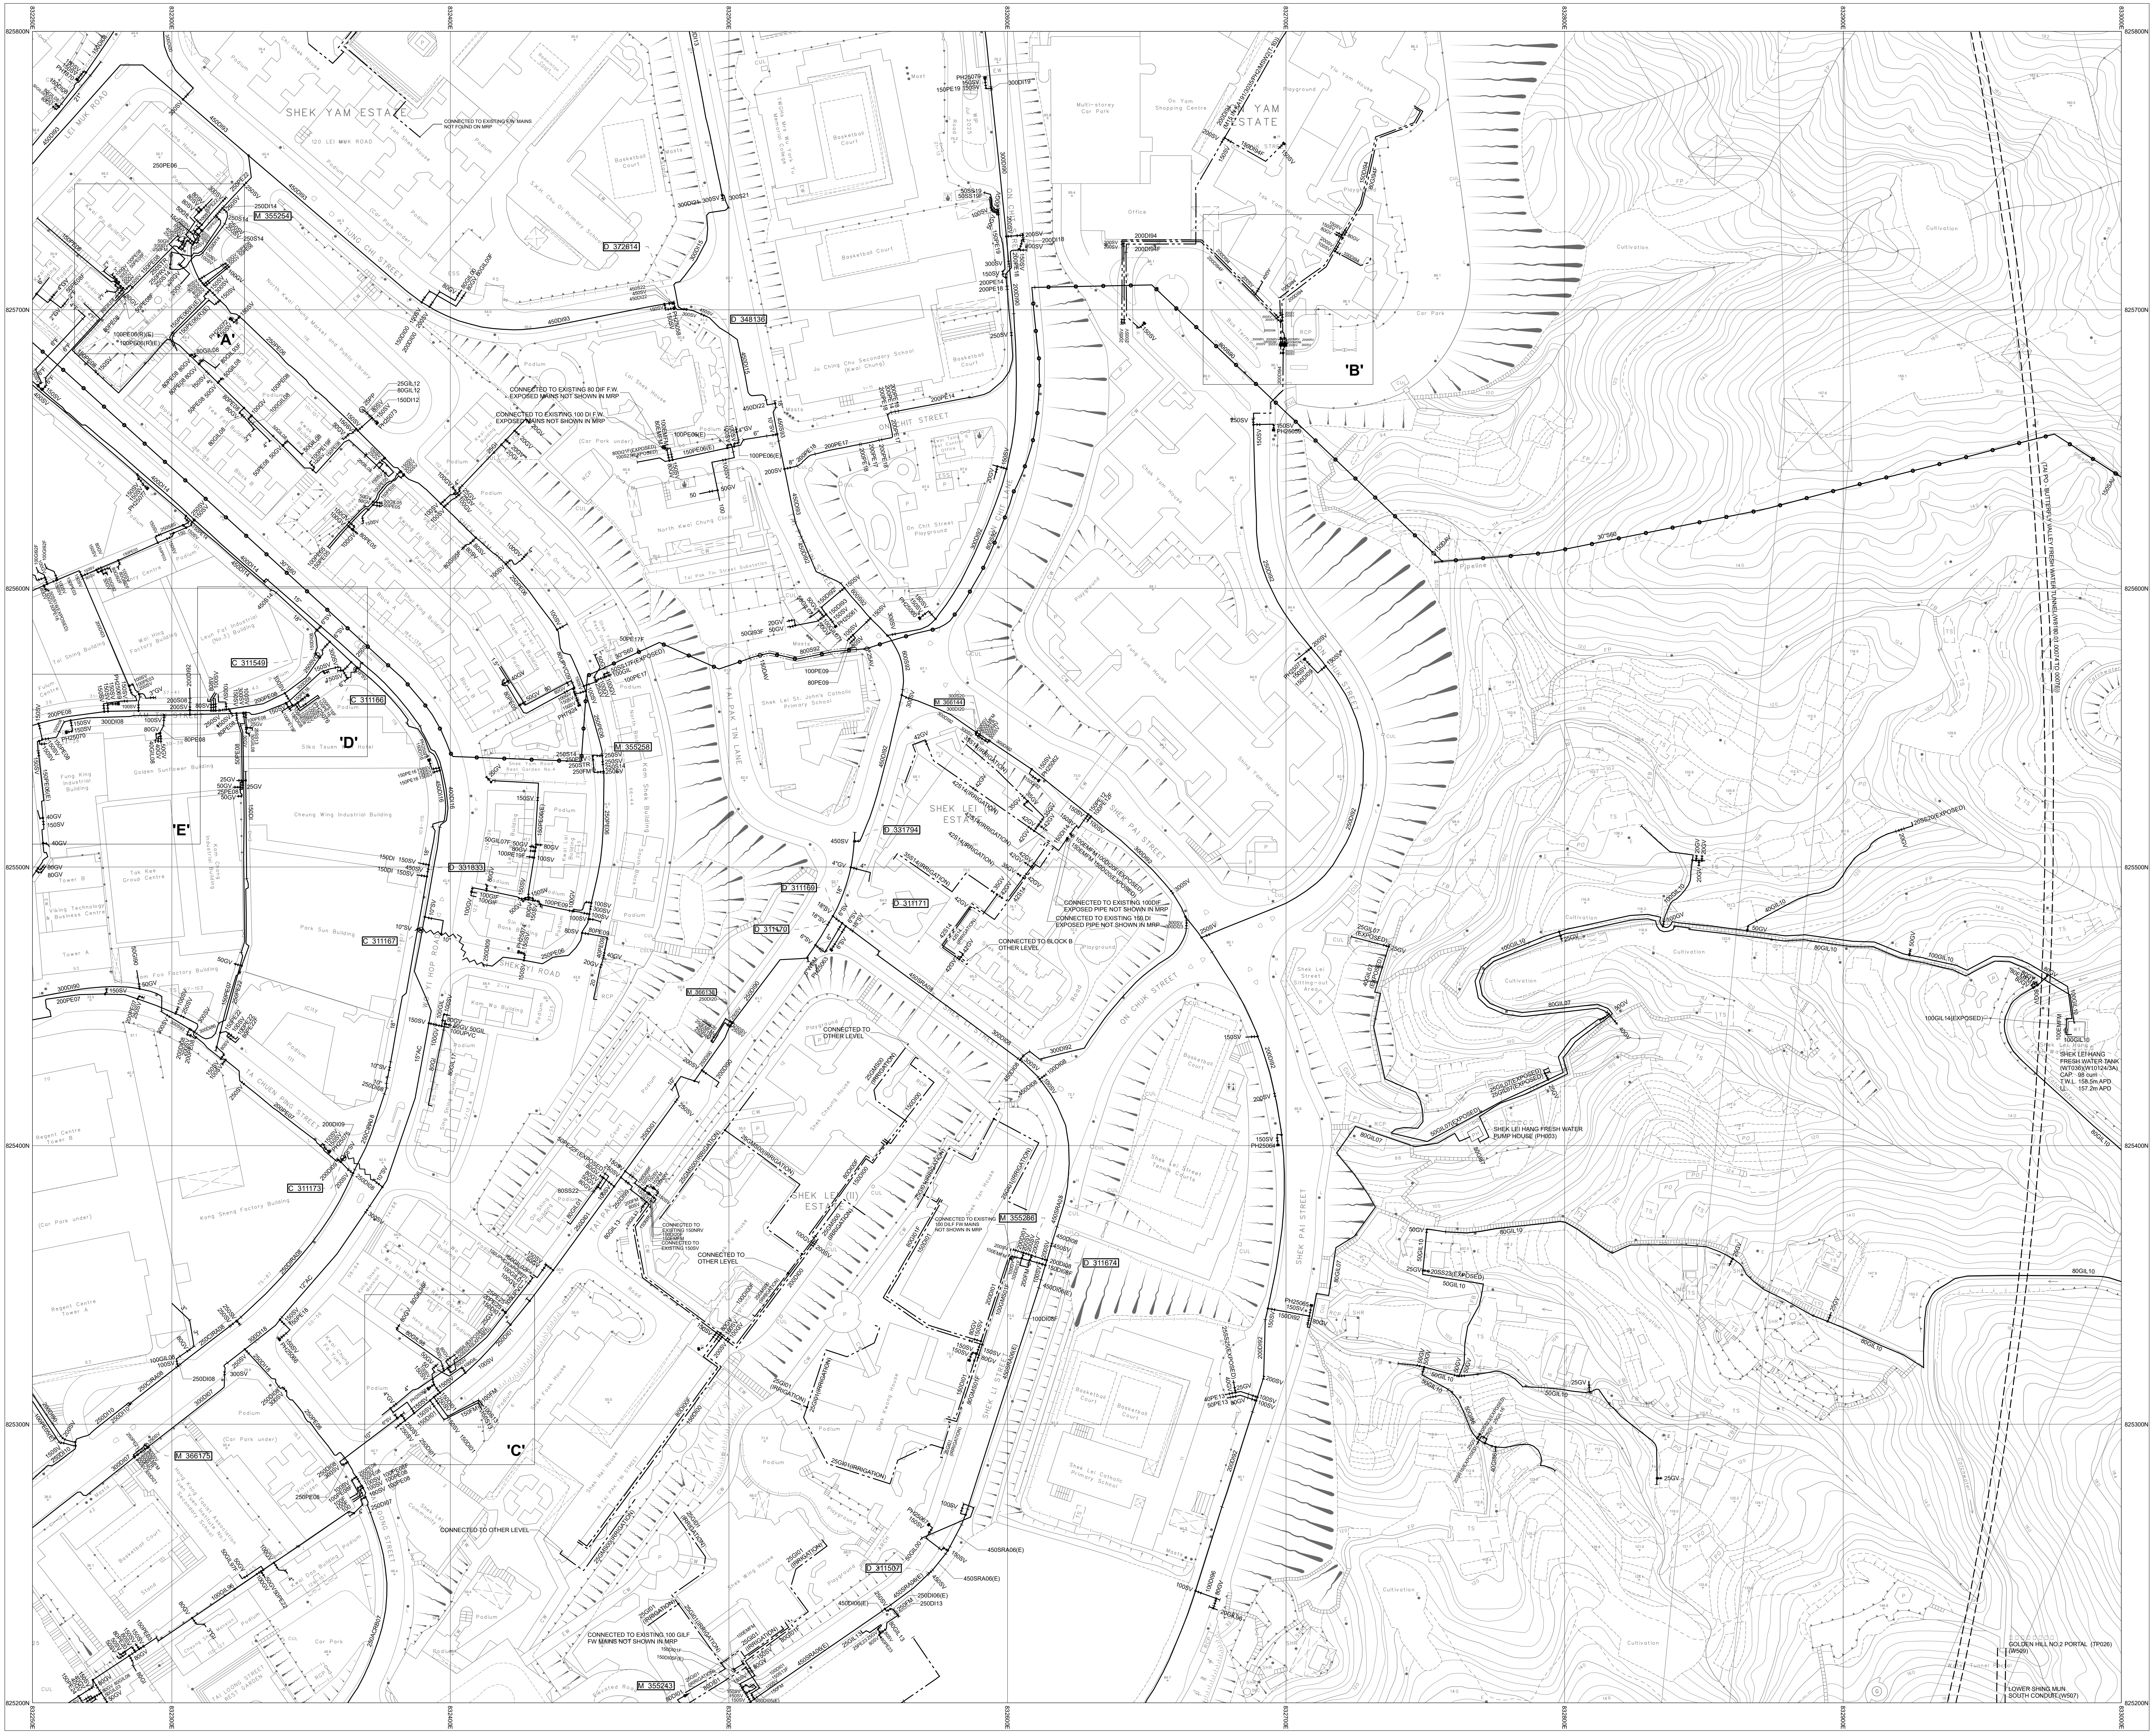

SHEK YAM ESTATE
'A'
'B'
'C'
'D'
'E'
SHEK LEI ESTATE
SHEK PAI STREET
TAI PAK TIN STREET
SHEK LEI HANG FRESH WATER PUMP HOUSE (PH003)
SHEK LEI HANG FRESH WATER TANK
CONNECTED TO OTHER LEVEL
Cultivation
GOLDEN HILL NO.2 PORTAL (TP026)
LOWER SHING MUN SOUTH CONDUIT (W507)

7-SW-17C

7-SW-18C

7-SW-22B

NOTES:

1. FOR MAINS RECORDS SIGN CONVENTIONS AND DESIGNATIONS SEE SKETCH NO.3988.
2. DIMENSIONS OF MAINS ARE IN MILLIMETRES UNLESS OTHERWISE SPECIFIED.
3. ALL LEVELS ARE IN METRES ABOVE PRINCIPAL DATUM.

Basemap Data Updated On: 05/01/2026

SCALE 1:1 000

METRES 20 10 0 20 40 60 80 100 METRES

THIS IS A COMPUTER PRINTOUT, NO SIGNATURE IS REQUIRED.

FRESH WATER MAINS RECORD PLAN

TAI PAK TIN STREET, KWAI CHUNG

COPYRIGHT RESERVED

DATE REVISED : 05/10/2026

DRAWING NO.

W67880/ 7-SW-17D

SIGNED K.T. CHU
CE/MSW
DATE: 07/10/1999

Water Supplies Department
HONG KONG

© The Government of the Hong Kong SAR, Map reproduced with permission of the Director of Lands