INSET 'A'	INSET 'B'	INSET 'C'	INSET 'D'	INSET 'E'	INSET 'F'

7-SW-18A

7-SW-17D

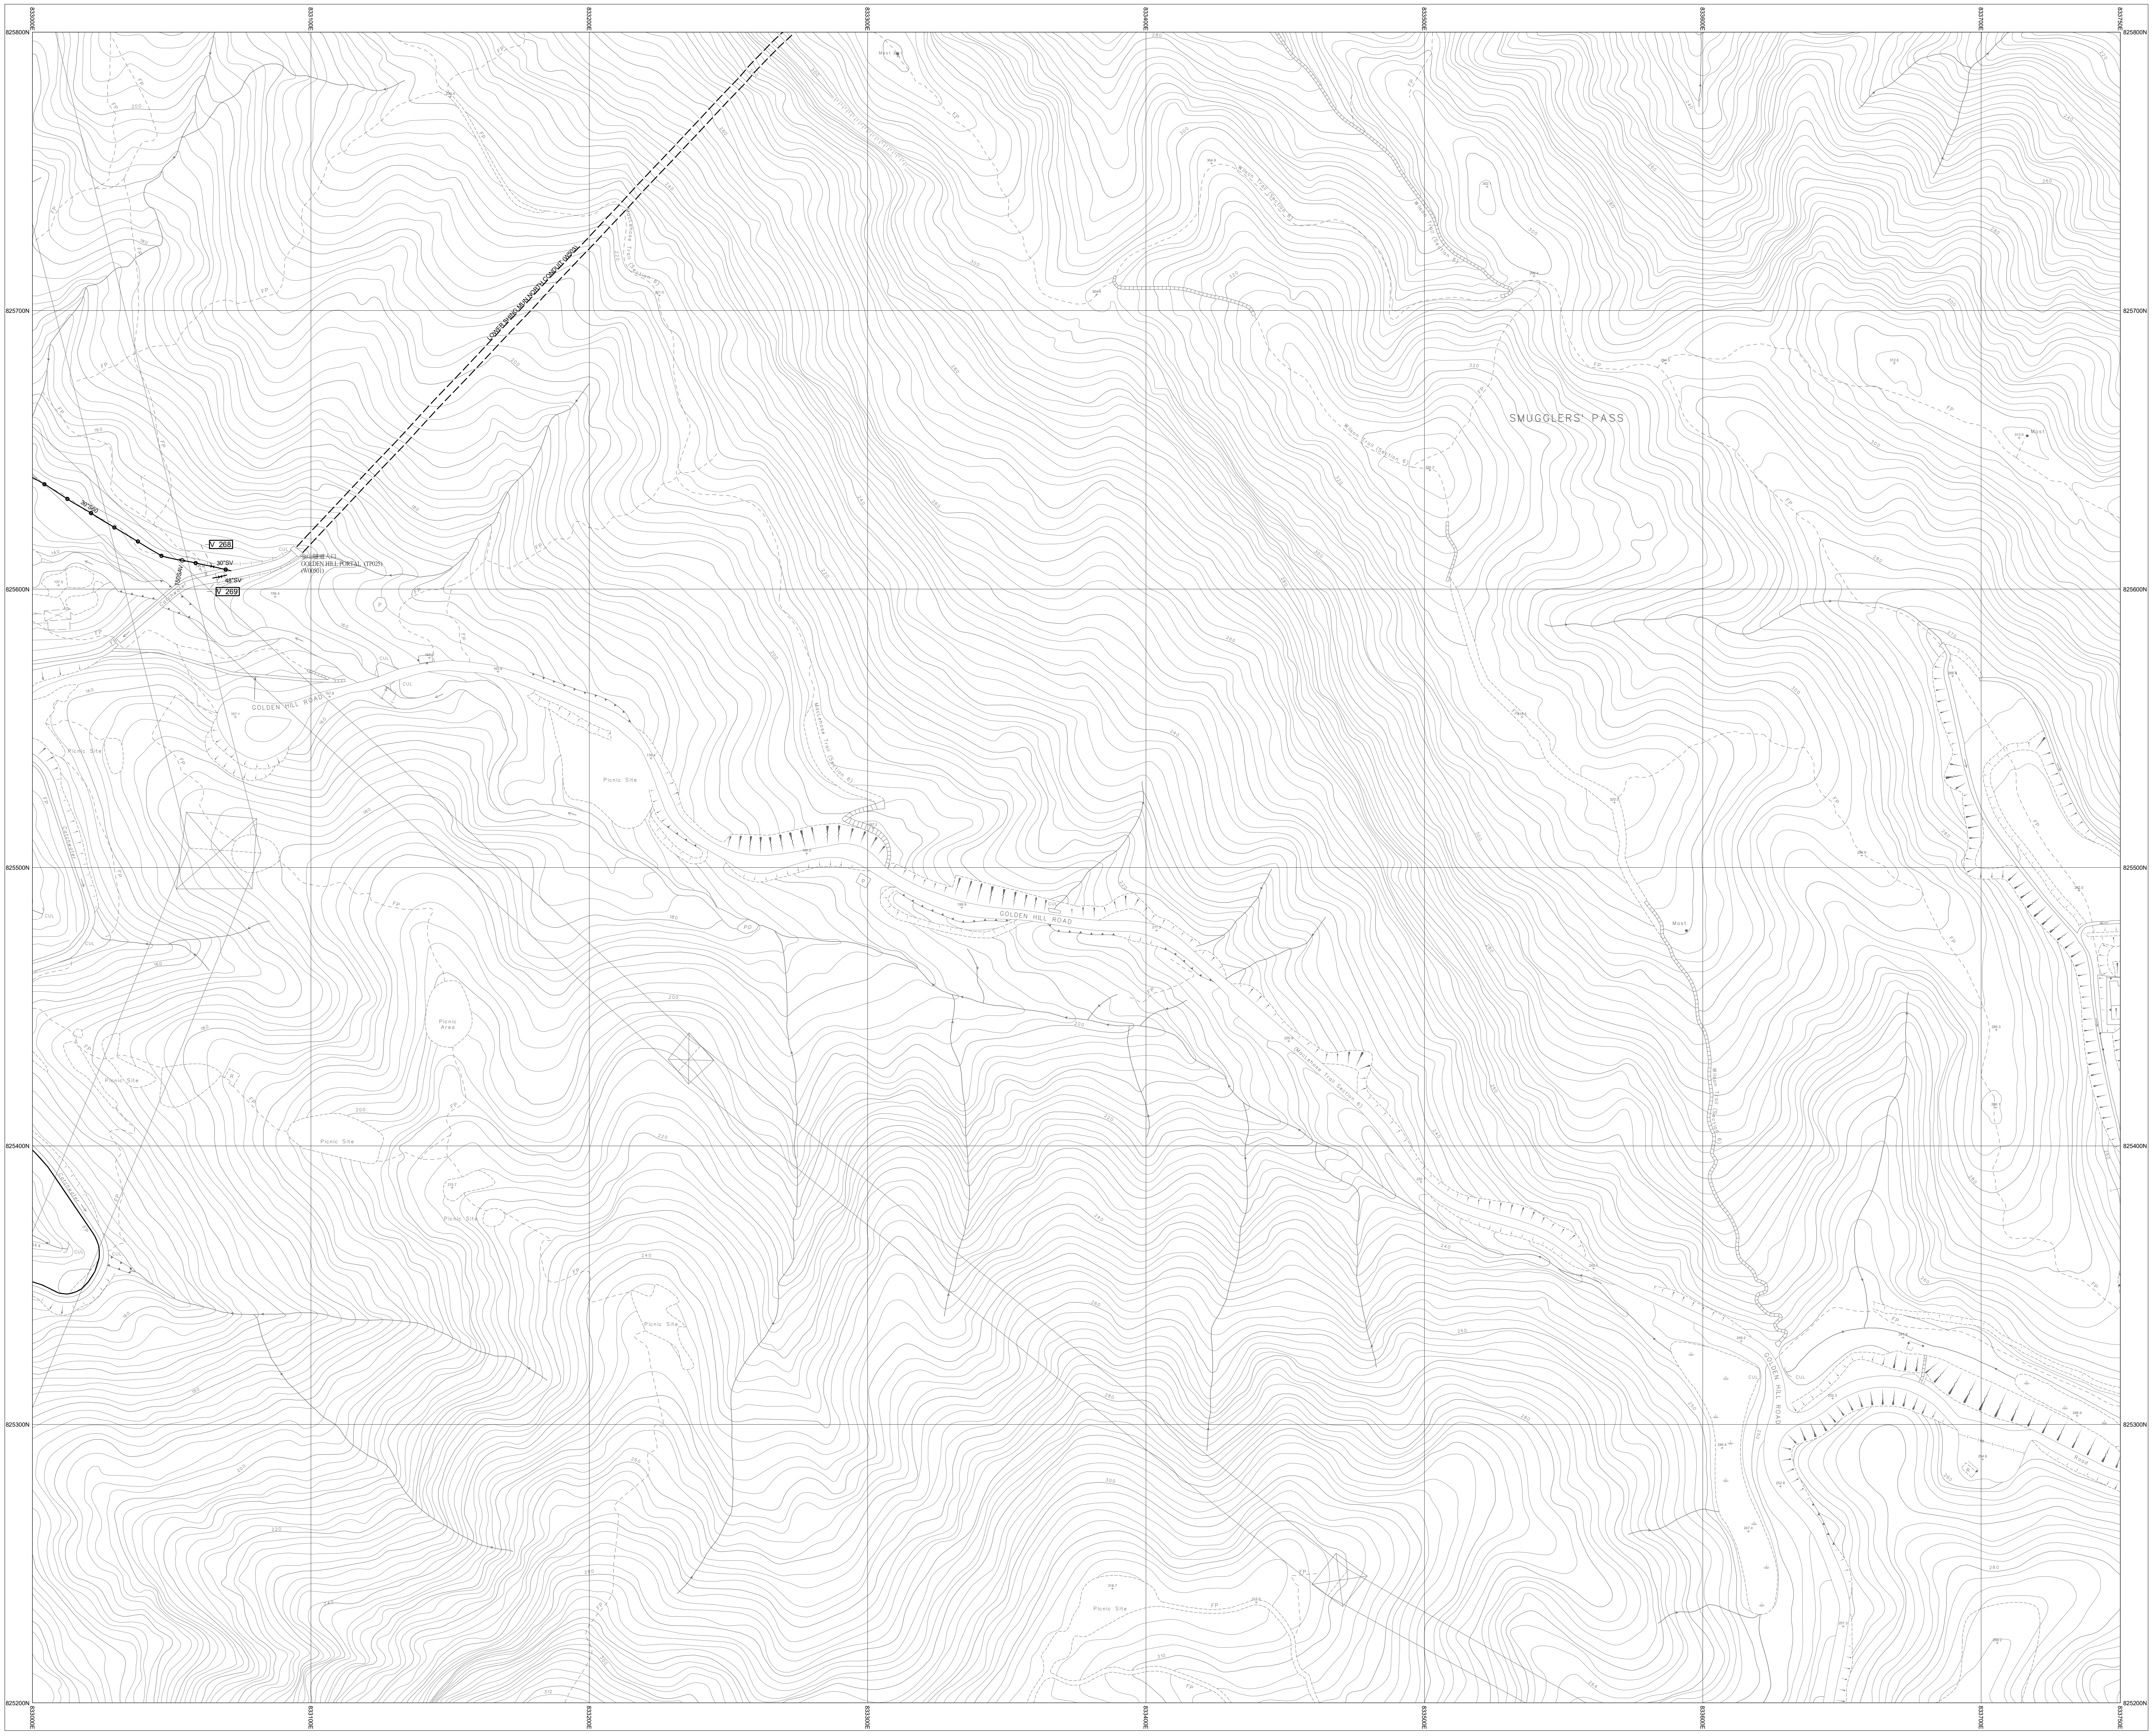
825800N
825700N
825600N
825500N
825400N
825300N
825200N
LOWER SHING MUN NORTH CONDUIT (W503)
MacLehose Trail (Sec
30"S60
150SAV
30"SV
48"SV
V 268
V 269
金山隧道入口
GOLDEN HILL PORTAL (TP025)
(W00501)
Catchwater
GOLDEN HILL ROAD
SMUGGLERS' PASS
Picnic Site
Picnic Area
CUL
FP
FB
160
180
200
220

7-SW-18D

7-SW-23A

NOTES:
1. FOR MAINS RECORDS SIGN CONVENTIONS AND DESIGNATIONS SEE SKETCH NO.3988.
2. DIMENSIONS OF MAINS ARE IN MILLIMETRES UNLESS OTHERWISE SPECIFIED.
3. ALL LEVELS ARE IN METRES ABOVE PRINCIPAL DATUM.

Basemap Date Updated On: 23/12/2024

SCALE 1:1 000

METRES 20 10 0 20 40 60 80 100 METRES

THIS IS A COMPUTER PRINTOUT,
NO SIGNATURE IS REQUIRED.

FRESH WATER MAINS RECORD PLAN

MA TSZ KENG, TSAU SZ AU

COPYRIGHT RESERVED

DATE REVISED : 30/12/2024

DRAWING NO.
W67880/ 7-SW-18C

SIGNED
C.S. CHIN
CE/MNE
DATE: 15/02/1999

Water Supplies Department
HONG KONG

© The Government of the Hong Kong SAR, Map reproduced with permission of the Director of Lands