INSET 'A'	INSET 'B'	INSET 'C'	INSET 'D'	INSET 'E'	INSET 'F'

7-SW-18B

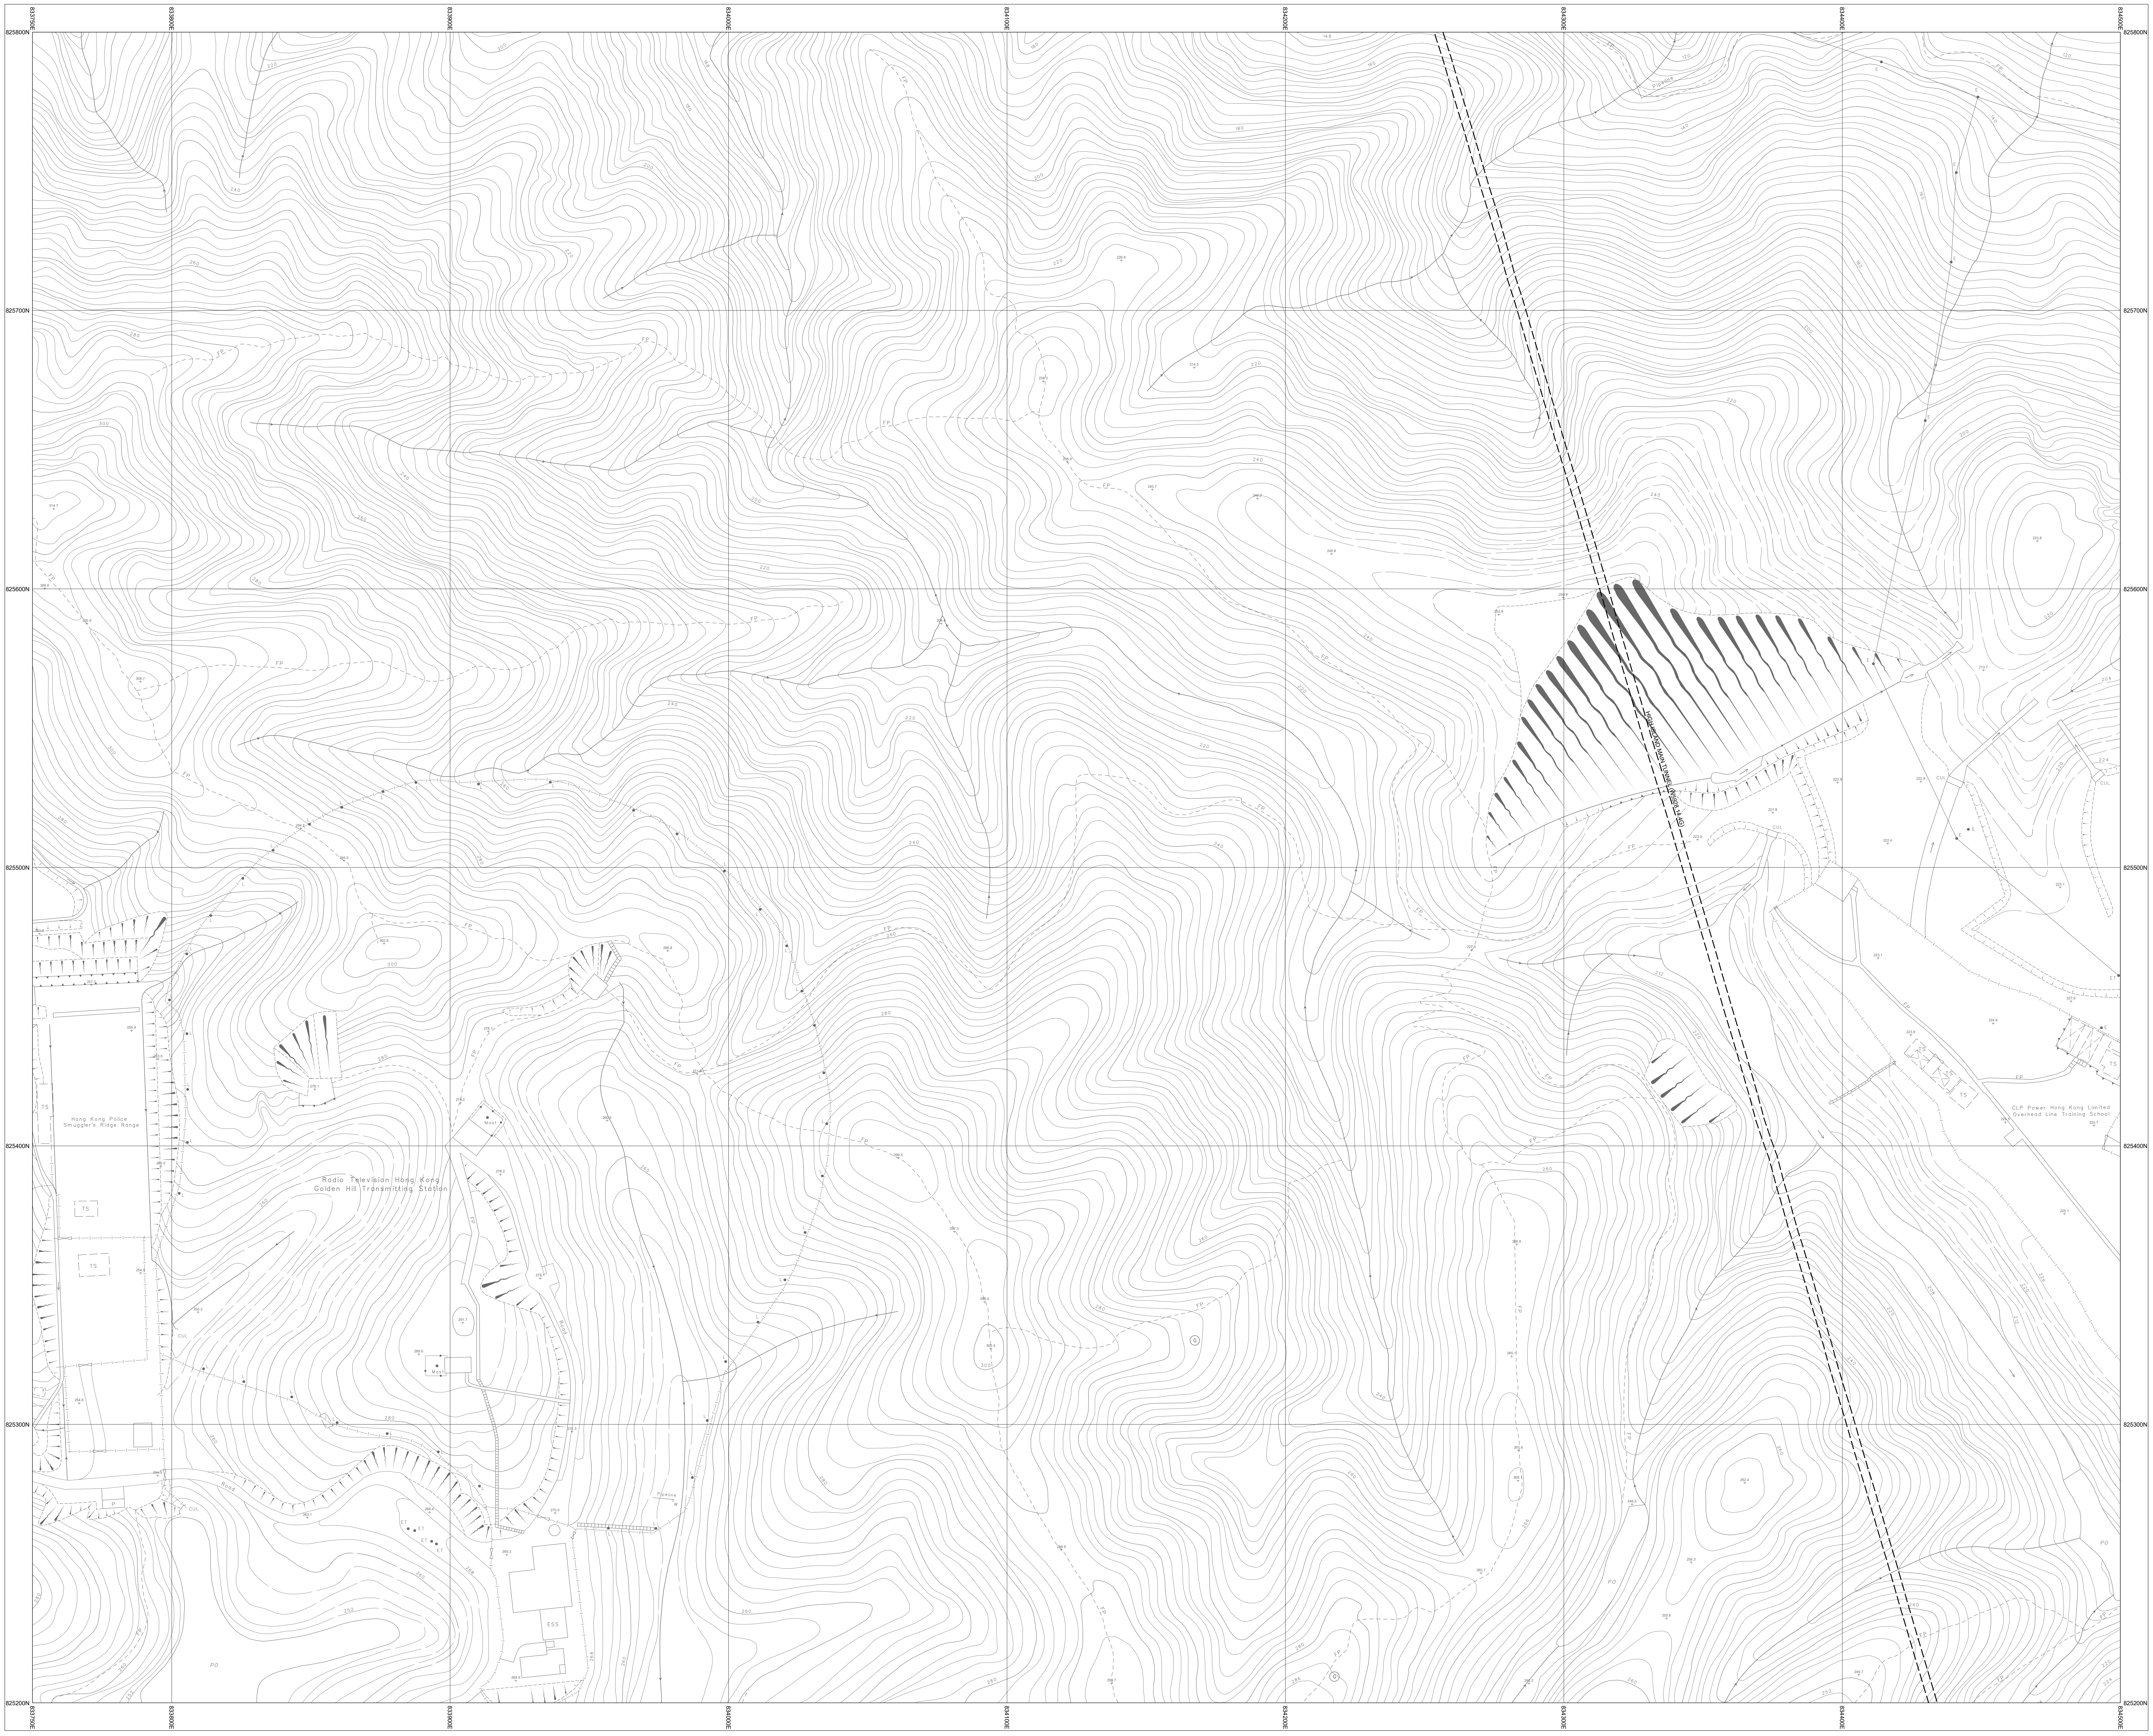
7-SW-18C
7-SW-19C
833750E
833800E
833900E
834000E
834100E
834200E
834300E
834400E
834500E
825800N
825700N
825600N
825500N
825400N
825300N
825200N
HIGH ISLAND MAIN TUNNEL (W5928.14.4G)
Hong Kong Police
Smuggler's Ridge Range
Radio Television Hong Kong
Golden Hill Transmitting Station
CLP Power Hong Kong Limited
Overhead Line Training School
Mast
TS
FP
PO
ET
E
L
300
280
260
252

7-SW-23B

NOTES:

1. FOR MAINS RECORDS SIGN CONVENTIONS AND DESIGNATIONS SEE SKETCH NO.3988.
2. DIMENSIONS OF MAINS ARE IN MILLIMETRES UNLESS OTHERWISE SPECIFIED.
3. ALL LEVELS ARE IN METRES ABOVE PRINCIPAL DATUM.

Basemap Date Updated On: 23/12/2024

SCALE 1:1 000

METRES 20 10 0 20 40 60 80 100 METRES

THIS IS A COMPUTER PRINTOUT,
NO SIGNATURE IS REQUIRED.

FRESH WATER MAINS RECORD PLAN

TSAU SZ AU, SHATIN

COPYRIGHT RESERVED

DATE REVISED : 30/12/2024

DRAWING NO.

W67880/ 7-SW-18D

SIGNED

C.S. CHIN
CE/MNE

DATE: 15/02/1999

Water Supplies Department
HONG KONG

© The Government of the Hong Kong SAR, Map reproduced with permission of the Director of Lands