


INSET 'A'

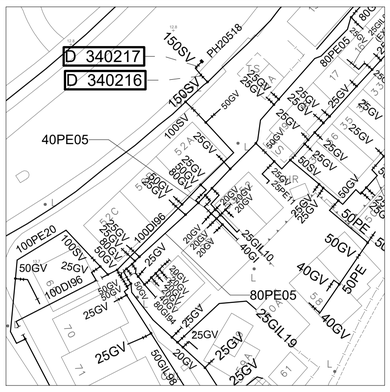

INSET 'B'

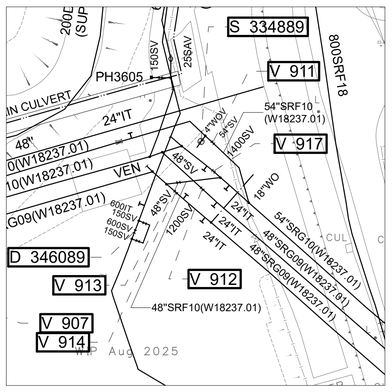

INSET 'C'

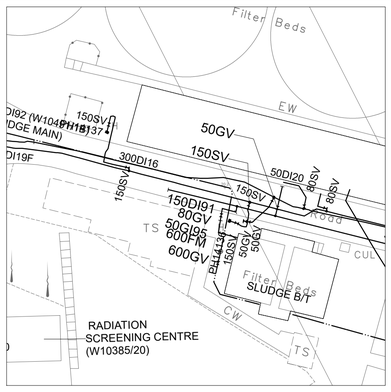


INSET 'D'

INSET 'E'

INSET 'F'

Scale 1:500 Scale 1:500 Scale 1:500 7-SW-19D

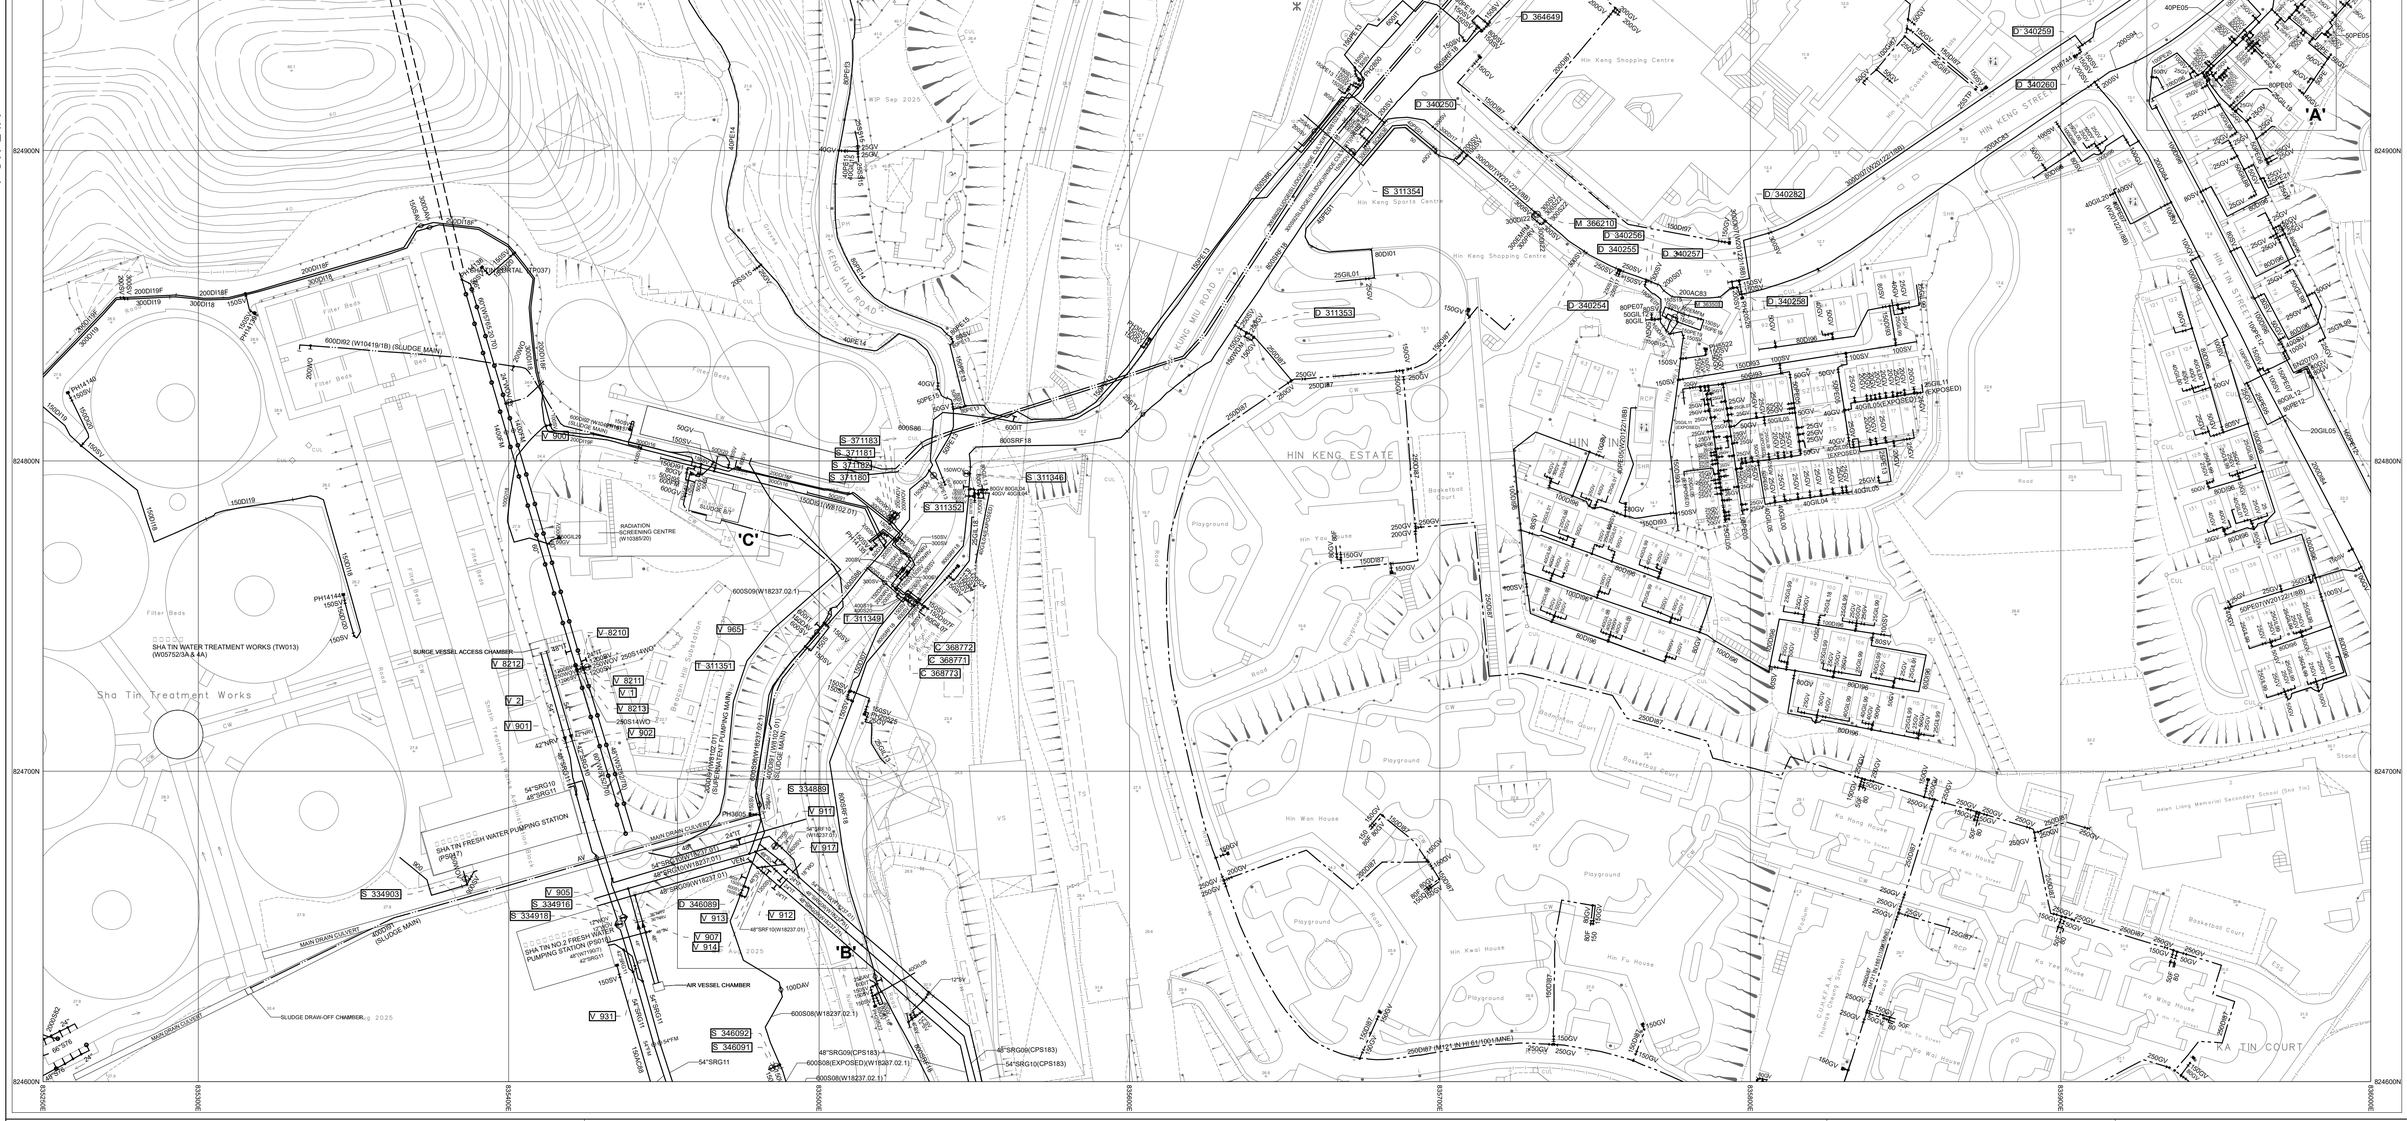

NOTES:

1. FOR MAINS RECORDS SIGN CONVENTIONS AND DESIGNATIONS SEE SKETCH NO.3988.
2. DIMENSIONS OF MAINS ARE IN MILLIMETRES UNLESS OTHERWISE SPECIFIED.
3. ALL LEVELS ARE IN METRES ABOVE PRINCIPAL DATUM.

Basemap Date Updated On: 05/01/2026

SCALE 1:1 000

METRES 20 10 0 20 40 60 80 100 METRES

FRESH WATER MAINS RECORD PLAN

HIN KENG ESTATE, HIN TIN

THIS IS A COMPUTER PRINTOUT, NO SIGNATURE IS REQUIRED.

COPYRIGHT RESERVED

DATE REVISED : 04/06/2026

SIGNED C.S. CHIN
CE/MNE
DATE: 15/02/1999

DRAWING NO.

W67880/ 7-SW-24B

Water Supplies Department
HONG KONG

© The Government of the Hong Kong SAR, Map reproduced with permission of the Director of Lands