INSET 'A'

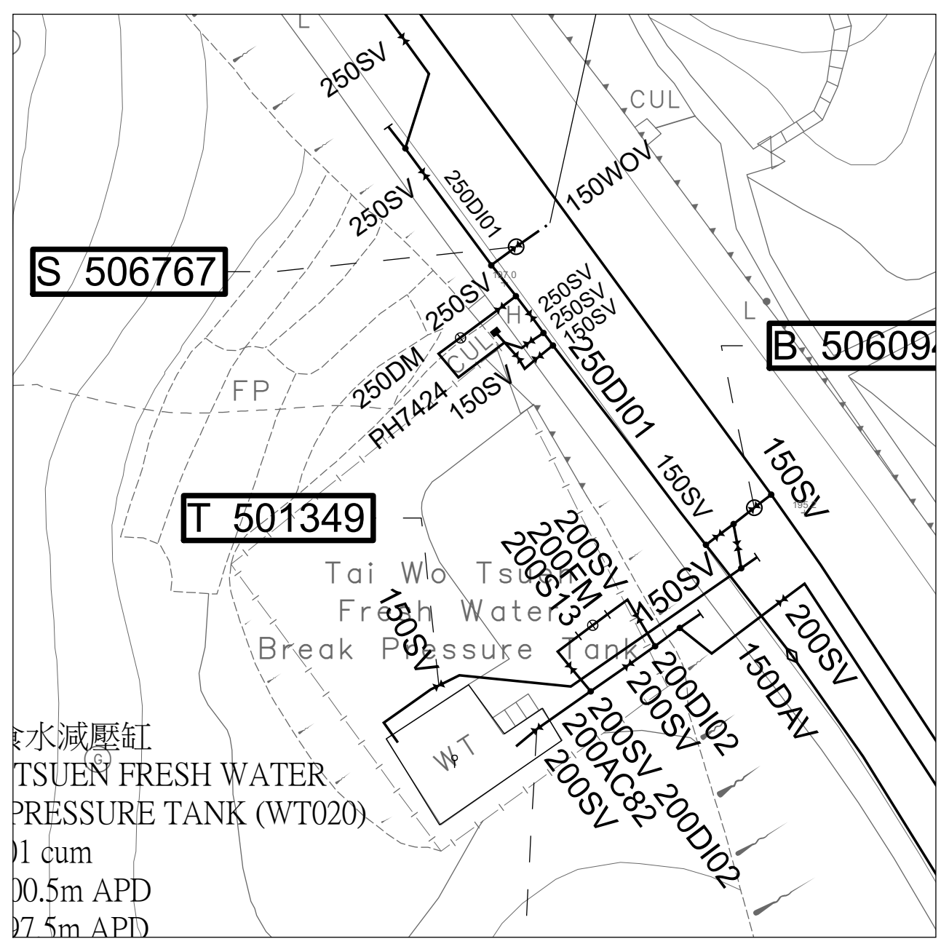
S 506767
B 50609
T 501349
250SV
150WOV
250DI01
150SV
200SV
150DAV
200DI02
Tai Wo Tsuen Fresh Water Break Pressure Tank
TSUEN FRESH WATER
PRESSURE TANK (WT020)
0.5m APD
7.5m APD
CUL
FP

INSET 'B'

INSET 'C'

INSET 'D'

INSET 'E'

INSET 'F'

Scale 1:500

7-SW-22D

11-NW-2A

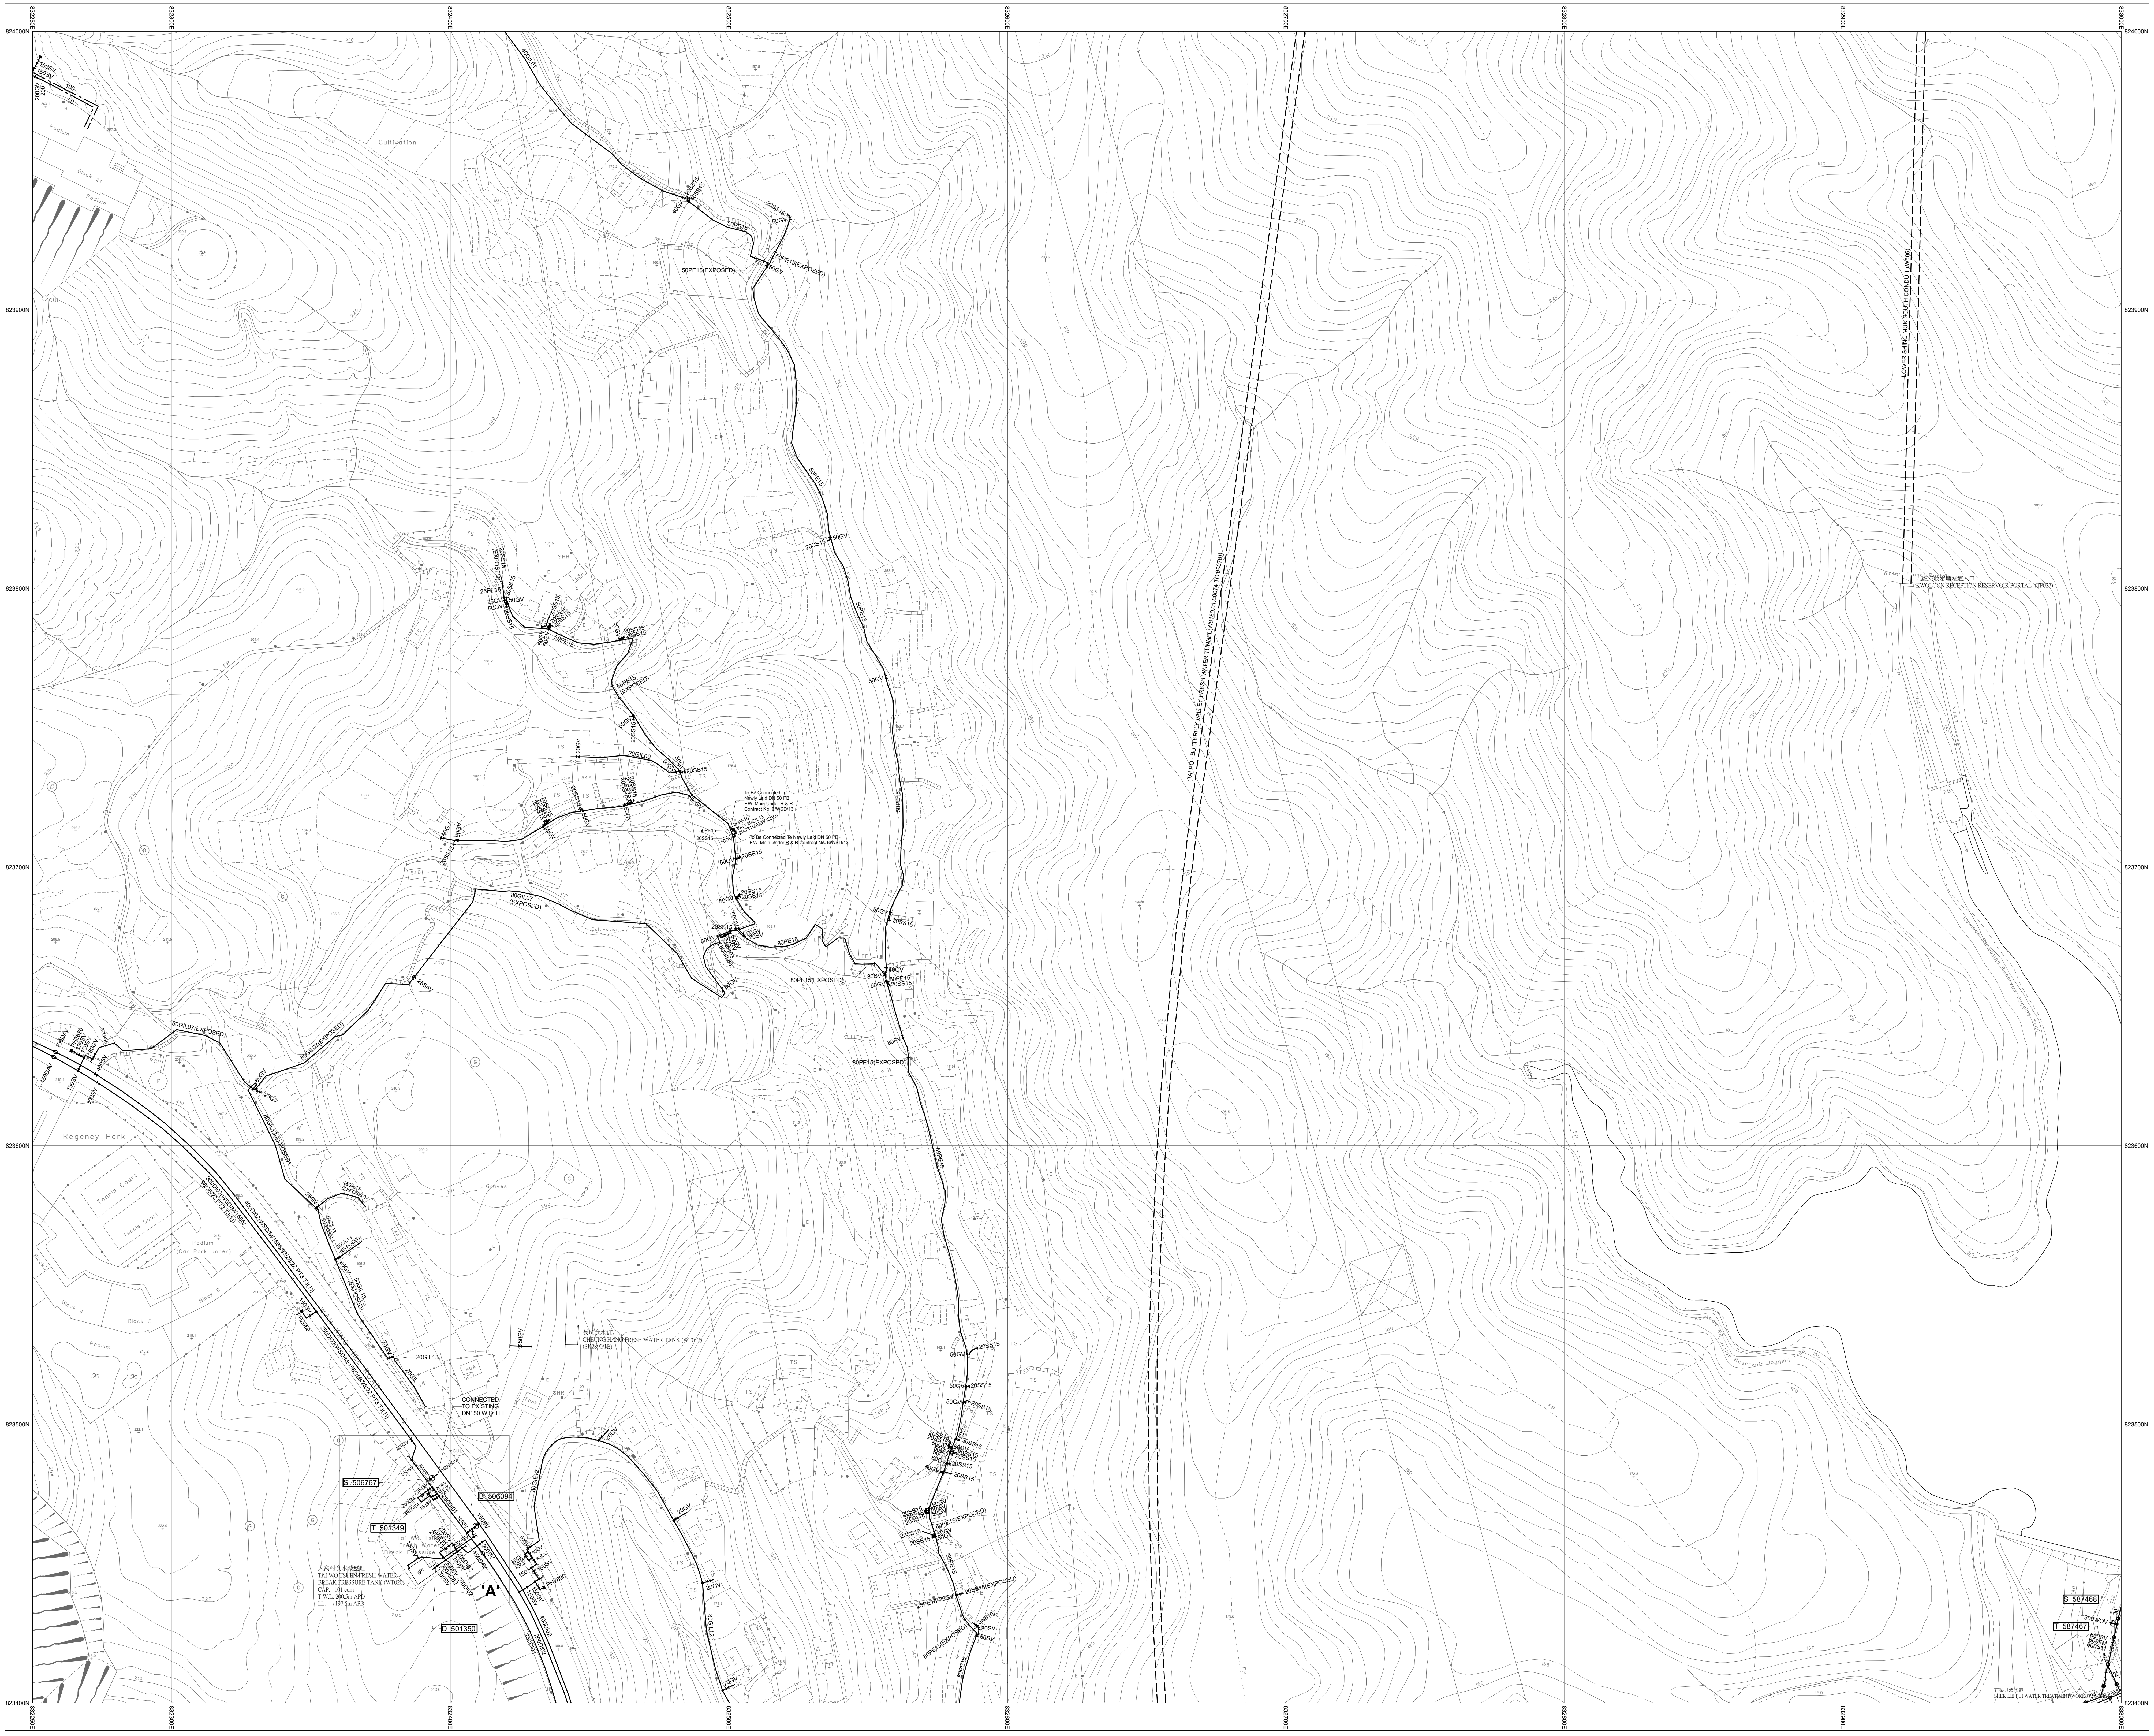
Regency Park
Tennis Court
Cultivation
'A'
S 506757
T 501349
B 506098
D 501350
S 587468
T 587467
CONNECTED TO EXISTING DN150 W.O TEE
50PE15(EXPOSED)
80PE15(EXPOSED)
823400N
823500N
823600N
823700N
823800N
823900N
824000N
832250E
832300E
832400E
832500E
832600E
832700E
832800E
832900E
833000E
石梨貝濾水廠
SHEK LEI PUI WATER TREATMENT WORKS

11-NW-3A

11-NW-2D

NOTES:

1. FOR MAINS RECORDS SIGN CONVENTIONS AND DESIGNATIONS SEE SKETCH NO.3988.
2. DIMENSIONS OF MAINS ARE IN MILLIMETRES UNLESS OTHERWISE SPECIFIED.
3. ALL LEVELS ARE IN METRES ABOVE PRINCIPAL DATUM.

Basemap Date Updated On: 23/12/2024

SCALE 1:1 000

METRES 20 10 0 20 40 60 80 100 METRES

FRESH WATER MAINS RECORD PLAN

WAH KING HILL ROAD, HA KWAI CHUNG

THIS IS A COMPUTER PRINTOUT,
NO SIGNATURE IS REQUIRED.

COPYRIGHT RESERVED

DATE REVISED : 31/12/2024

SIGNED
K.T. CHU
CE/MSW
DATE: 07/10/1999

DRAWING NO.
W67880/ 11-NW-2B

Water Supplies Department
HONG KONG

© The Government of the Hong Kong SAR, Map reproduced with permission of the Director of Lands