INSET 'A'	INSET 'B'	INSET 'C'	INSET 'D'	INSET 'E'	INSET 'F'
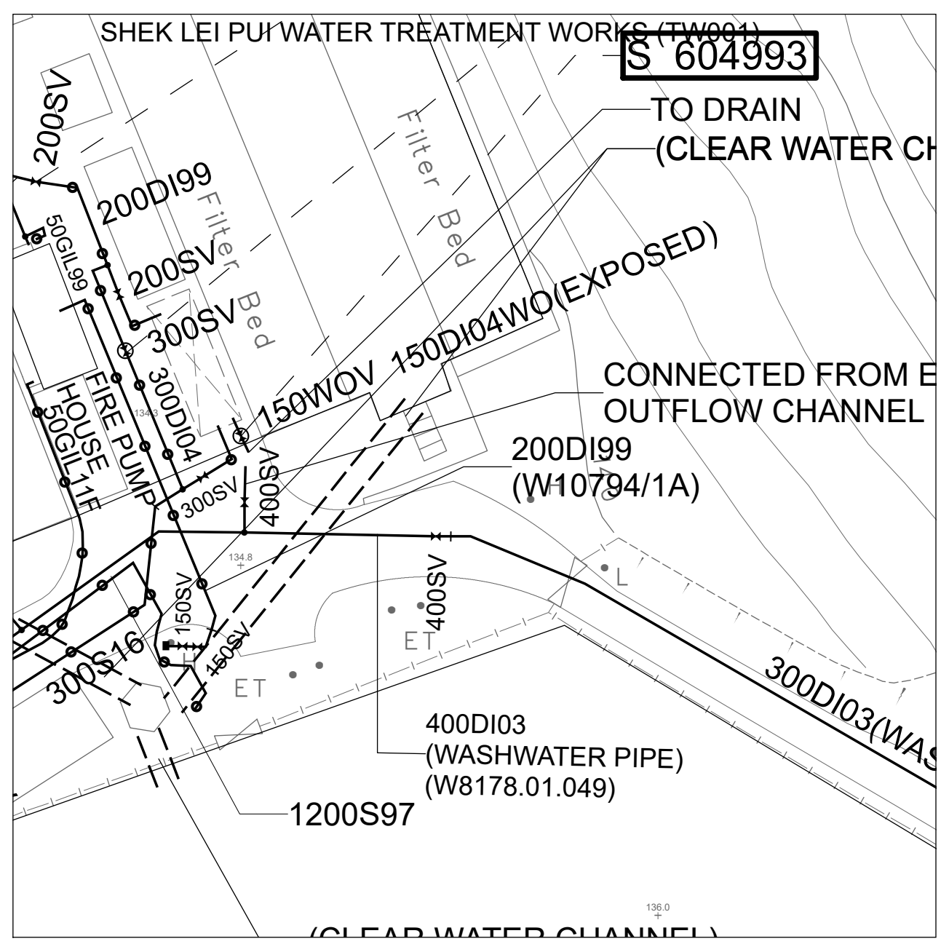					

SHEK LEI PUI WATER TREATMENT WORKS (TW001)
S 604993
TO DRAIN
(CLEAR WATER CH
200SV
200DI99
200SV
300SV
150WOV
150DI04WO(EXPOSED)
CONNECTED FROM E
OUTFLOW CHANNEL
200DI99
(W10794/1A)
300DI04
400SV
300S16
400DI03
(WASHWATER PIPE)
(W8178.01.049)
1200S97
300DI03(WAS
(CLEAR WATER CHANNEL)

Scale 1:500

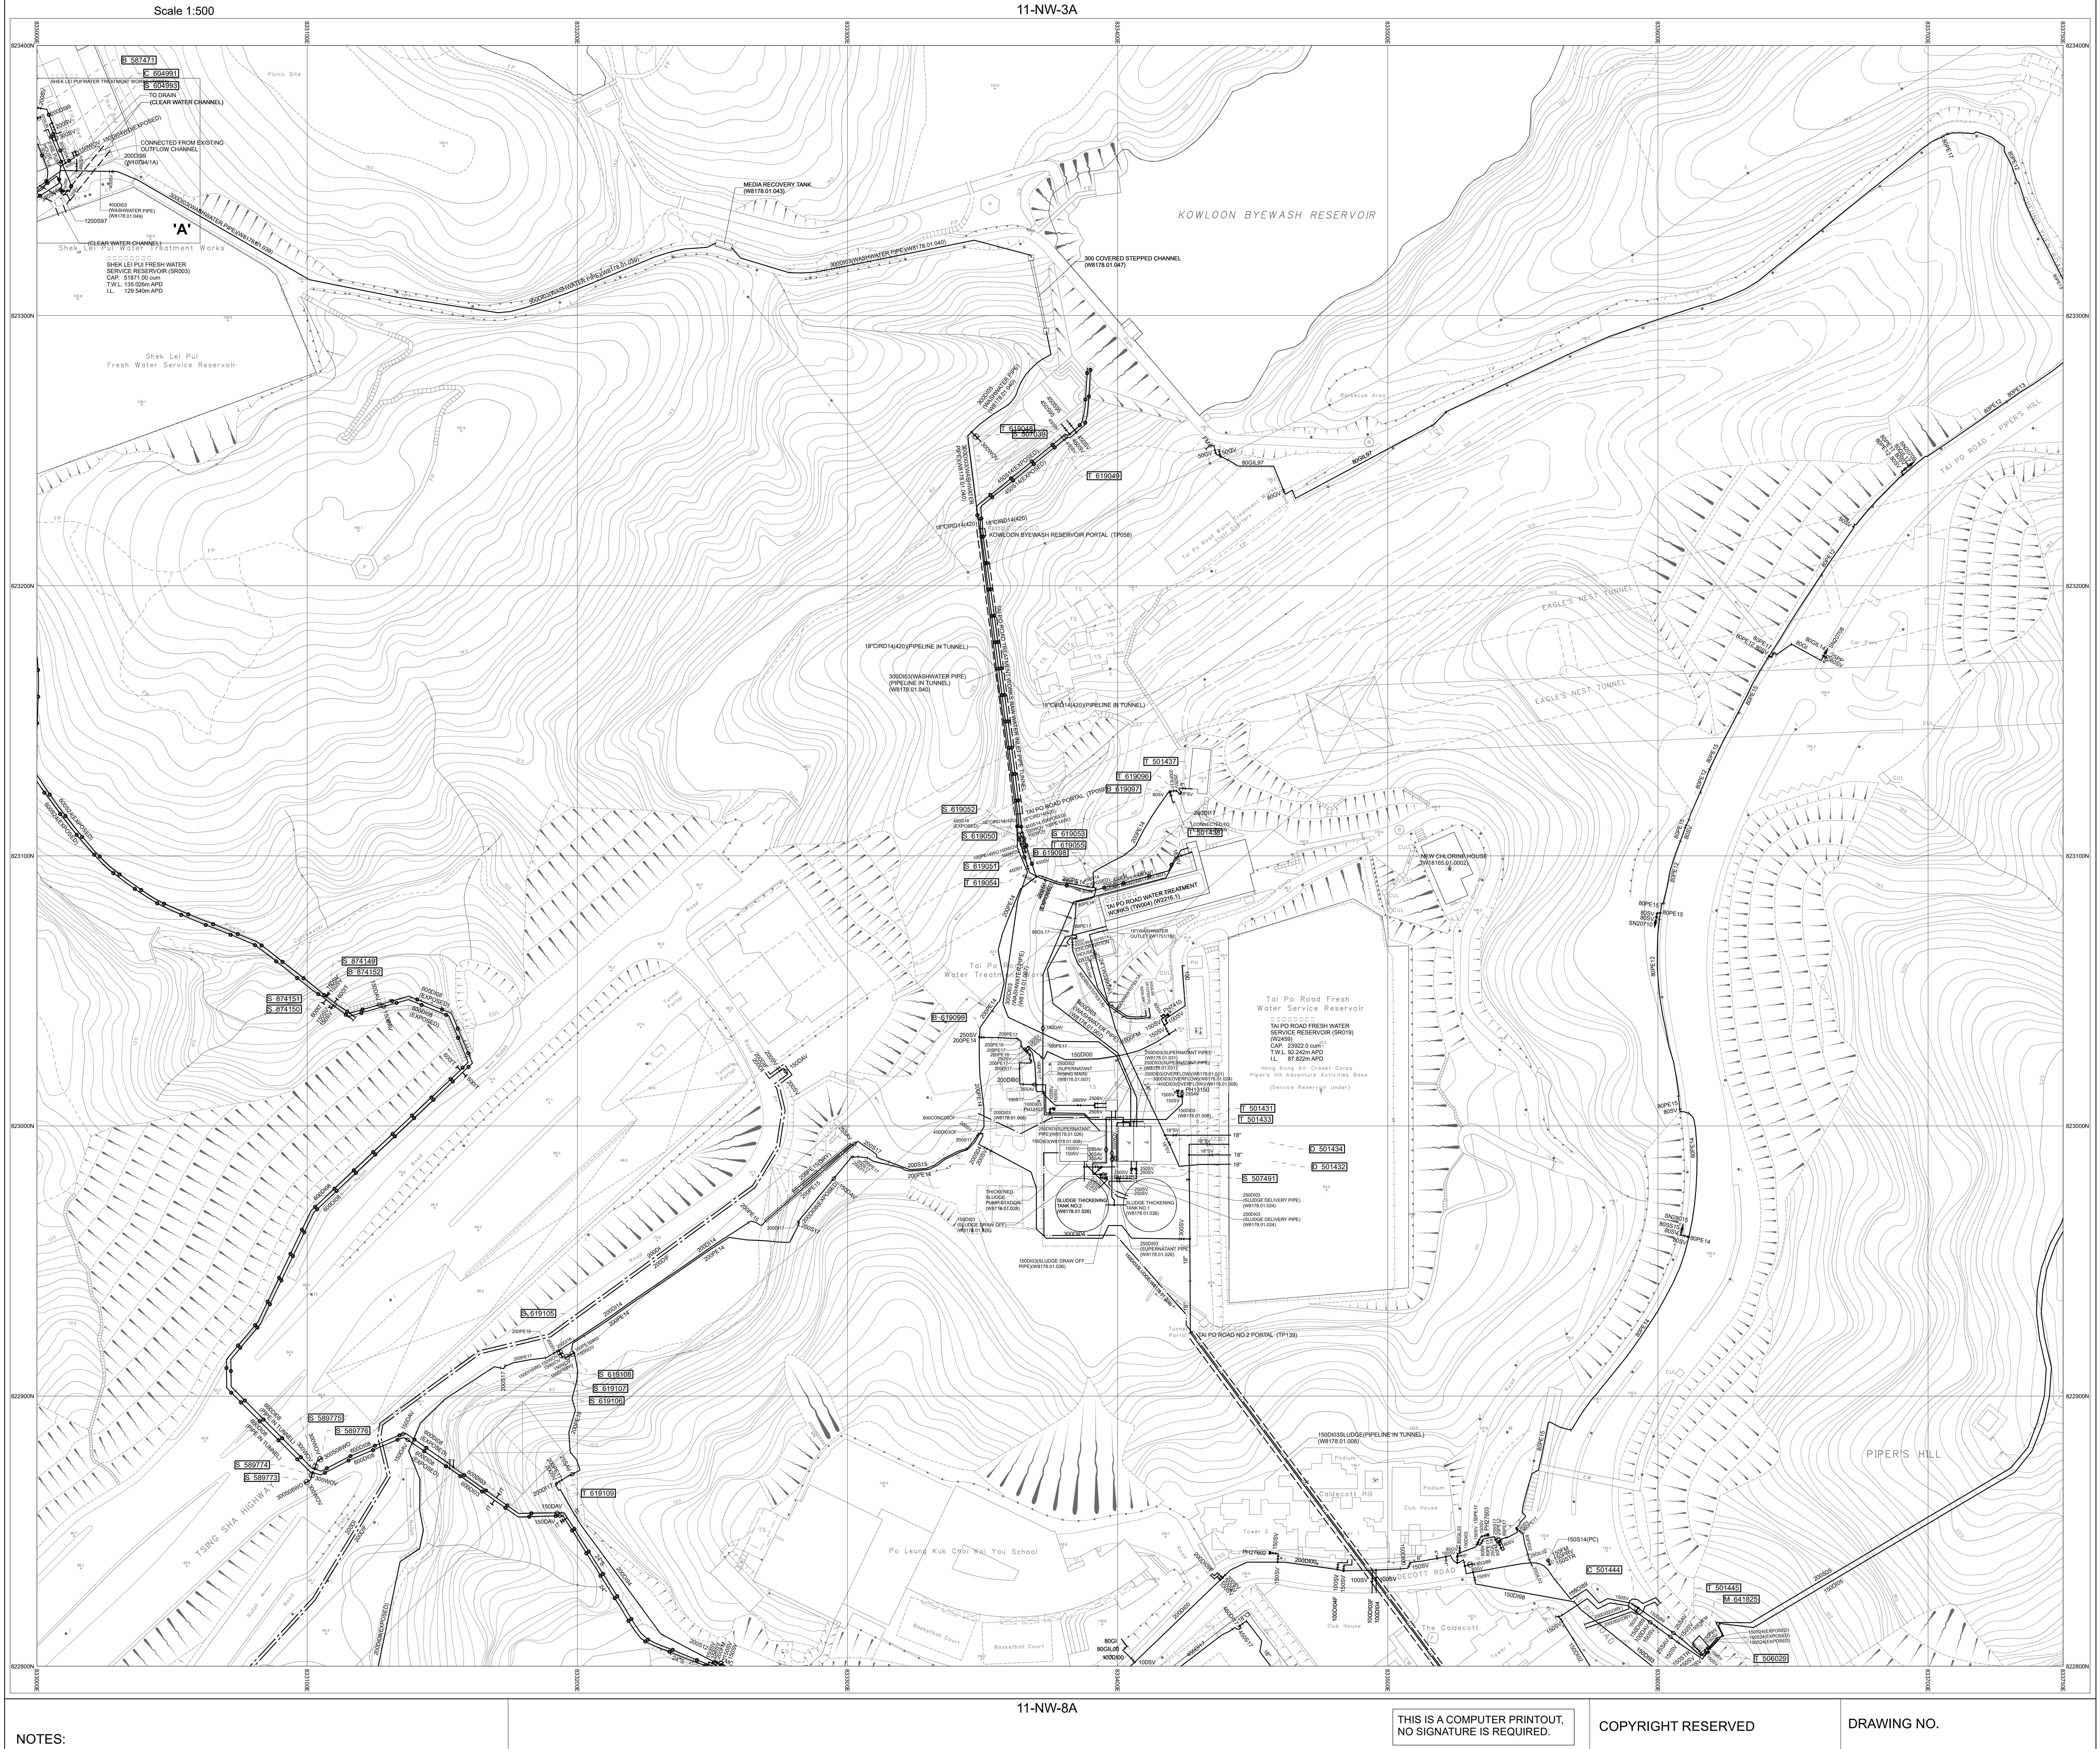

11-NW-3A
11-NW-2D
11-NW-3D
11-NW-8A
823400N
823300N
823200N
823100N
823000N
822900N
822800N
'A'
Shek Lei Pui Water Treatment Works
SHEK LEI PUI FRESH WATER SERVICE RESERVOIR (SR003)
CAP. 51871.00 cum
T.W.L. 135.026m APD
I.L. 129.540m APD
Shek Lei Pui Fresh Water Service Reservoir
MEDIA RECOVERY TANK (W8178.01.043)
300 COVERED STEPPED CHANNEL (W8178.01.047)
KOWLOON BYEWASH RESERVOIR
KOWLOON BYEWASH RESERVOIR PORTAL (TP058)
18"CIRD14(420)(PIPELINE IN TUNNEL)
300DI03(WASHWATER PIPE) (PIPELINE IN TUNNEL) (W8178.01.040)
EAGLE'S NEST TUNNEL
EAGLE'S WEST TUNNEL
TAI PO ROAD PORTAL (TP059)
TAI PO ROAD WATER TREATMENT WORKS (TW004) (W2216.1)
Tai Po Road Water Treatment Works
NEW CHLORINE HOUSE (W8165.01.0002)
Tai Po Road Fresh Water Service Reservoir
TAI PO ROAD FRESH WATER SERVICE RESERVOIR (SR019)
(W2459)
CAP. 23922.0 cum
T.W.L. 92.242m APD
I.L. 87.822m APD
Hong Kong Air Cradet Corps Piper's Hill Adventure Activities Base
(Service Reservoir Under)
SLUDGE THICKENING TANK NO.2 (W8178.01.026)
SLUDGE THICKENING TANK NO.1 (W8178.01.026)
THICKENED SLUDGE PUMP STATION (W8718.01.028)
TAI PO ROAD NO.2 PORTAL (TP139)
150DI03SLUDGE(PIPELINE IN TUNNEL) (W8178.01.008)
PIPER'S HILL
TSING SHA HIGHWAY
Po Leung Kuk Choi Kai Yau School
CALDECOTT ROAD
The Caldecott
TAI PO ROAD - PIPER'S HILL

NOTES:

1. FOR MAINS RECORDS SIGN CONVENTIONS AND DESIGNATIONS SEE SKETCH NO.3988.
2. DIMENSIONS OF MAINS ARE IN MILLIMETRES UNLESS OTHERWISE SPECIFIED.
3. ALL LEVELS ARE IN METRES ABOVE PRINCIPAL DATUM.

Basemap Data Updated On: 05/01/2026

SCALE 1:1 000

METRES 20 10 0 20 40 60 80 100 METRES

THIS IS A COMPUTER PRINTOUT, NO SIGNATURE IS REQUIRED.

FRESH WATER MAINS RECORD PLAN

TAI PO ROAD F.W. S/R, KWAI CHUNG EAST

COPYRIGHT RESERVED

DATE REVISED : 05/10/2026

DRAWING NO.

W67880/ 11-NW-3C

SIGNED K.T. CHU
CE/MSW
DATE: 07/10/1999

Water Supplies Department
HONG KONG

© The Government of the Hong Kong SAR, Map reproduced with permission of the Director of Lands