INSET 'A'	INSET 'B'	INSET 'C'	INSET 'D'	INSET 'E'	INSET 'F'

7-NE-16B

7-NE-16C

7-NE-17C

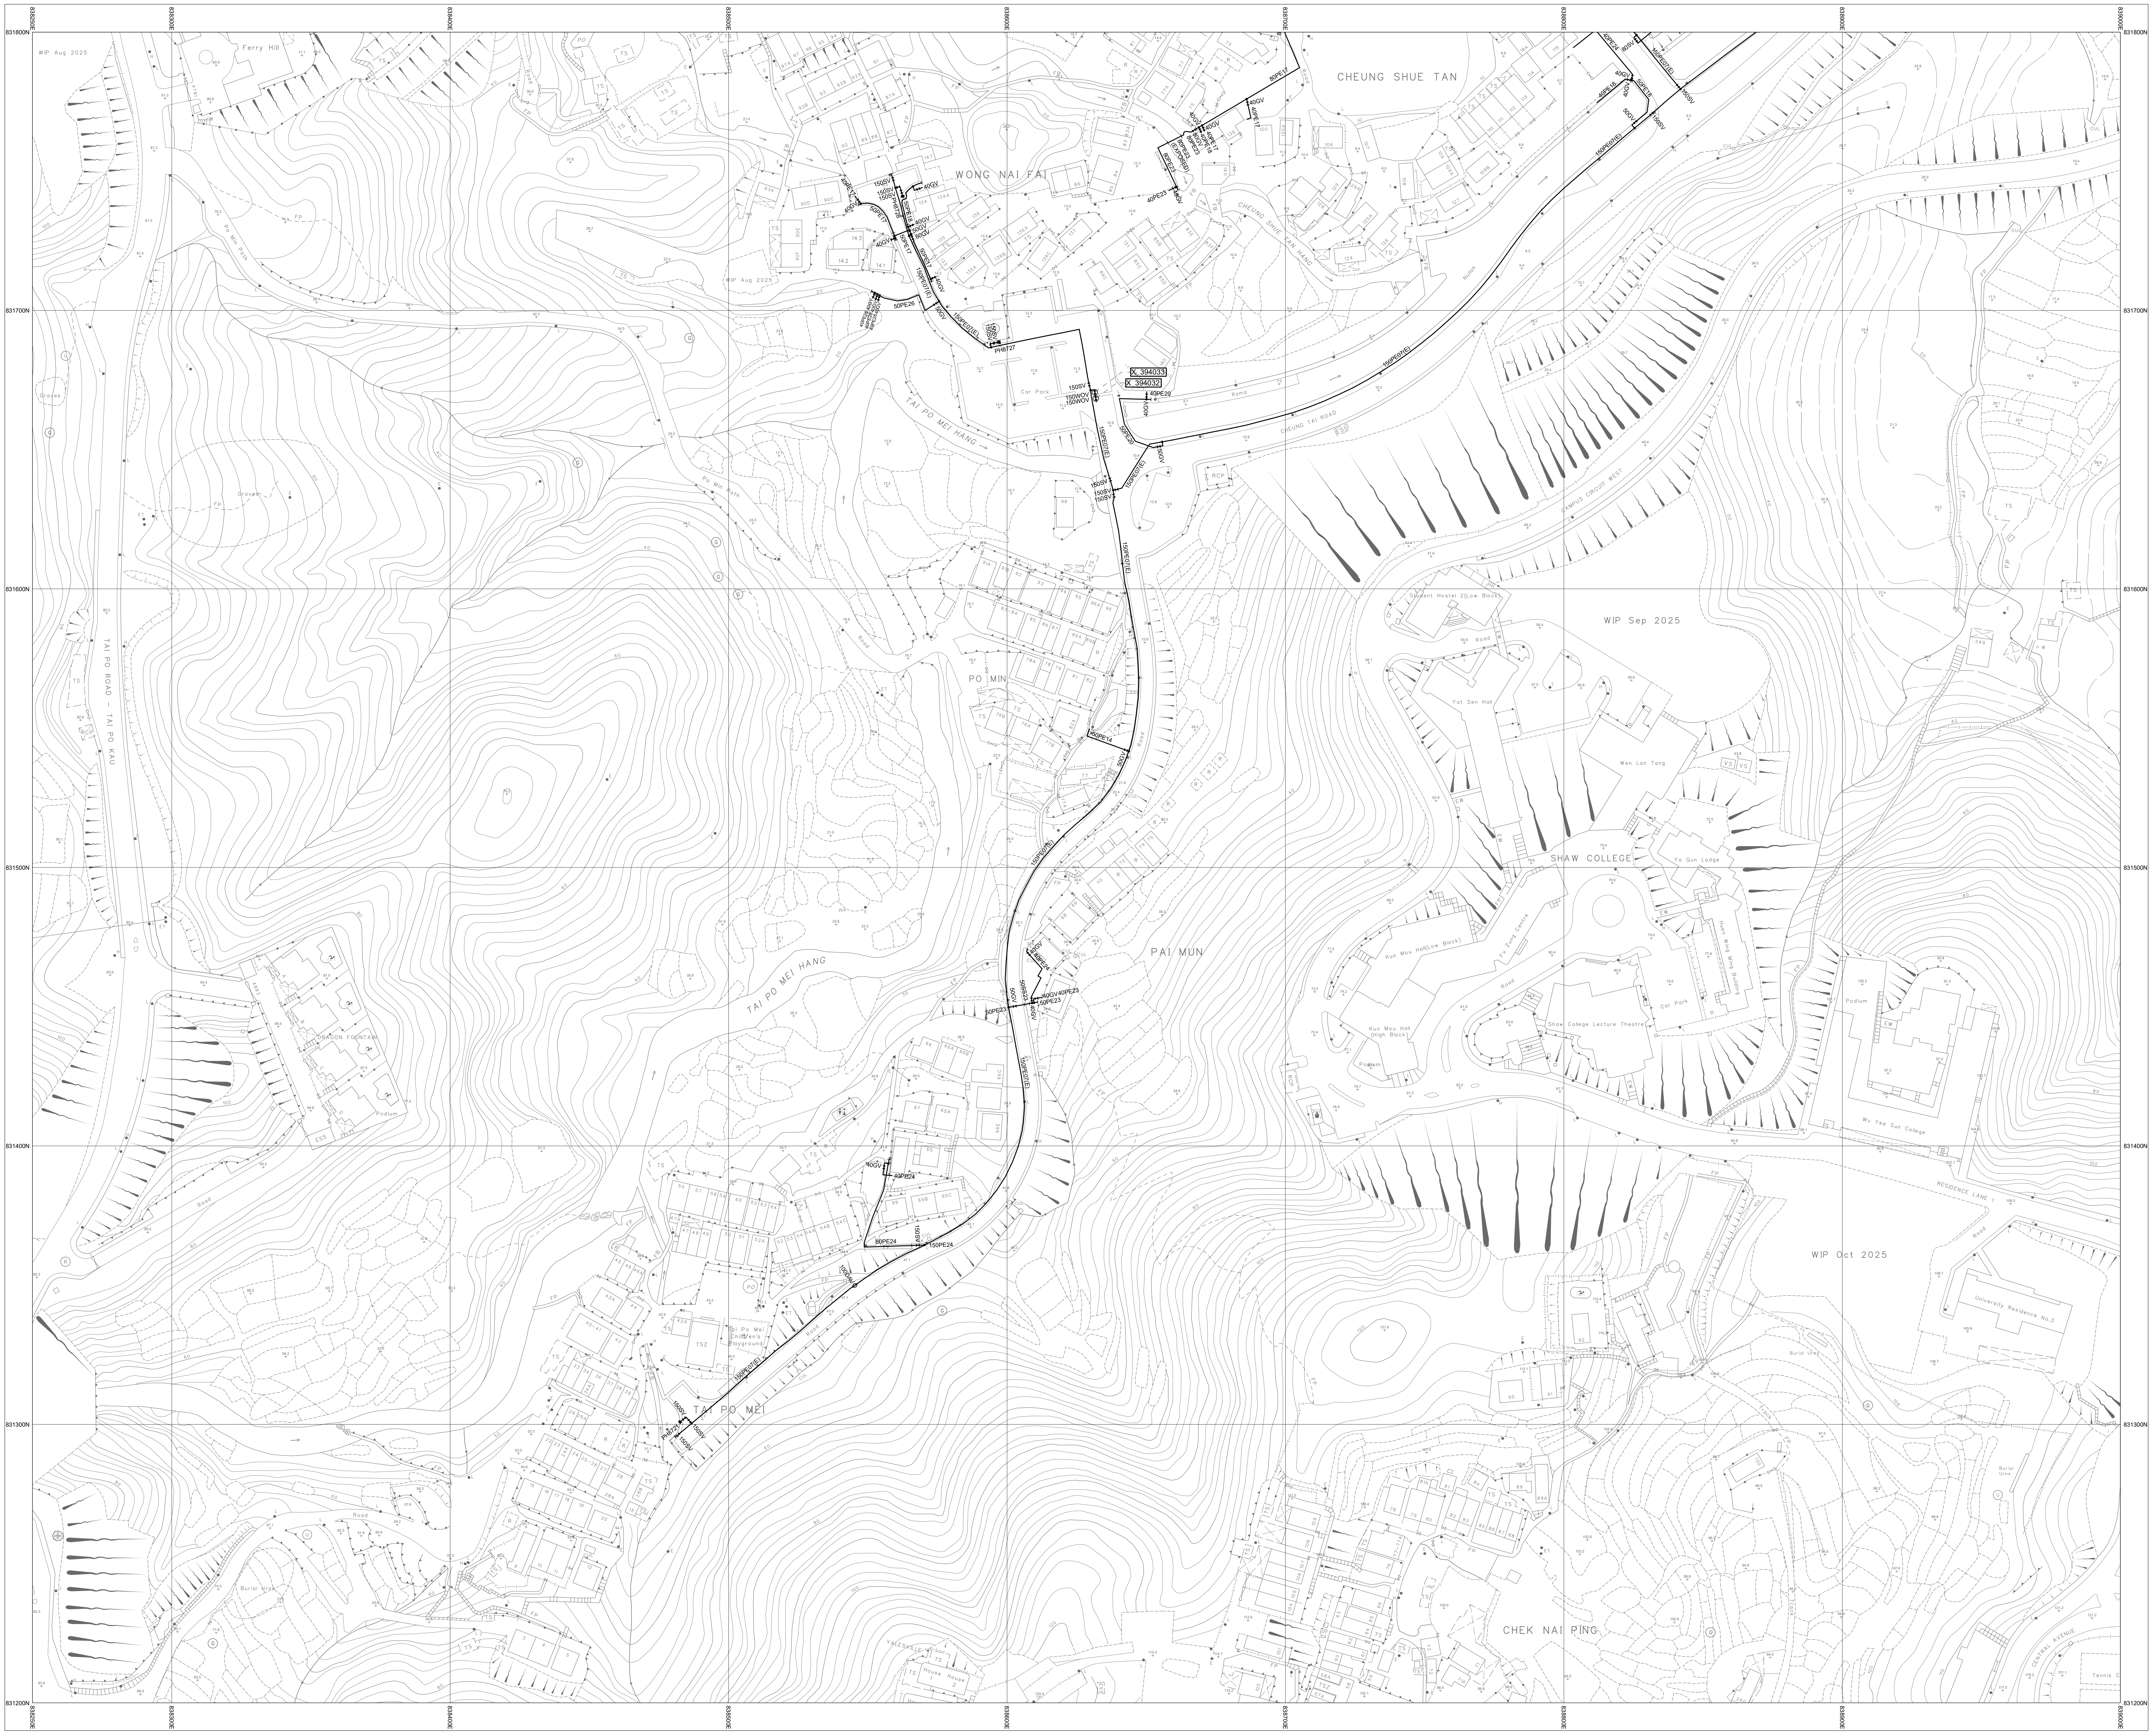

831800N
831700N
831600N
831500N
831400N
831300N
831200N
838250E
838300E
838400E
838500E
838600E
838700E
838800E
838900E
839000E
Ferry Hill
WIP Aug 2025
WONG NAI FAI
CHEUNG SHUE TAN
CHEUNG SHUE TAN HANG
CHEUNG TAI ROAD
CAMPUS CIRCUIT WEST
150PE07(E)
80PE17
40GV
40PE17
40PE18
40PE24
80SV
50PE18
50GV
150SV
X 394032
X 394033
40PE20
PH5727
50PE26
Car Park
TAI PO MEI HANG
TAI PO ROAD - TAI PO KAU
PO MIN
80PE14
PAI MUN
50PE23
80PE23
40PE24
80PE24
150PE24
TAI PO MEI
Sai O Village
WIP Sep 2025
Student Hostel 2(Low Block)
Yat Sen Hall
Wen Lan Tang
SHAW COLLEGE
Yu Qun Lodge
Shaw College Lecture Theatre
Kuo Mou Hall
Podium
Wu Yee Sun College
RESIDENCE LANE
WIP Oct 2025
University Residence No.4
CHEK NAI PING
CENTRAL AVENUE
Tennis C
Burial Urns

7-NE-21B

NOTES:
1. FOR MAINS RECORDS SIGN CONVENTIONS AND DESIGNATIONS SEE SKETCH NO.3988.
2. DIMENSIONS OF MAINS ARE IN MILLIMETRES UNLESS OTHERWISE SPECIFIED.
3. ALL LEVELS ARE IN METRES ABOVE PRINCIPAL DATUM.

Basemap Date Updated On: 05/01/2026

SCALE 1:1 000

METRES 20 10 0 20 40 60 80 100 METRES

THIS IS A COMPUTER PRINTOUT,
NO SIGNATURE IS REQUIRED.

SALT WATER MAINS RECORD PLAN

PO MIN & PAI MUN

COPYRIGHT RESERVED

DATE REVISED : 05/10/2026

SIGNED
S.W. CHAU
CE/NTE
DATE: 20/06/2014

DRAWING NO.
W67881/ 7-NE-16D

Water Supplies Department
HONG KONG

© The Government of the Hong Kong SAR, Map reproduced with permission of the Director of Lands