INSET 'A'	INSET 'B'	INSET 'C'	INSET 'D'	INSET 'E'	INSET 'F'

7-NW-8B

7-NW-8C

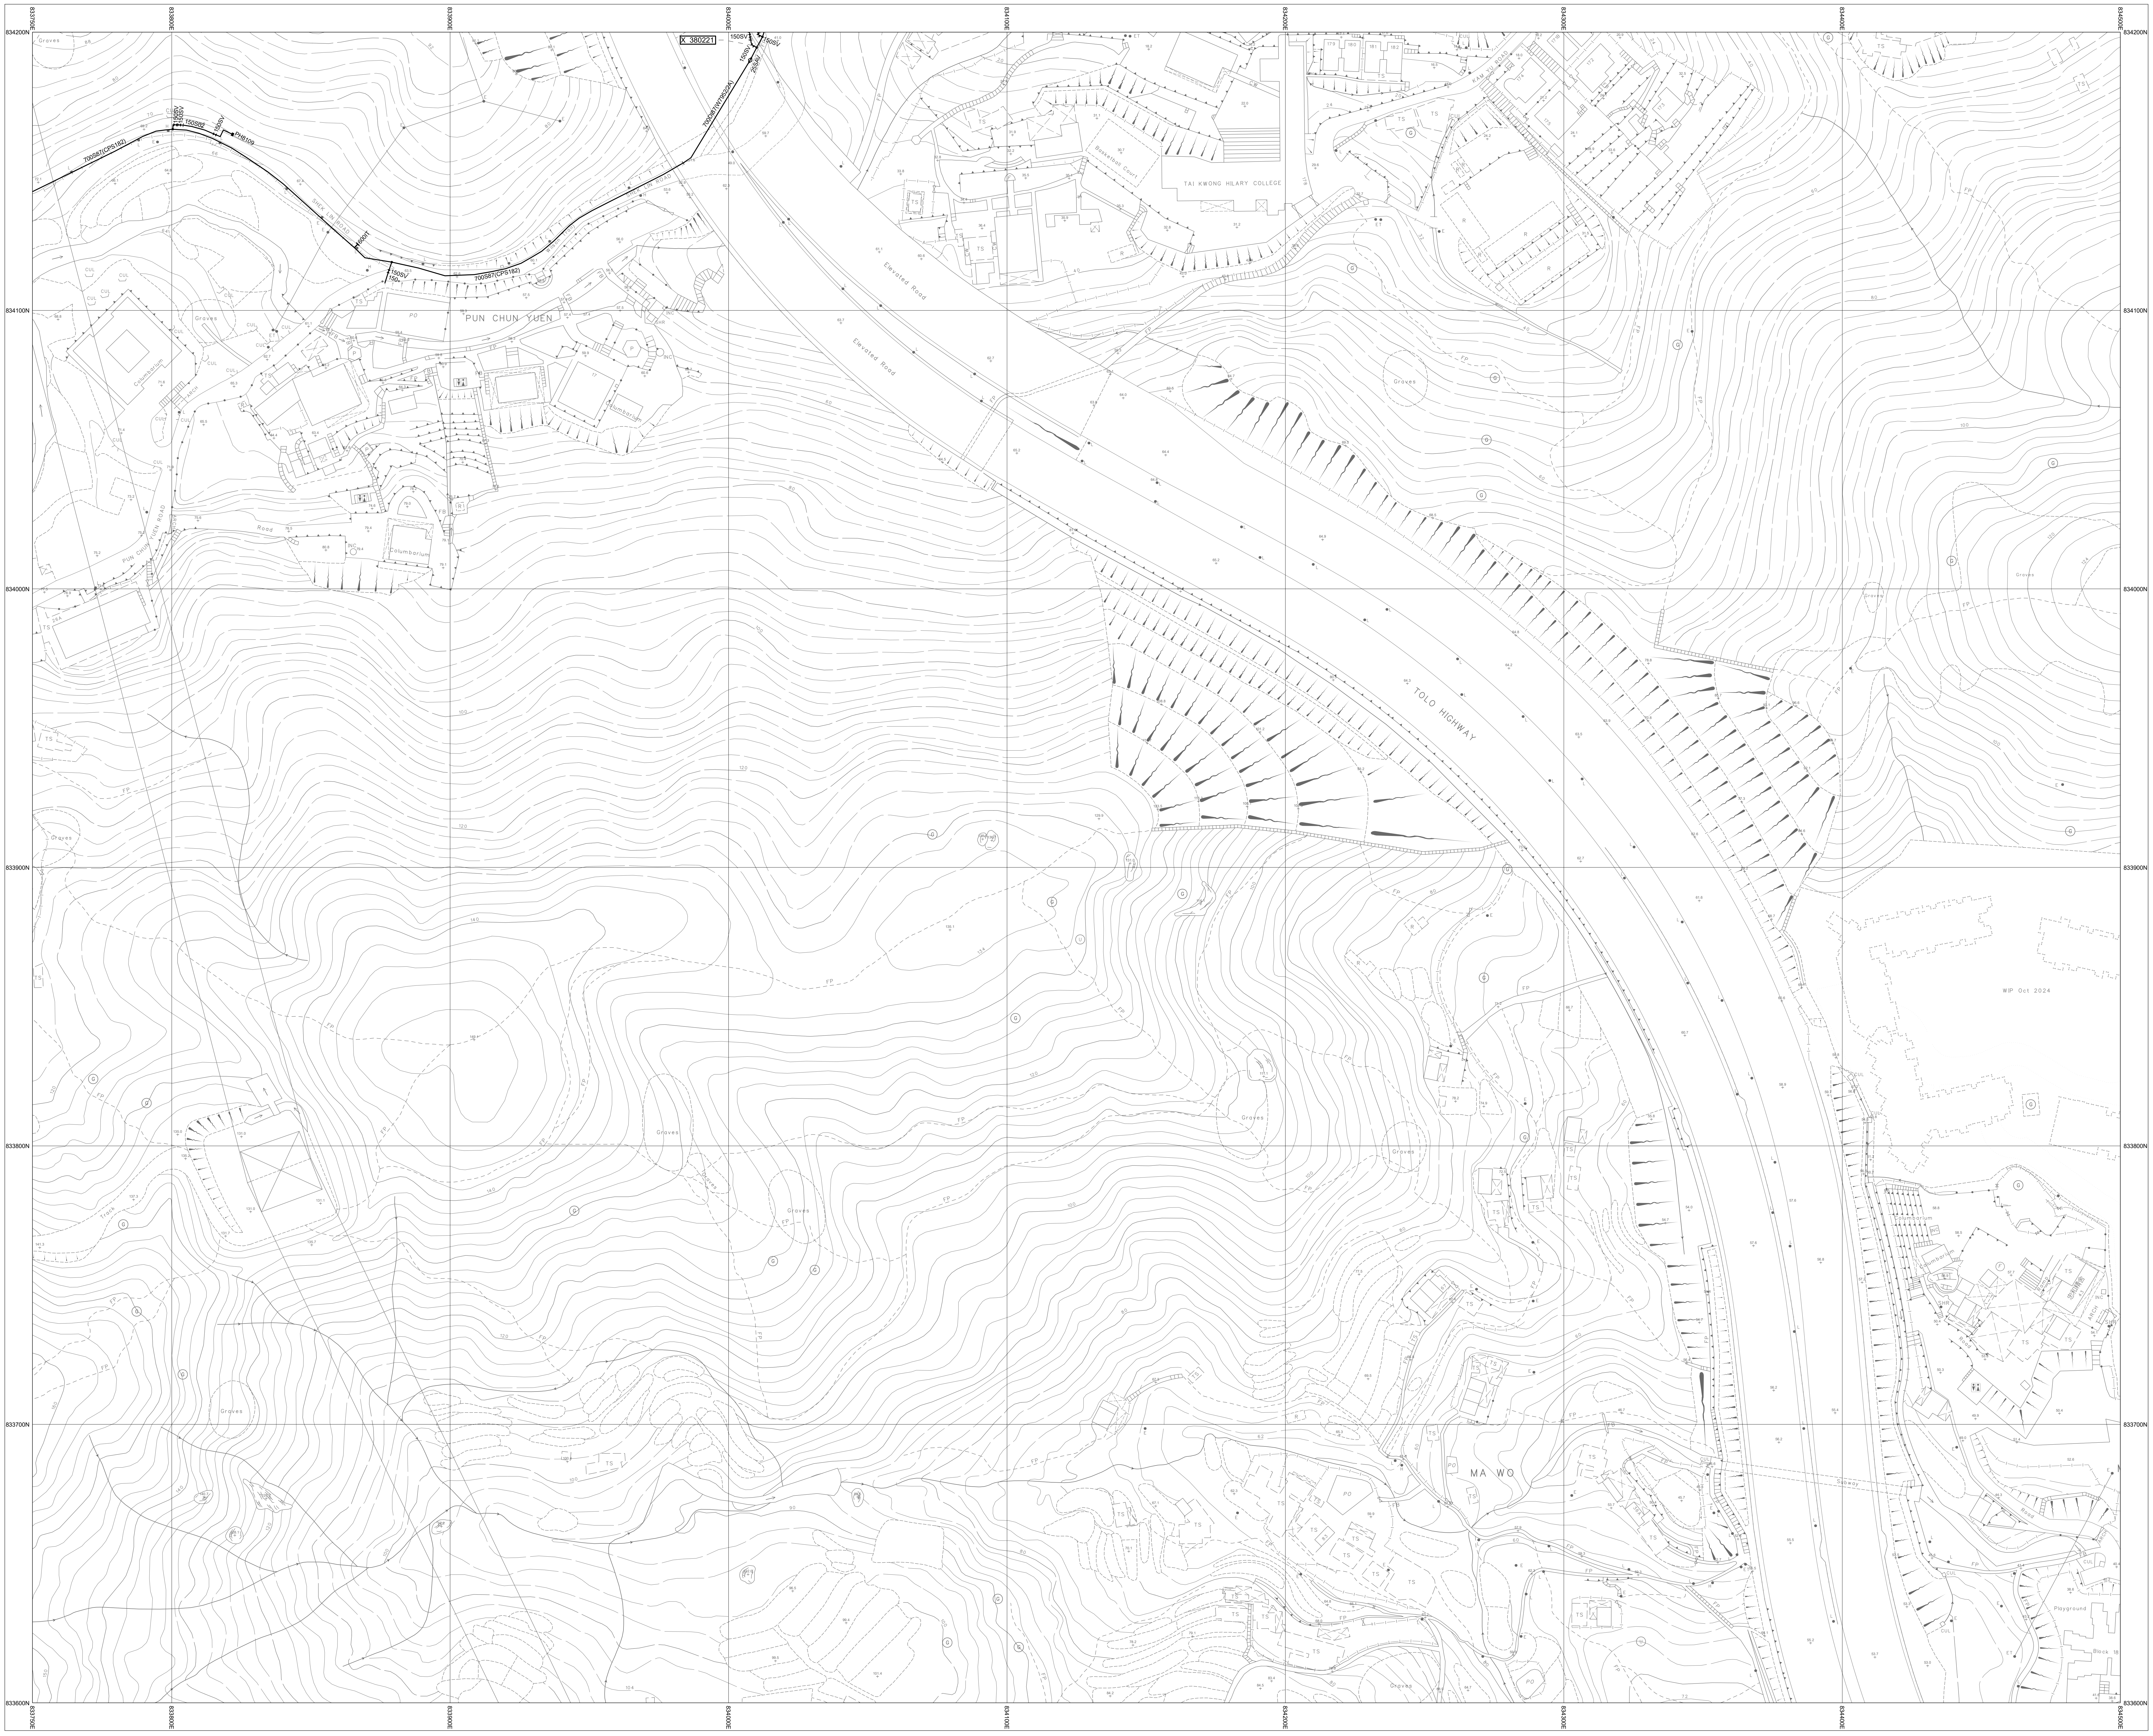
833750E
833800E
833900E
834000E
834100E
834200E
834300E
834400E
834500E
834200N
834100N
834000N
833900N
833800N
833700N
833600N
X 380221
700S87(CPS182)
150SV
150SV
150S02
150SV
PH8109
600IT
150SV
150
700S87(CPS182)
700DI87(W7952/2A)
150SV
150SV
150SV
25SAV
SHEK LIN ROAD
Wilson Trail
PUN CHUN YUEN
Columbarium
Graves
TAI KWONG HILARY COLLEGE
Elevated Road
Elevated Road
TOLO HIGHWAY
MA WO
Playground
Block 18
WIP Oct 2024

7-NW-9C

7-NW-13B

NOTES:

1. FOR MAINS RECORDS SIGN CONVENTIONS AND DESIGNATIONS SEE SKETCH NO.3988.
2. DIMENSIONS OF MAINS ARE IN MILLIMETRES UNLESS OTHERWISE SPECIFIED.
3. ALL LEVELS ARE IN METRES ABOVE PRINCIPAL DATUM.

Basemap Date Updated On: 23/12/2024

SCALE 1:1 000

METRES 20 10 0 20 40 60 80 100 METRES

THIS IS A COMPUTER PRINTOUT,
NO SIGNATURE IS REQUIRED.

SALT WATER MAINS RECORD PLAN

TOLO HIGHWAY, MA WO

COPYRIGHT RESERVED

DATE REVISED : 30/12/2024

SIGNED

C.S. CHIN
CE/MNE
DATE: 06/05/1999

DRAWING NO.

W67881/ 7-NW-8D

Water Supplies Department
HONG KONG

© The Government of the Hong Kong SAR, Map reproduced with permission of the Director of Lands