INSET 'A'	INSET 'B'	INSET 'C'	INSET 'D'	INSET 'E'	INSET 'F'

7-NW-4C

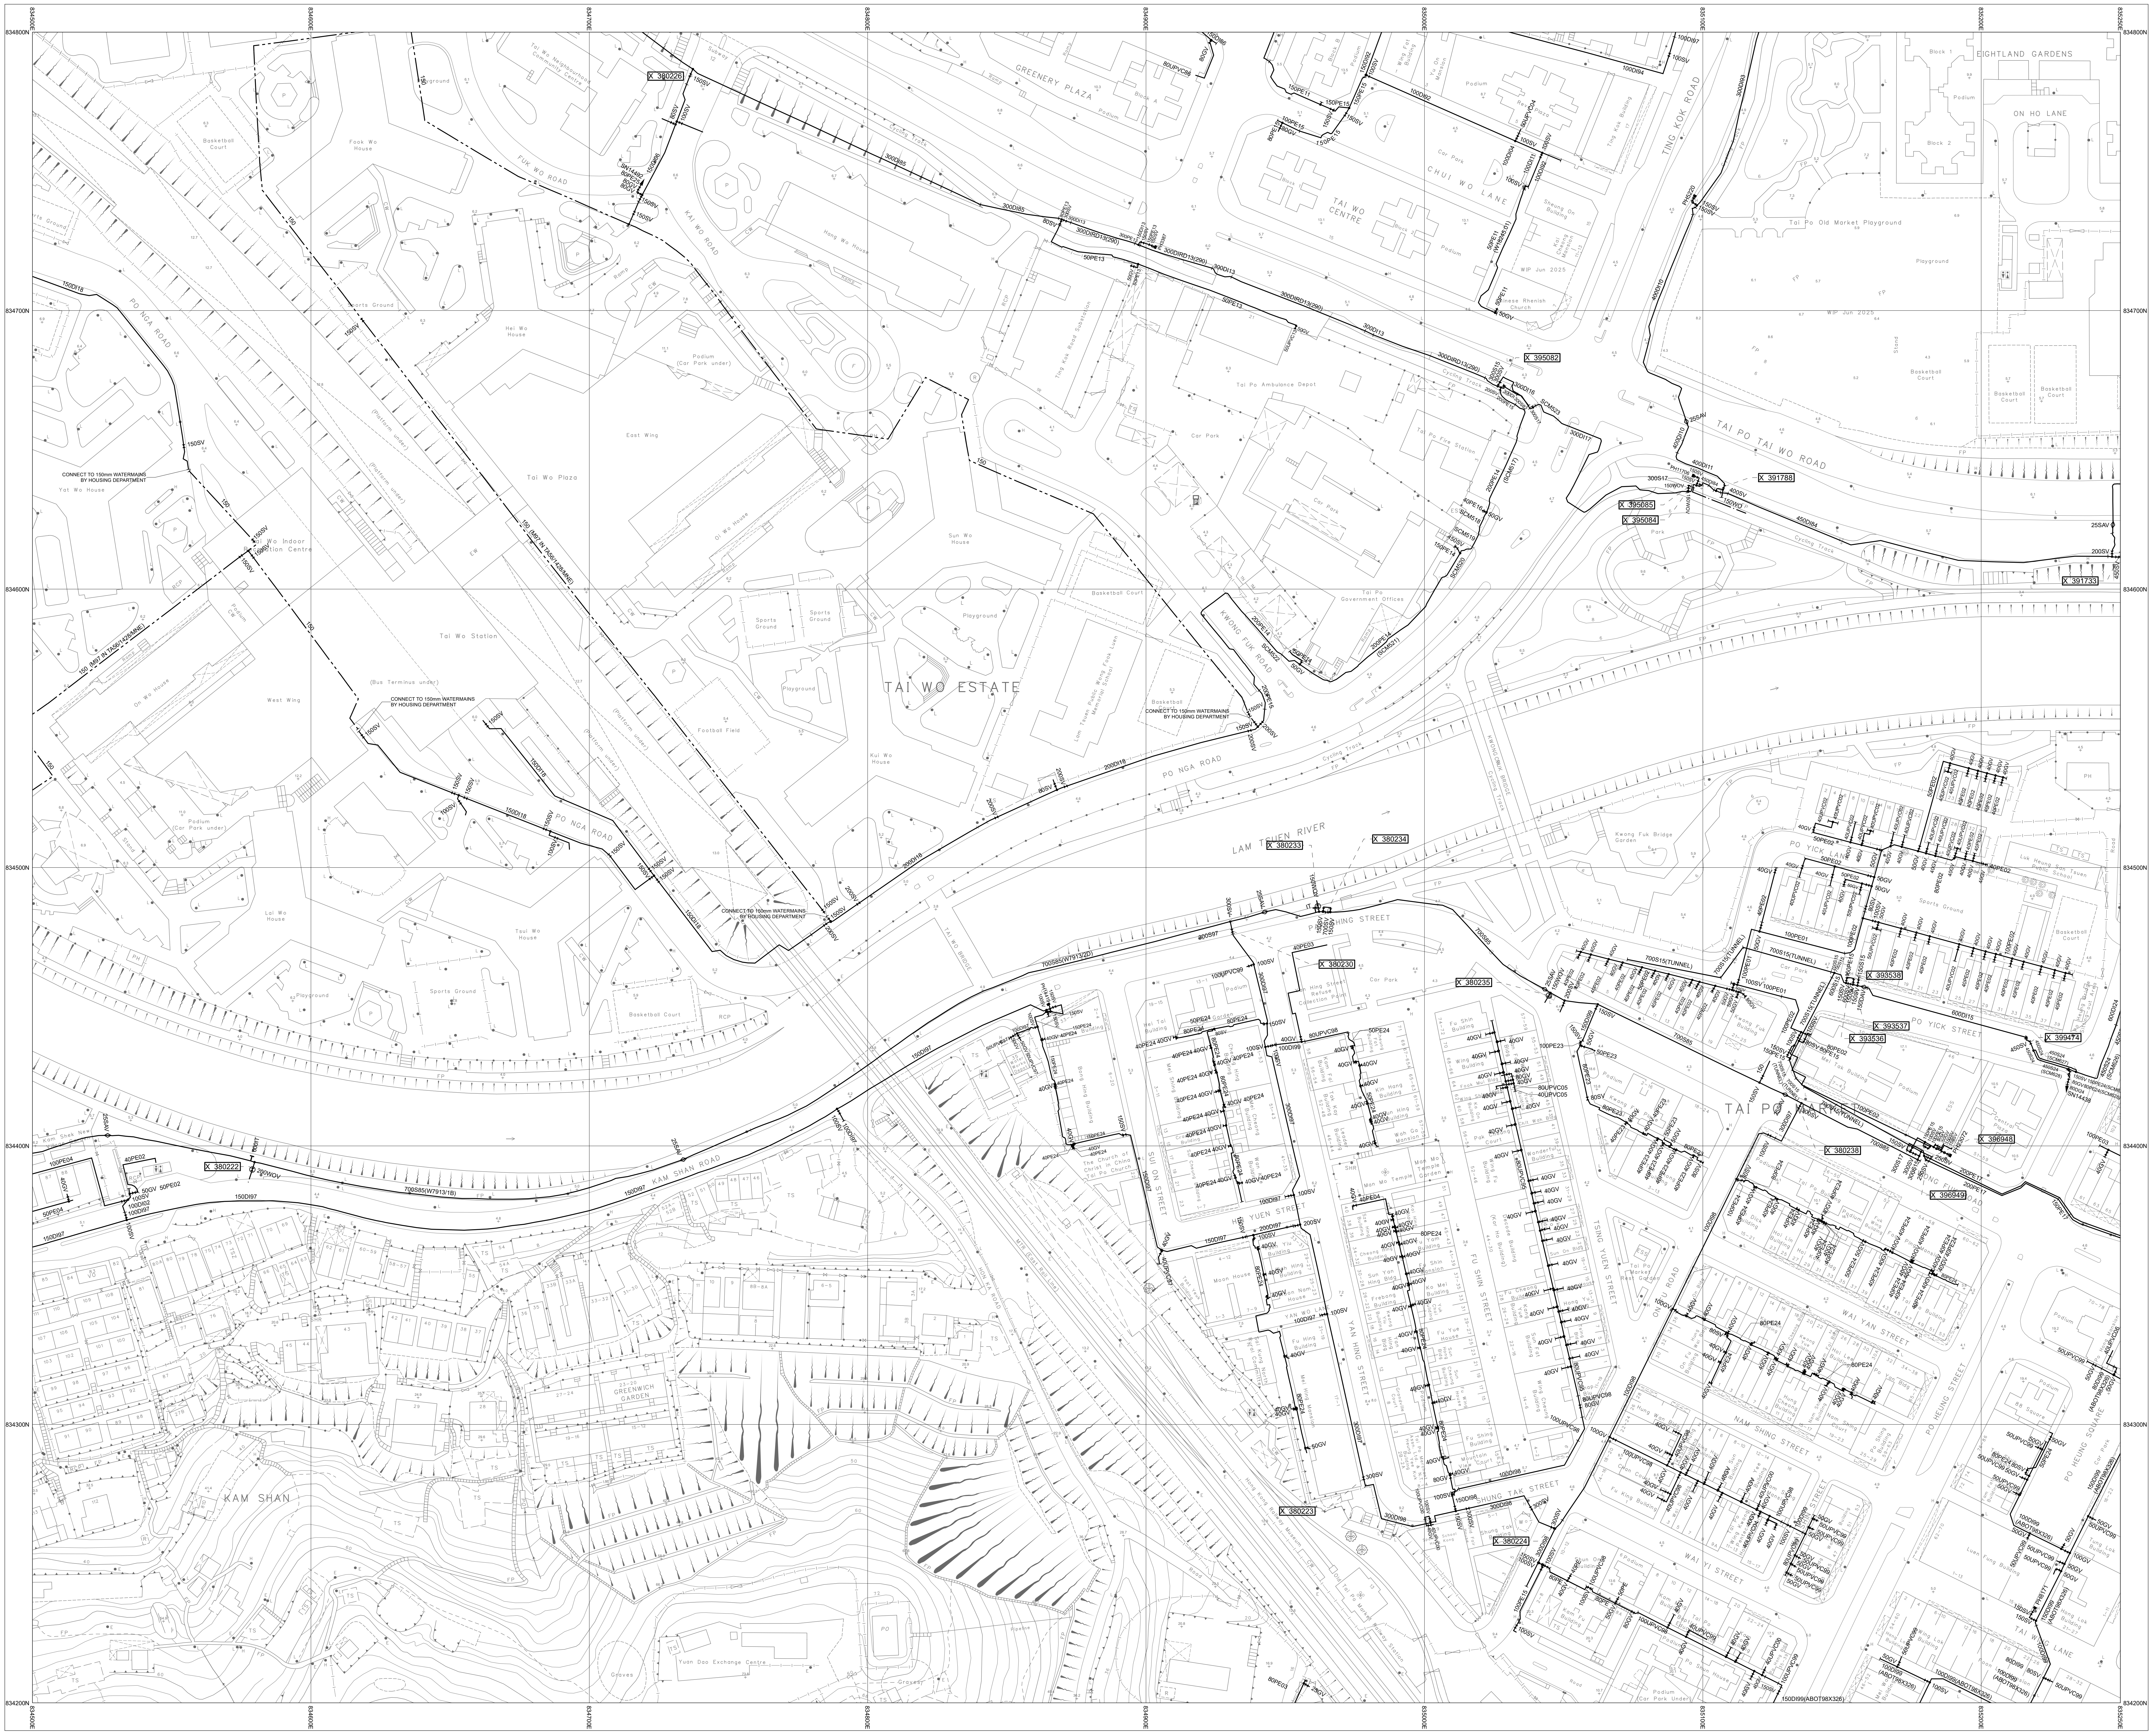
7-NW-8B
7-NW-9B
TAI WO ESTATE
TAI WO CENTRE
EIGHTLAND GARDENS
GREENERY PLAZA
PO NGA ROAD
KAM SHAN ROAD
TAI PO TAI WO ROAD
TING KOK ROAD
KWONG FUK ROAD
LAM TSUEN RIVER
PO YICK STREET
KAM SHAN
GREENWICH GARDEN
WAI YAN STREET
NAM SHING STREET
WAI YI STREET
SUI ON STREET
FU SHIN STREET
TSING YUEN STREET
KWONG FUK BRIDGE
Tai Wo Station
Tai Wo Plaza
CONNECT TO 150mm WATERMAINS BY HOUSING DEPARTMENT
834800N
834700N
834600N
834500N
834400N
834300N
834200N
834500E
834600E

7-NW-9C

NOTES:

1. FOR MAINS RECORDS SIGN CONVENTIONS AND DESIGNATIONS SEE SKETCH NO.3988.
2. DIMENSIONS OF MAINS ARE IN MILLIMETRES UNLESS OTHERWISE SPECIFIED.
3. ALL LEVELS ARE IN METRES ABOVE PRINCIPAL DATUM.

Basemap Date Updated On: 05/01/2026

SCALE 1:1 000

METRES 20 10 0 20 40 60 80 100 METRES

THIS IS A COMPUTER PRINTOUT, NO SIGNATURE IS REQUIRED.

SALT WATER MAINS RECORD PLAN

KAM SHAN ROAD, TAI PO MARKET

COPYRIGHT RESERVED

DATE REVISED : 14/08/2026

DRAWING NO.

W67881/ 7-NW-9A

SIGNED

C.S. CHIN
CE/MNE

DATE: 06/05/1999

Water Supplies Department
HONG KONG

© The Government of the Hong Kong SAR, Map reproduced with permission of the Director of Lands