INSET 'A'

INSET 'B'

INSET 'C'

INSET 'D'

INSET 'E'

INSET 'F'

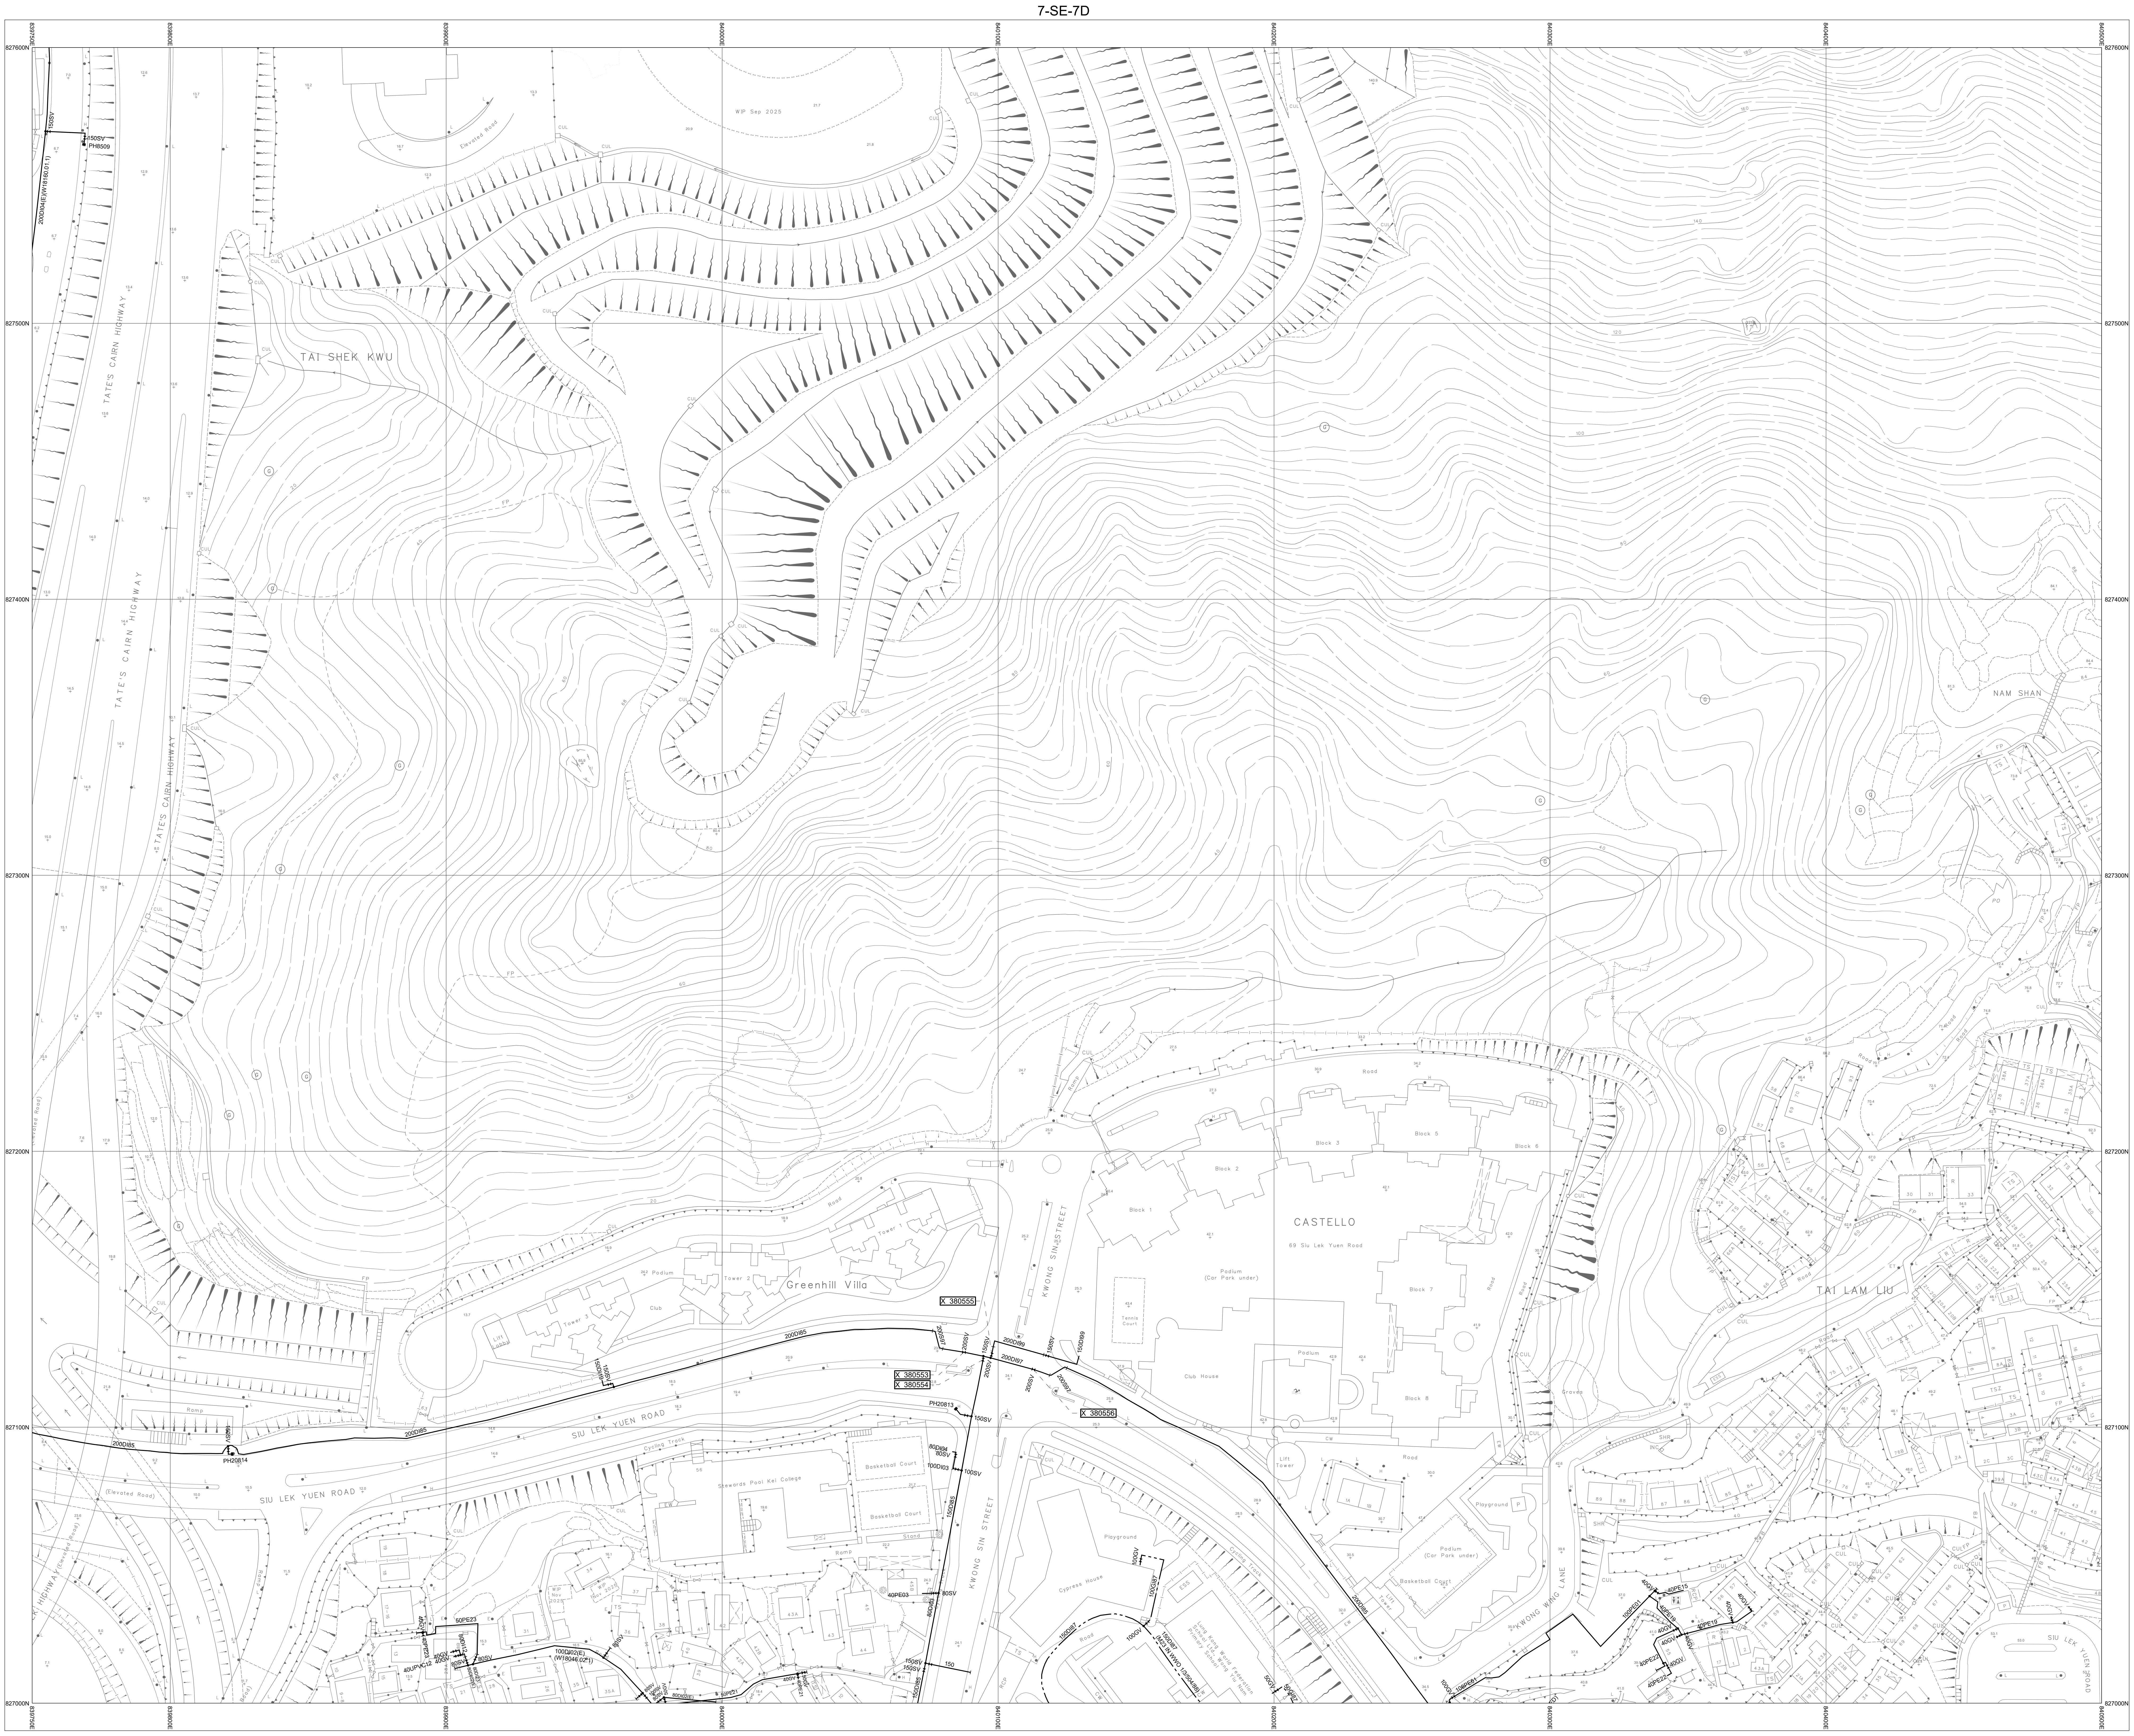
7-SE-7D
7-SE-12A
7-SE-13A
7-SE-12D
TAI SHEK KWU
TATE'S CAIRN HIGHWAY
CASTELLO
Greenhill Villa
SIU LEK YUEN ROAD
KWONG SIN STREET
KWONG WING LANE
TAI LAM LIU
NAM SHAN
827600N
827500N
827400N
827300N
827200N
827100N
827000N
839750E
839800E
839900E
840000E
840100E
840200E
840300E
840400E
840500E

NOTES:

1. FOR MAINS RECORDS SIGN CONVENTIONS AND DESIGNATIONS SEE SKETCH NO.3988.
2. DIMENSIONS OF MAINS ARE IN MILLIMETRES UNLESS OTHERWISE SPECIFIED.
3. ALL LEVELS ARE IN METRES ABOVE PRINCIPAL DATUM.

Basemap Date Updated On: 05/01/2026

SCALE 1:1 000

METRES 20 10 0 20 40 60 80 100 METRES

THIS IS A COMPUTER PRINTOUT,
NO SIGNATURE IS REQUIRED.

SALT WATER MAINS RECORD PLAN

SIU LEK YUEN, TAI LAM LIU

COPYRIGHT RESERVED

DATE REVISED : 04/09/2026

SIGNED C.S. CHIN
CE/MNE
DATE: 06/05/1999

DRAWING NO.
W67881/ 7-SE-12B

Water Supplies Department
HONG KONG

© The Government of the Hong Kong SAR, Map reproduced with permission of the Director of Lands