INSET 'A'	INSET 'B'	INSET 'C'	INSET 'D'	INSET 'E'	INSET 'F'

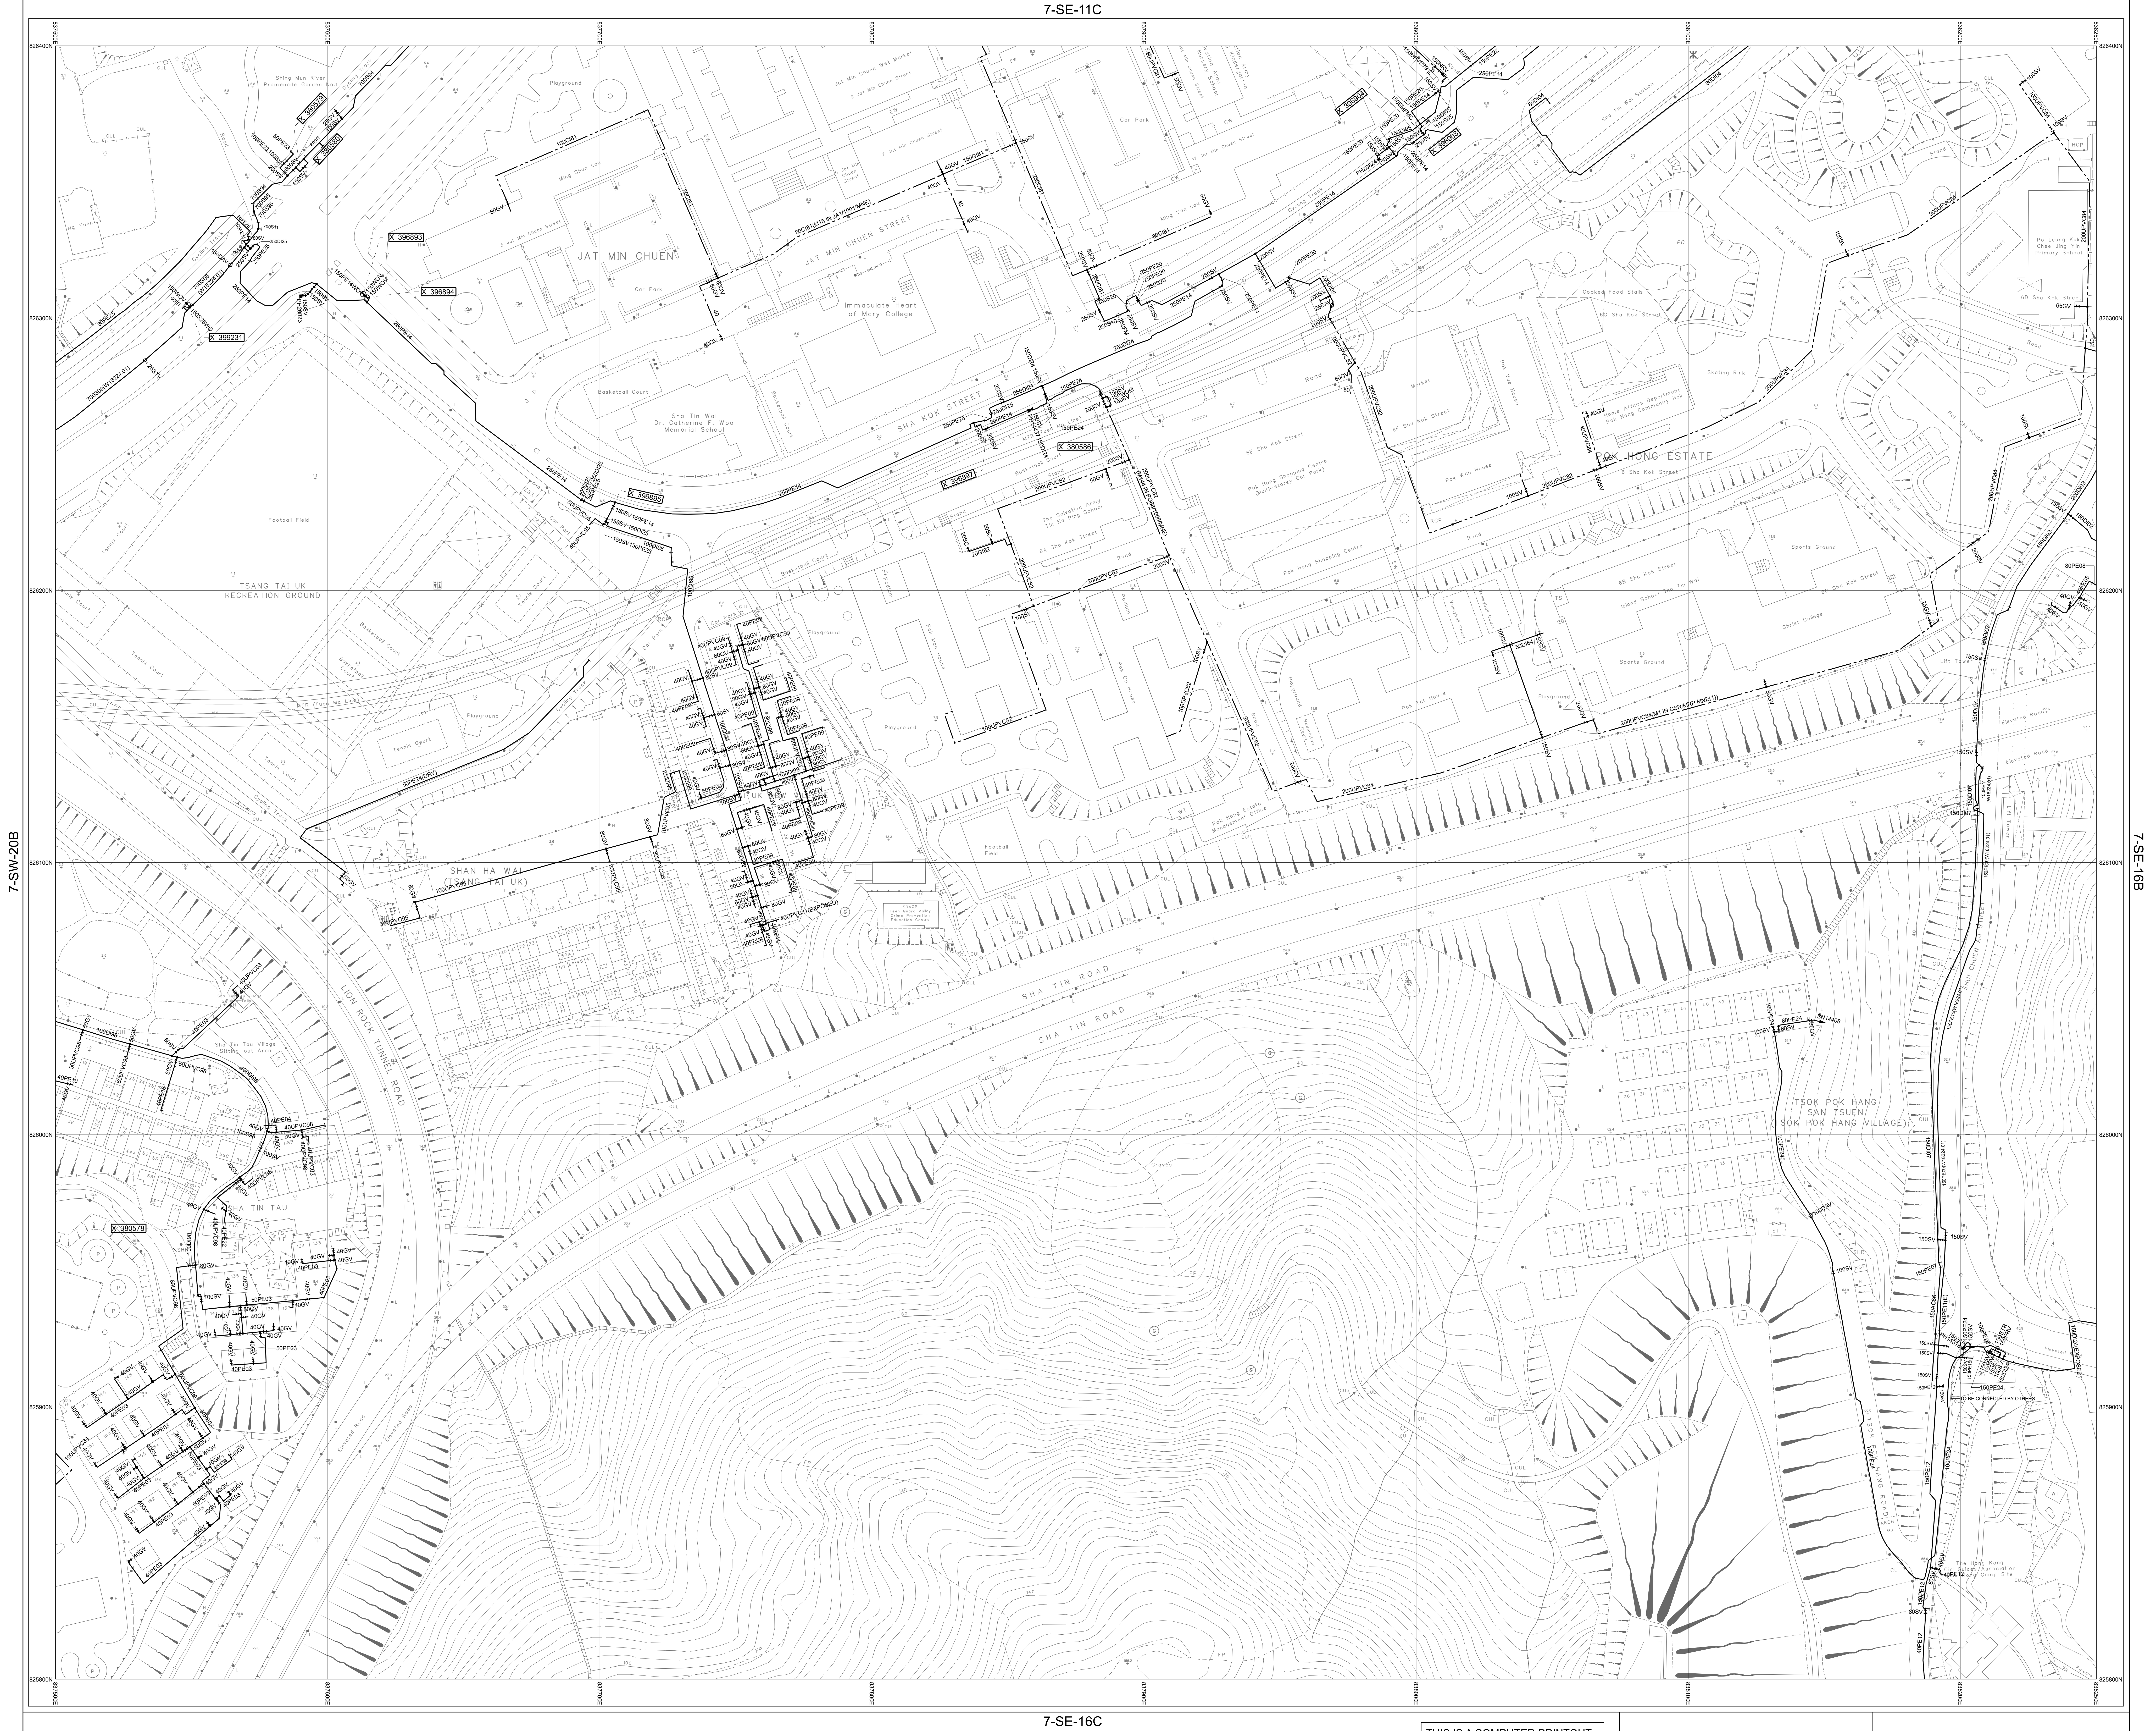

7-SE-11C
7-SW-20B
7-SE-16B
7-SE-16C
JAT MIN CHUEN
JAT MIN CHUEN STREET
Immaculate Heart of Mary College
Sha Tin Wai Dr. Catherine F. Woo Memorial School
SHA KOK STREET
POK HONG ESTATE
TSANG TAI UK RECREATION GROUND
SHAN HA WAI (TSANG TAI UK)
LION ROCK TUNNEL ROAD
SHA TIN ROAD
SHA TIN TAU
TSOK POK HANG SAN TSUEN (TSOK POK HANG VILLAGE)

NOTES:

1. FOR MAINS RECORDS SIGN CONVENTIONS AND DESIGNATIONS SEE SKETCH NO.3988.
2. DIMENSIONS OF MAINS ARE IN MILLIMETRES UNLESS OTHERWISE SPECIFIED.
3. ALL LEVELS ARE IN METRES ABOVE PRINCIPAL DATUM.

Basemap Data Updated On: 05/01/2026

SCALE 1:1 000

METRES 20 10 0 20 40 60 80 100 METRES

THIS IS A COMPUTER PRINTOUT,
NO SIGNATURE IS REQUIRED.

SALT WATER MAINS RECORD PLAN

SHA TIN ROAD, POK HONG ESTATE

COPYRIGHT RESERVED

DATE REVISED : 05/10/2026

SIGNED C.S. CHIN
CE/MNE
DATE: 06/05/1999

DRAWING NO.
W67881/ 7-SE-16A

Water Supplies Department
HONG KONG

© The Government of the Hong Kong SAR, Map reproduced with permission of the Director of Lands