INSET 'A'	INSET 'B'	INSET 'C'	INSET 'D'	INSET 'E'	INSET 'F'

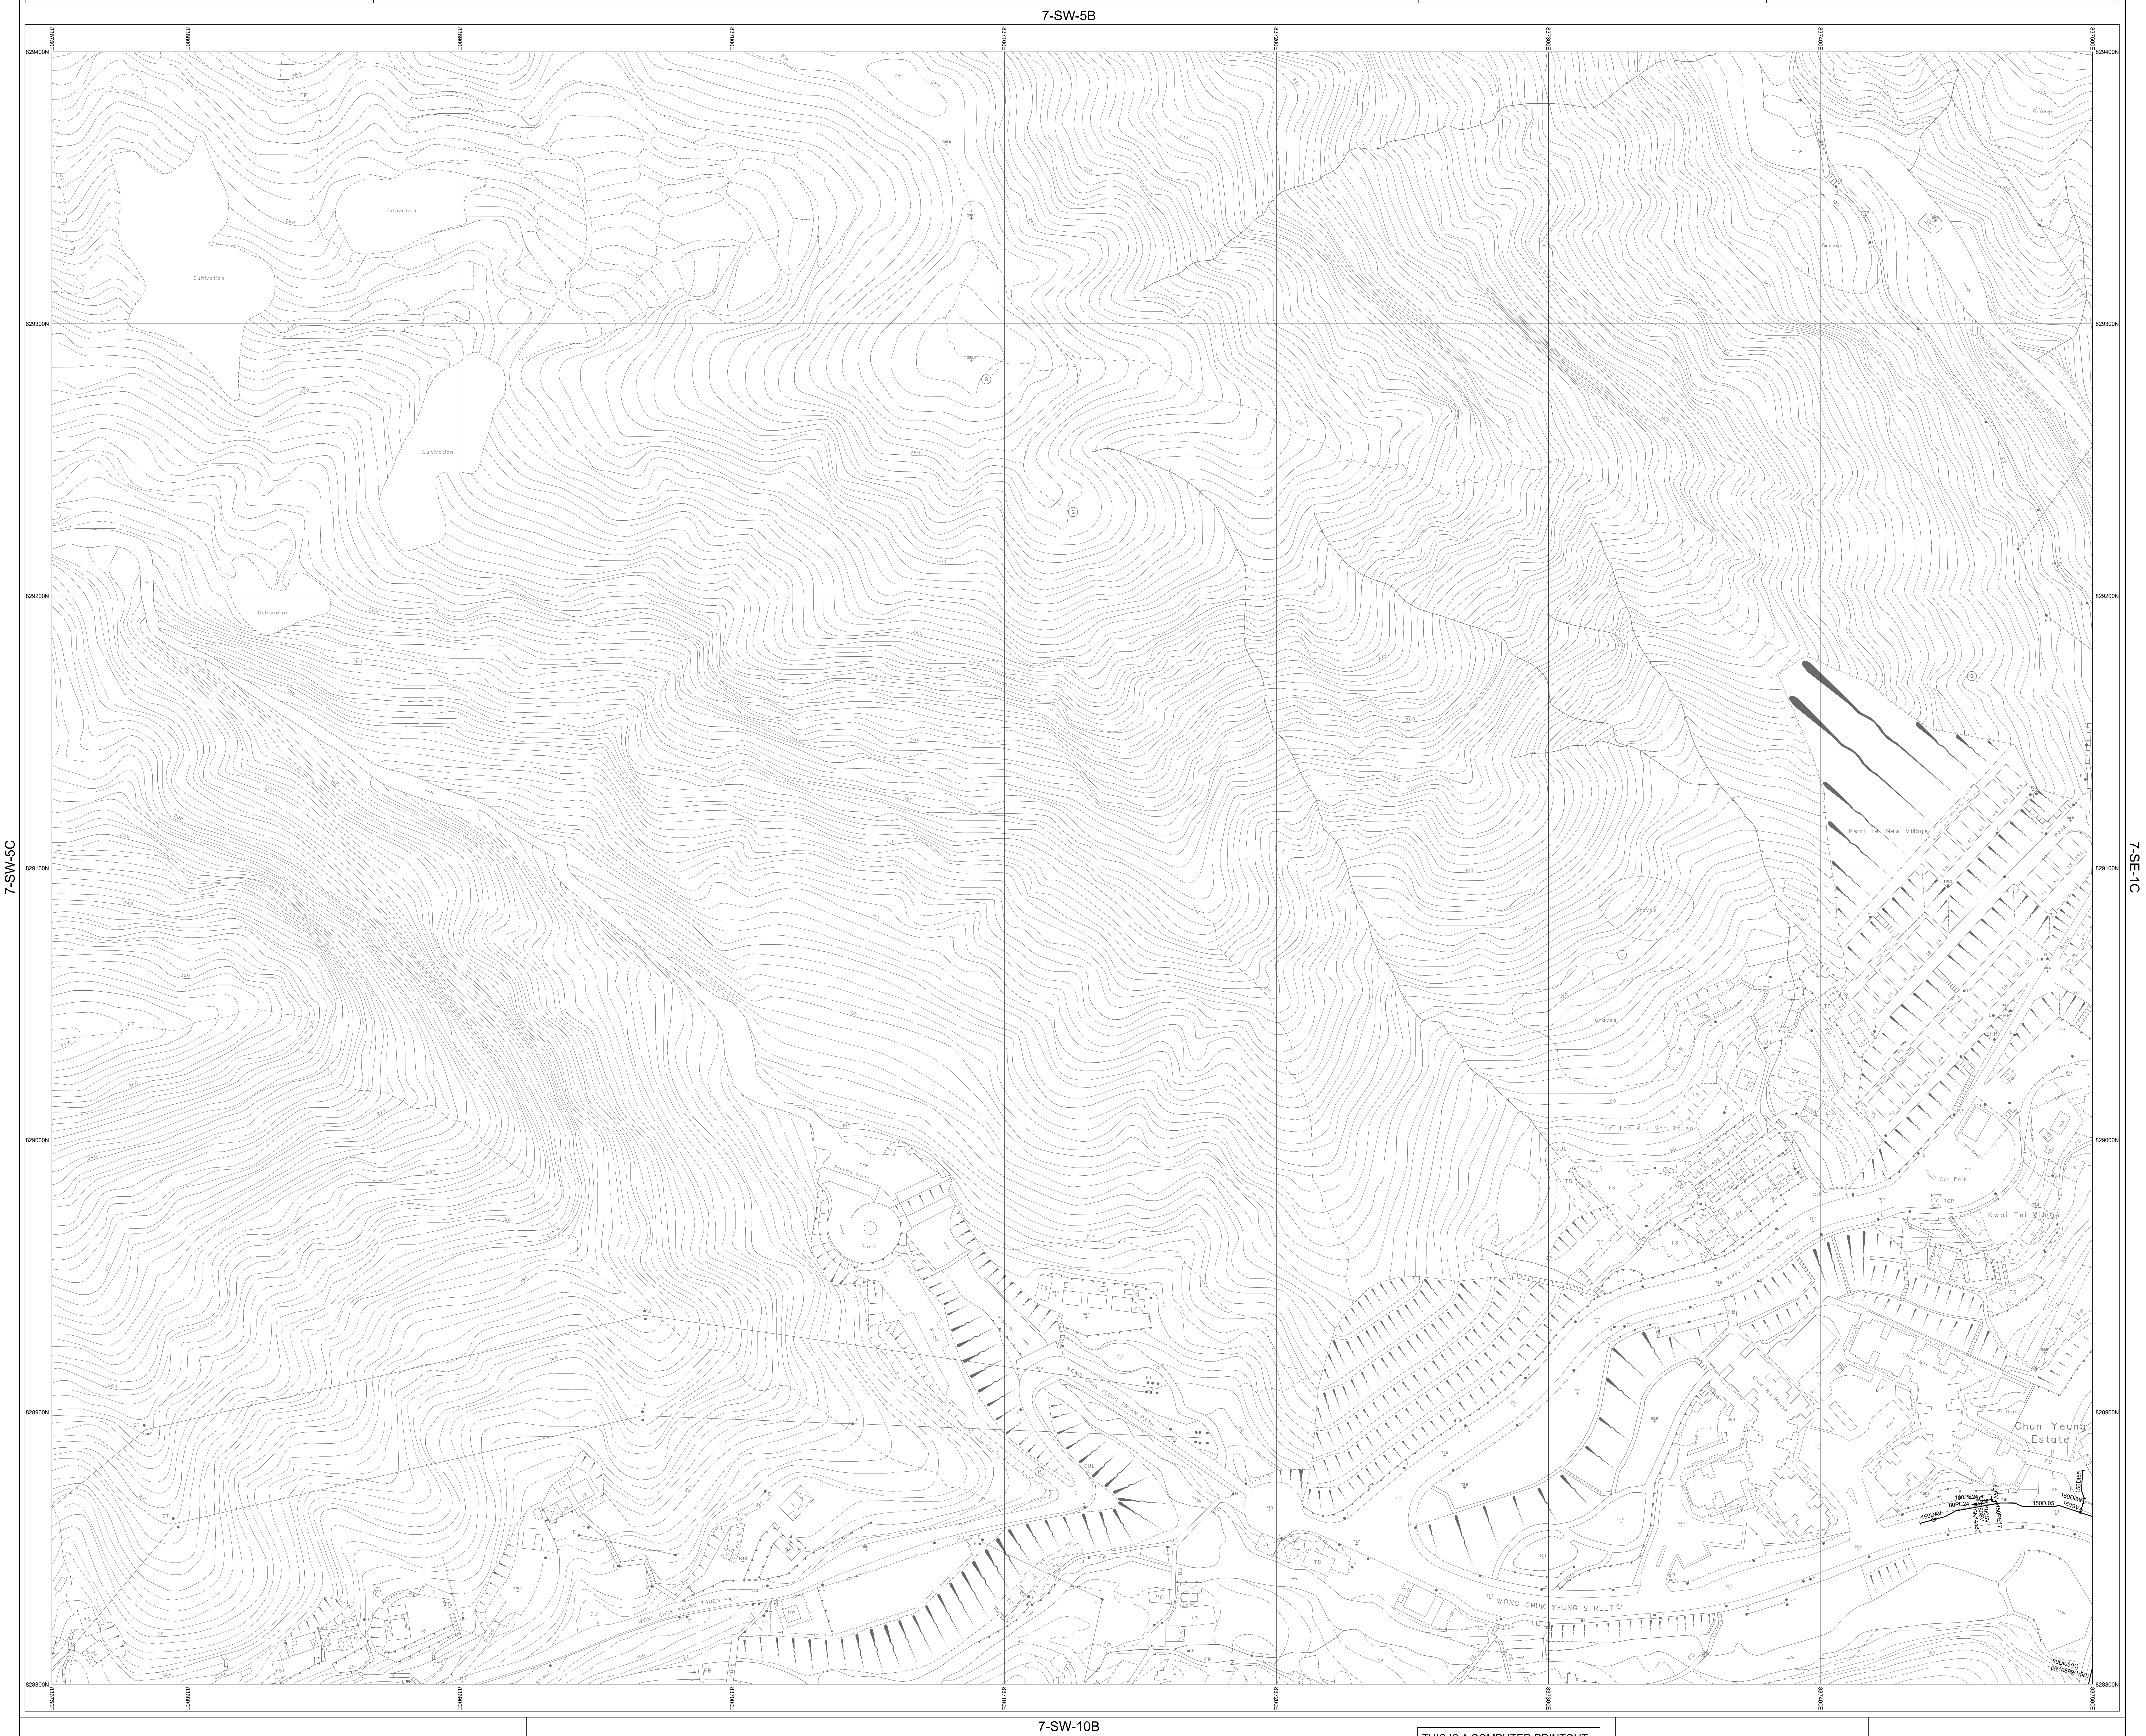
7-SW-5B
7-SW-5C
7-SE-1C
7-SW-10B
829400N
829300N
829200N
829100N
829000N
828900N
828800N
836750E
836800E
836900E
837000E
837100E
837200E
837300E
837400E
837500E
Cultivation
Graves
Kwei Tei New Village
Fo Tan Kuk San Tsuen
Kwei Tei Village
Car Park
KWEI TEI SAN CHUEN ROAD
WONG CHUK YEUNG TSUEN PATH
WONG CHUK YEUNG STREET
Chun Sze House
Chun Yeung Estate
Podium
FB
CUL
150DI85
150DI09
150SV
150DI05
150GV
100PE24
80PE24
100SV
80SV
SN14480
150PE17
150DAV
80DI05(R)
(W10899/1/5B)

NOTES:
1. FOR MAINS RECORDS SIGN CONVENTIONS AND DESIGNATIONS SEE SKETCH NO.3988.
2. DIMENSIONS OF MAINS ARE IN MILLIMETRES UNLESS OTHERWISE SPECIFIED.
3. ALL LEVELS ARE IN METRES ABOVE PRINCIPAL DATUM.

Basemap Date Updated On: 05/01/2026

SCALE 1:1 000

METRES 20 10 0 20 40 60 80 100 METRES

THIS IS A COMPUTER PRINTOUT,
NO SIGNATURE IS REQUIRED.

SALT WATER MAINS RECORD PLAN

KWEI TEI SAN CHUEN ROAD, FO TAN

COPYRIGHT RESERVED

DATE REVISED : 05/10/2026

SIGNED
C.S. CHIN
CE/MNE
DATE: 06/05/1999

DRAWING NO.
W67881/ 7-SW-5D

Water Supplies Department
HONG KONG

© The Government of the Hong Kong SAR, Map reproduced with permission of the Director of Lands