
INSET 'A'	INSET 'B'	INSET 'C'	INSET 'D'	INSET 'E'	INSET 'F'

7-SW-22B

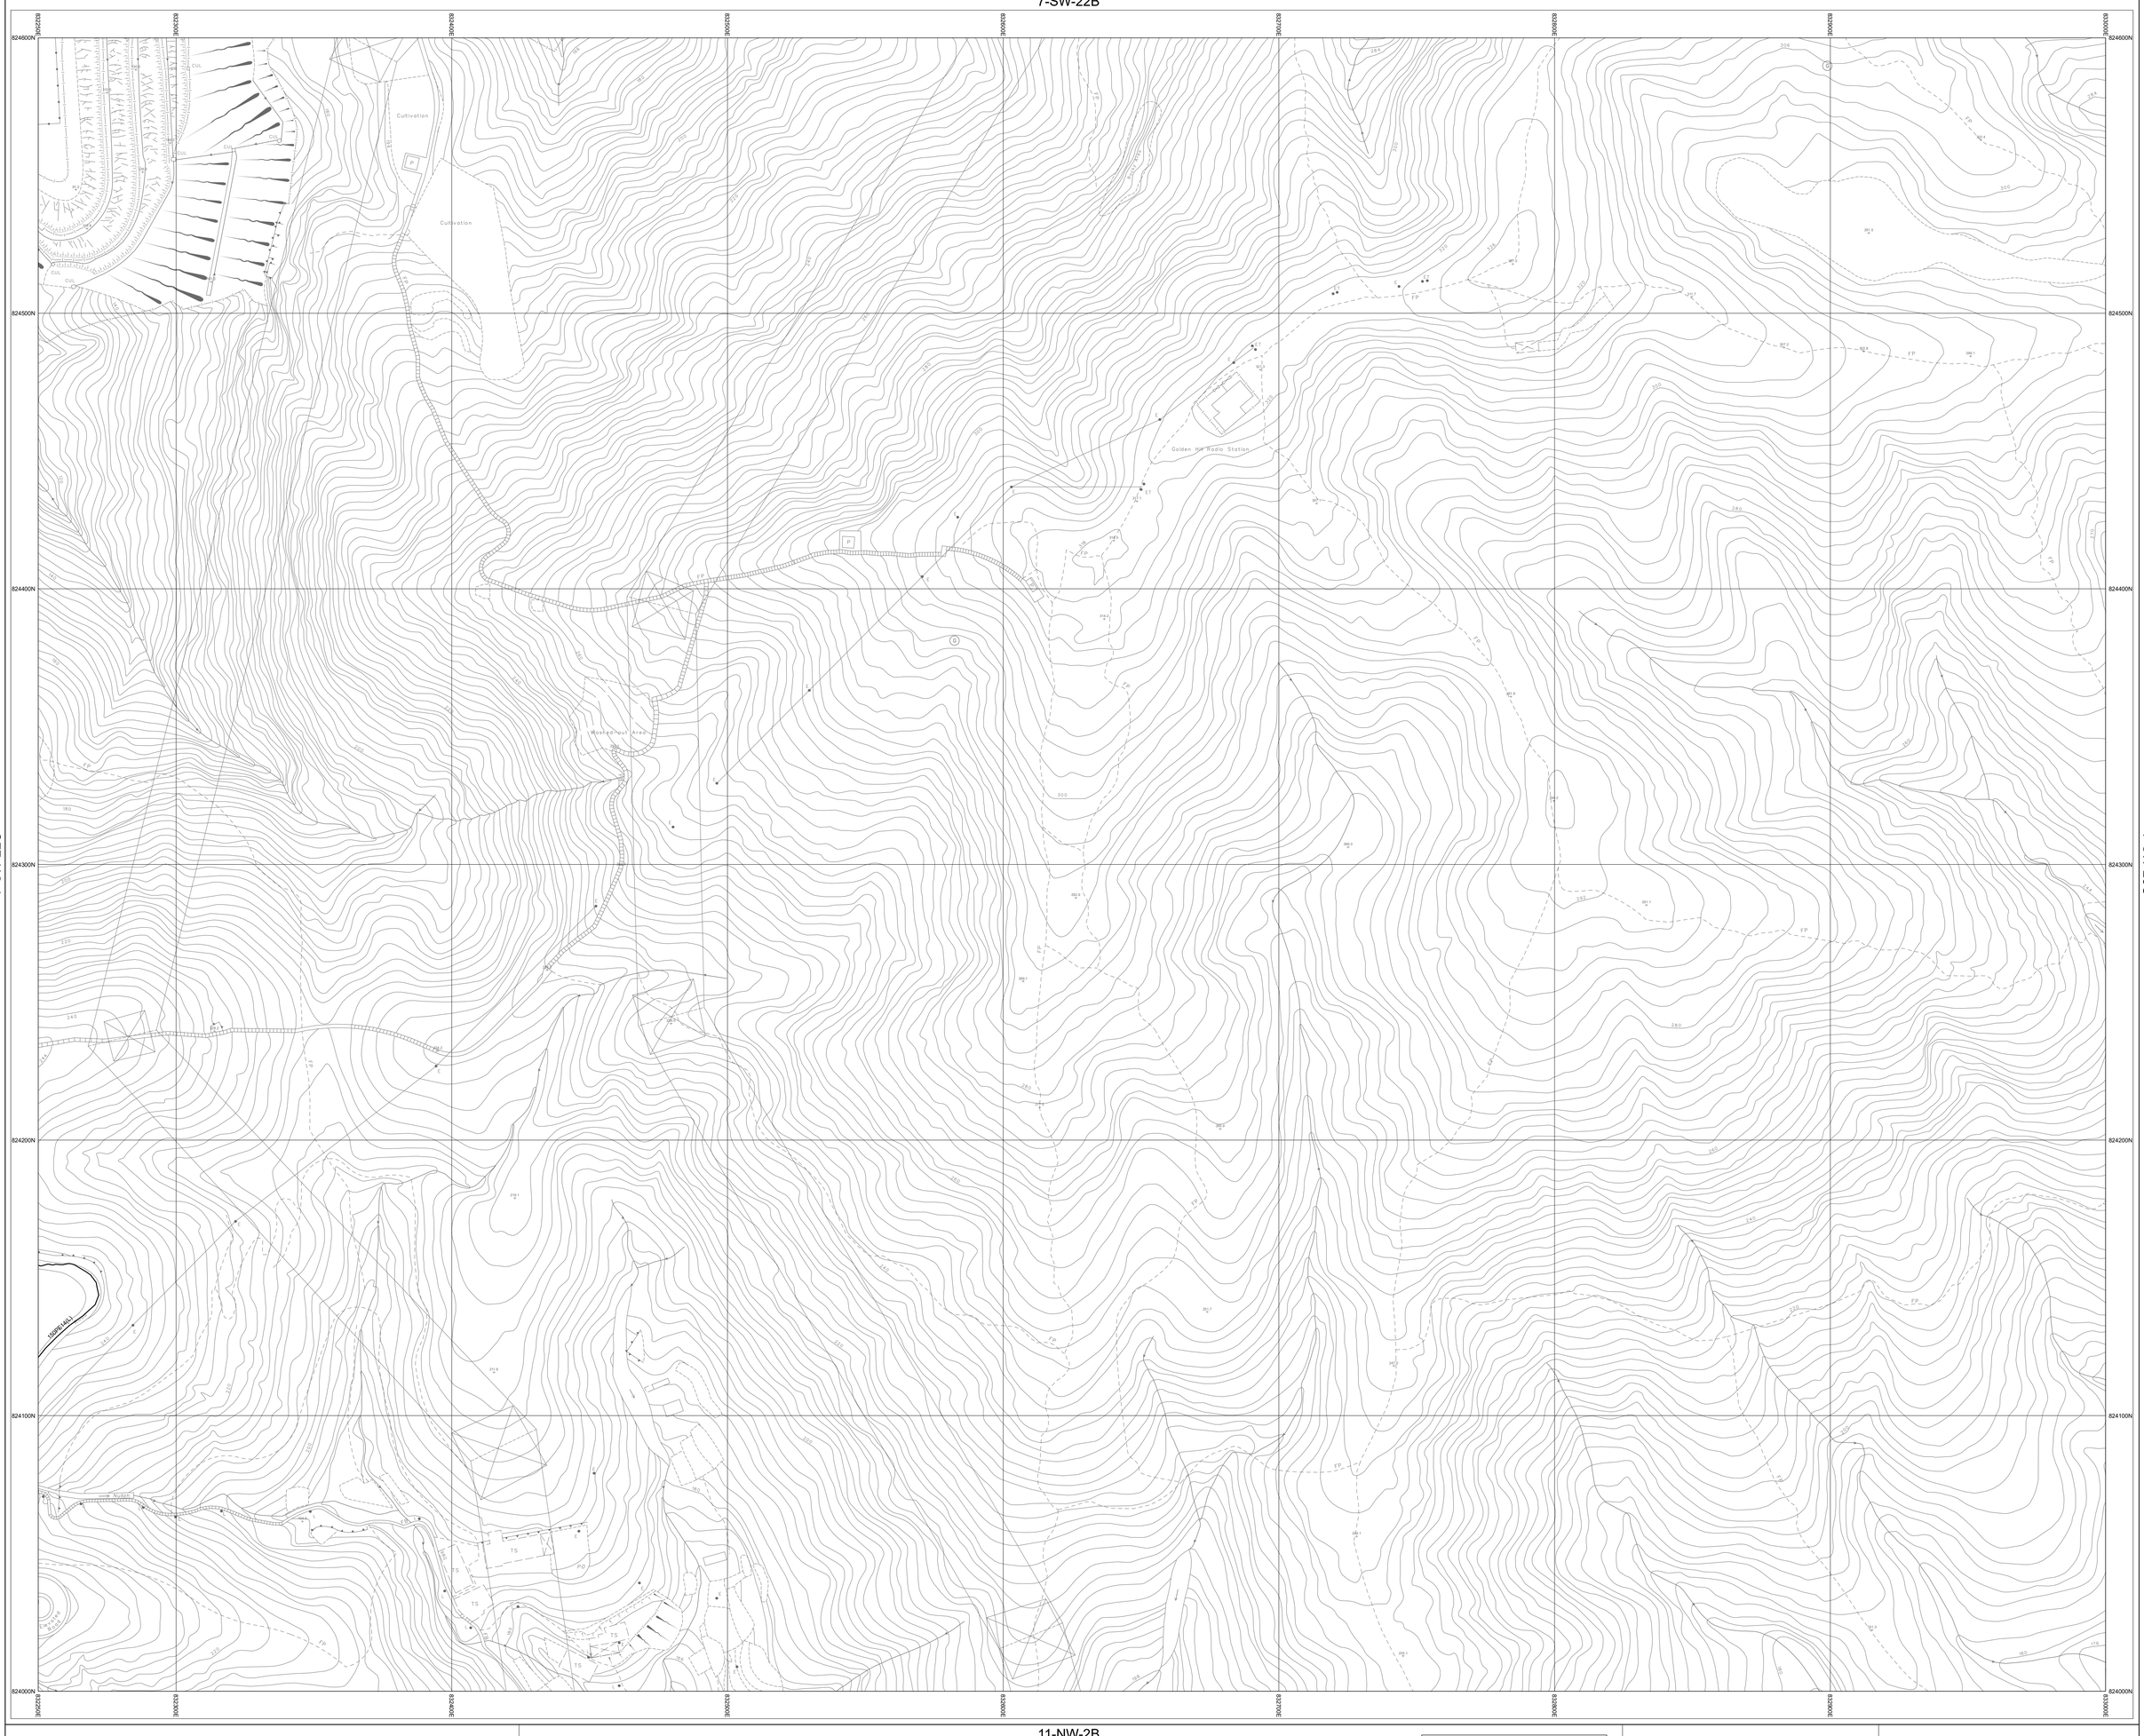

7-SW-22C

7-SW-23C

11-NW-2B

NOTES:

1. FOR MAINS RECORDS SIGN CONVENTIONS AND DESIGNATIONS SEE SKETCH NO.3988.
2. DIMENSIONS OF MAINS ARE IN MILLIMETRES UNLESS OTHERWISE SPECIFIED.
3. ALL LEVELS ARE IN METRES ABOVE PRINCIPAL DATUM.

Basemap Date Updated On: 23/12/2024

SCALE 1:1 000

METRES 20 10 0 20 40 60 80 100 METRES

THIS IS A COMPUTER PRINTOUT, NO SIGNATURE IS REQUIRED.

SALT WATER MAINS RECORD PLAN

WSD SOUTH TUNNEL, GOLDEN HILL

COPYRIGHT RESERVED

DATE REVISED : 30/12/2024

DRAWING NO.

W67881/ 7-SW-22D

SIGNED

K.T. CHU
CE/MSW

DATE: 09/10/1999

Water Supplies Department
HONG KONG

© The Government of the Hong Kong SAR, Map reproduced with permission of the Director of Lands