INSET 'A'	INSET 'B'	INSET 'C'	INSET 'D'	INSET 'E'	INSET 'F'

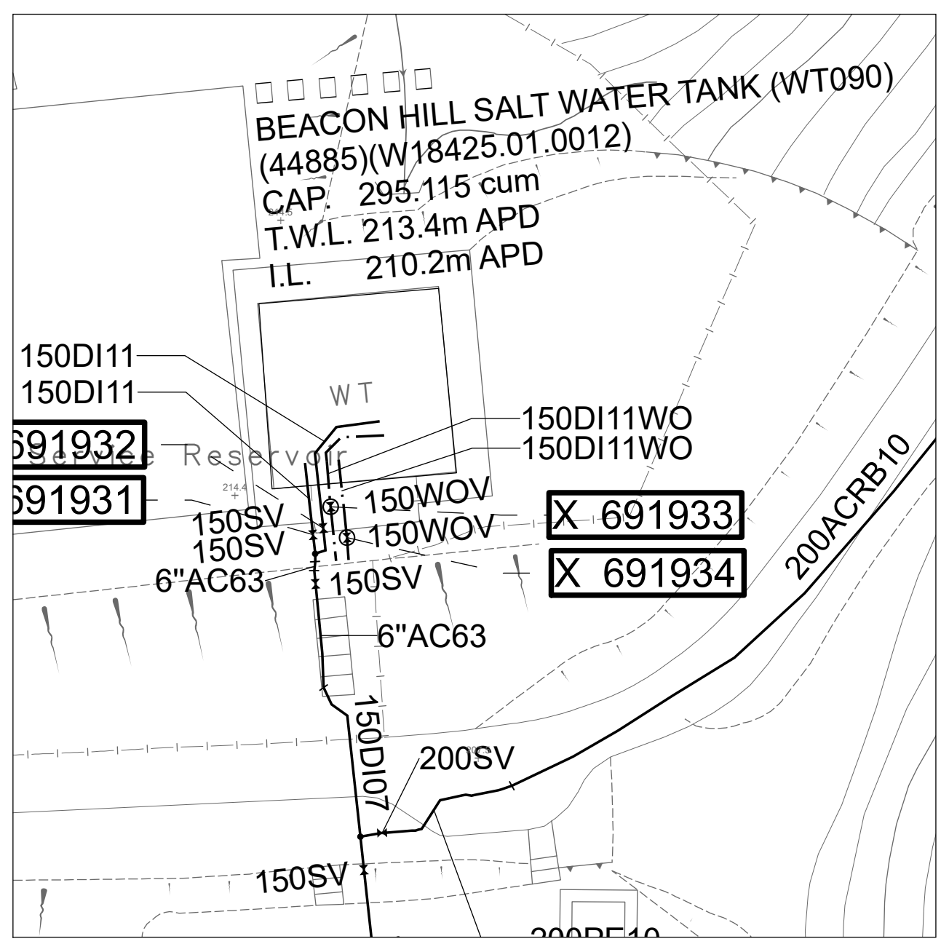
BEACON HILL SALT WATER TANK (WT090)
(44885)(W18425.01.0012)
CAP. 295.115 cum
T.W.L. 213.4m APD
I.L. 210.2m APD
WT
Service Reservoir
150DI11
150DI11
691932
691931
150DI11WO
150DI11WO
150WOV
150WOV
150SV
150SV
6"AC63
150SV
6"AC63
X 691933
X 691934
200ACRB10
150DI07
200SV
150SV
200PE10

Scale 1:500

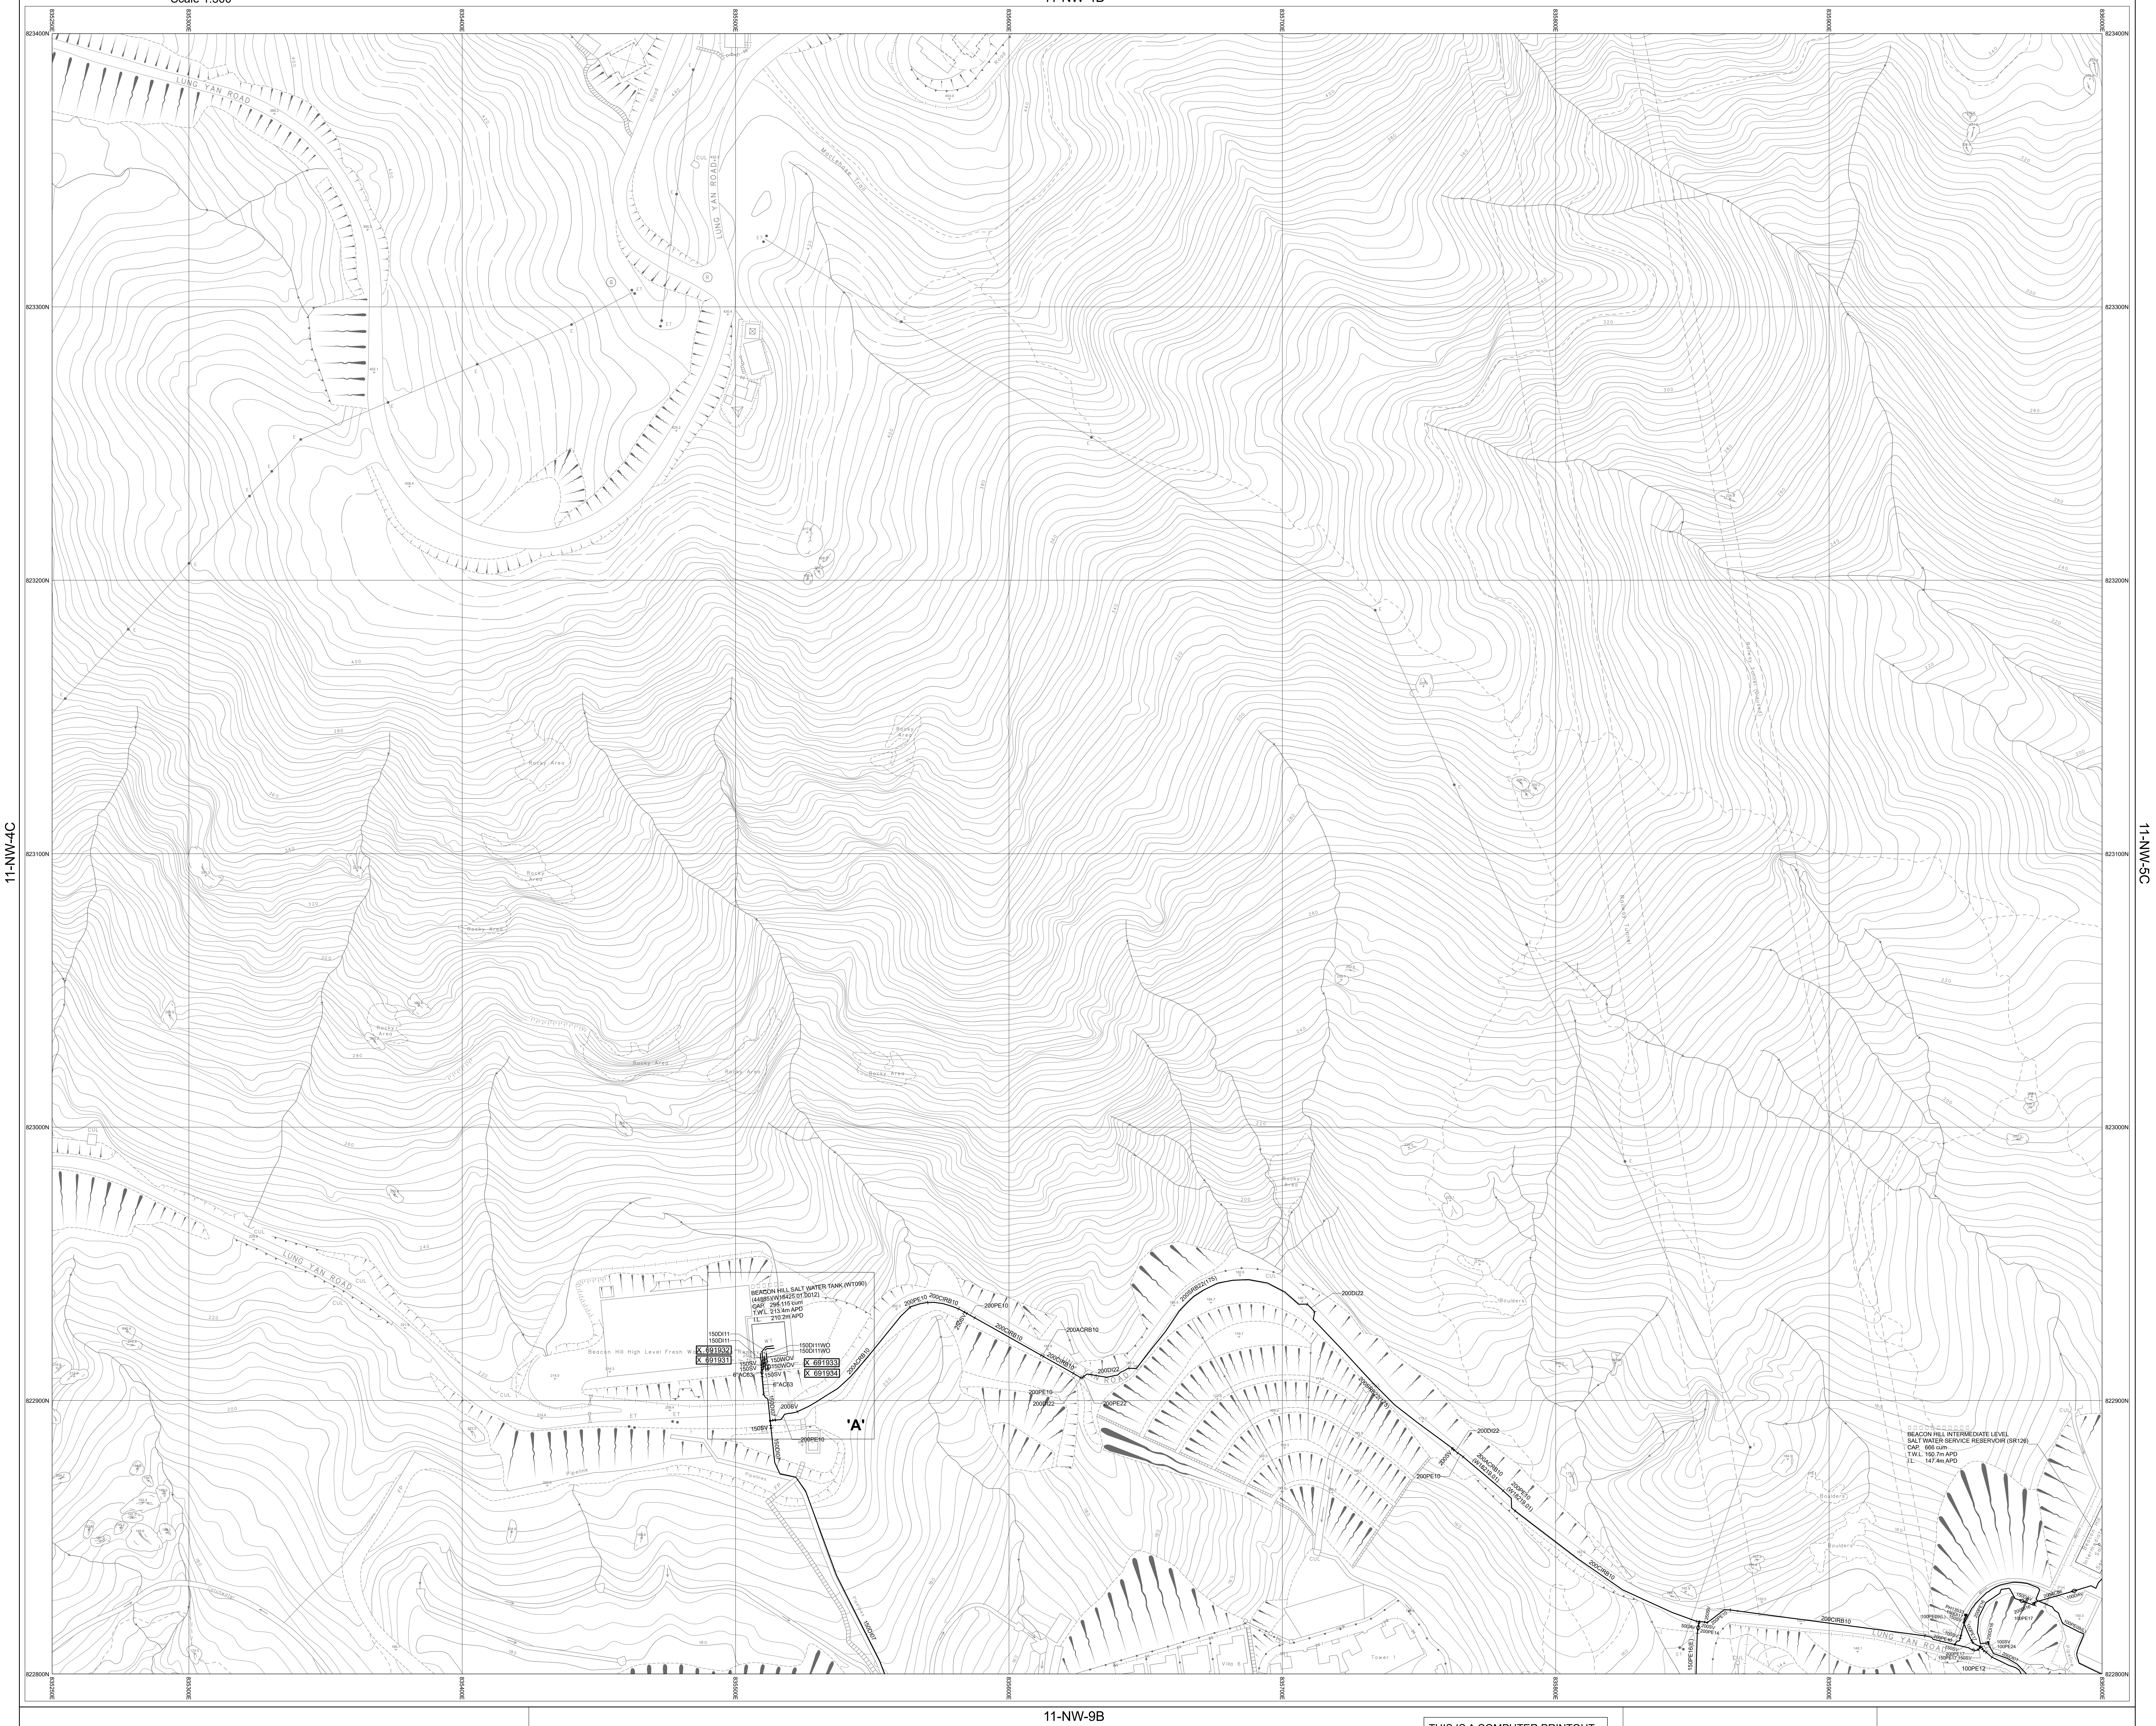
11-NW-4B
11-NW-4C
11-NW-5C
11-NW-9B
823400N
823300N
823200N
823100N
823000N
822900N
822800N
835250E
835300E
835400E
835800E
835900E
836000E
LUNG YAN ROAD
Catchwater
Rocky Area
BEACON HILL SALT WATER TANK (WT090)
'A'
200CIRB10
200ACRB10
200PE10
200DI22
150PE16(E)
BEACON HILL INTERMEDIATE LEVEL
SALT WATER SERVICE RESERVOIR (SR126)
CAP. 666 cum
T.W.L. 150.7m APD
I.L. 147.4m APD
Beacon Hill Intermediate Salt Water Service Reservoir
Tower 1
Pipeline

NOTES:

1. FOR MAINS RECORDS SIGN CONVENTIONS AND DESIGNATIONS SEE SKETCH NO.3988.
2. DIMENSIONS OF MAINS ARE IN MILLIMETRES UNLESS OTHERWISE SPECIFIED.
3. ALL LEVELS ARE IN METRES ABOVE PRINCIPAL DATUM.

Basemap Date Updated On: 05/01/2026

SCALE 1:1 000

METRES 20 10 0 20 40 60 80 100 METRES

SALT WATER MAINS RECORD PLAN

BEACON HILL H/L S/Rs

THIS IS A COMPUTER PRINTOUT,
NO SIGNATURE IS REQUIRED.

COPYRIGHT RESERVED

DATE REVISED : 03/03/2026

SIGNED

K.T. CHU
CE/MSW

DATE: 09/10/1999

DRAWING NO.

W67881/ 11-NW-4D

Water Supplies Department
HONG KONG

© The Government of the Hong Kong SAR, Map reproduced with permission of the Director of Lands