INSET 'A' | INSET 'B' | INSET 'C' | INSET 'D' | INSET 'E' | INSET 'F'

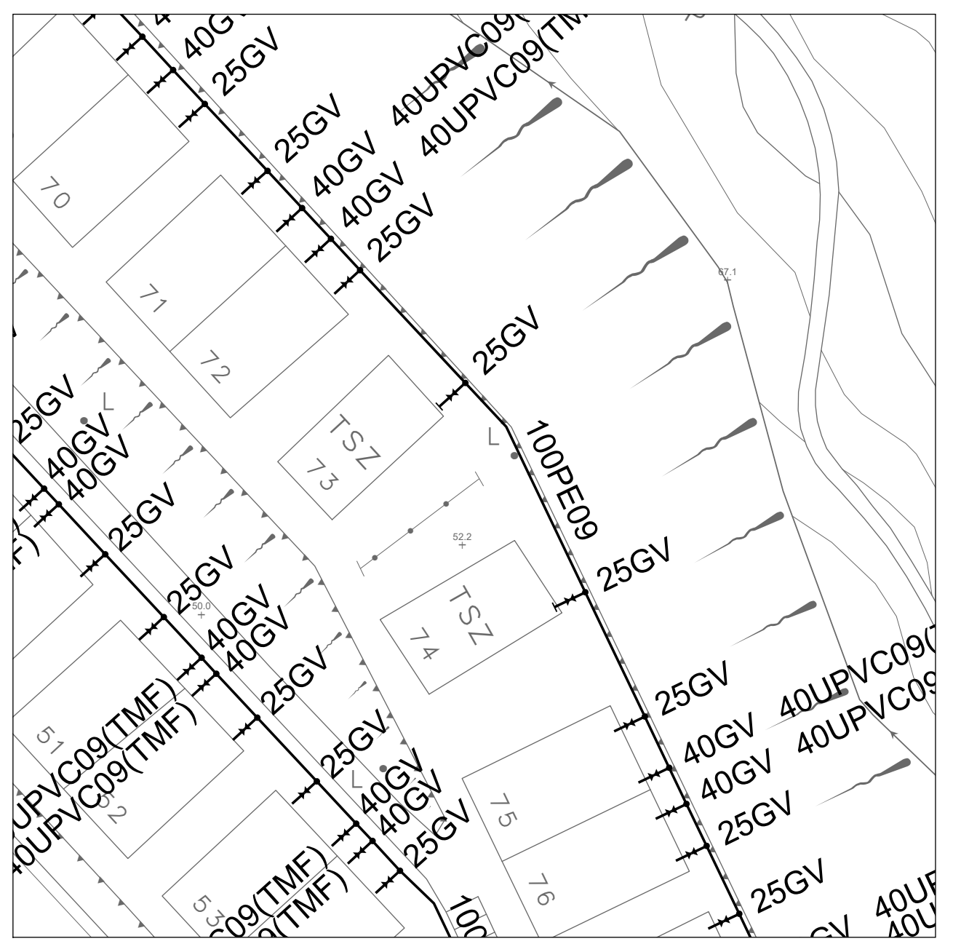
40GV
25GV
40UPVC09(TMF)
100PE09
40UPVC09(TMF)

Scale 1:500

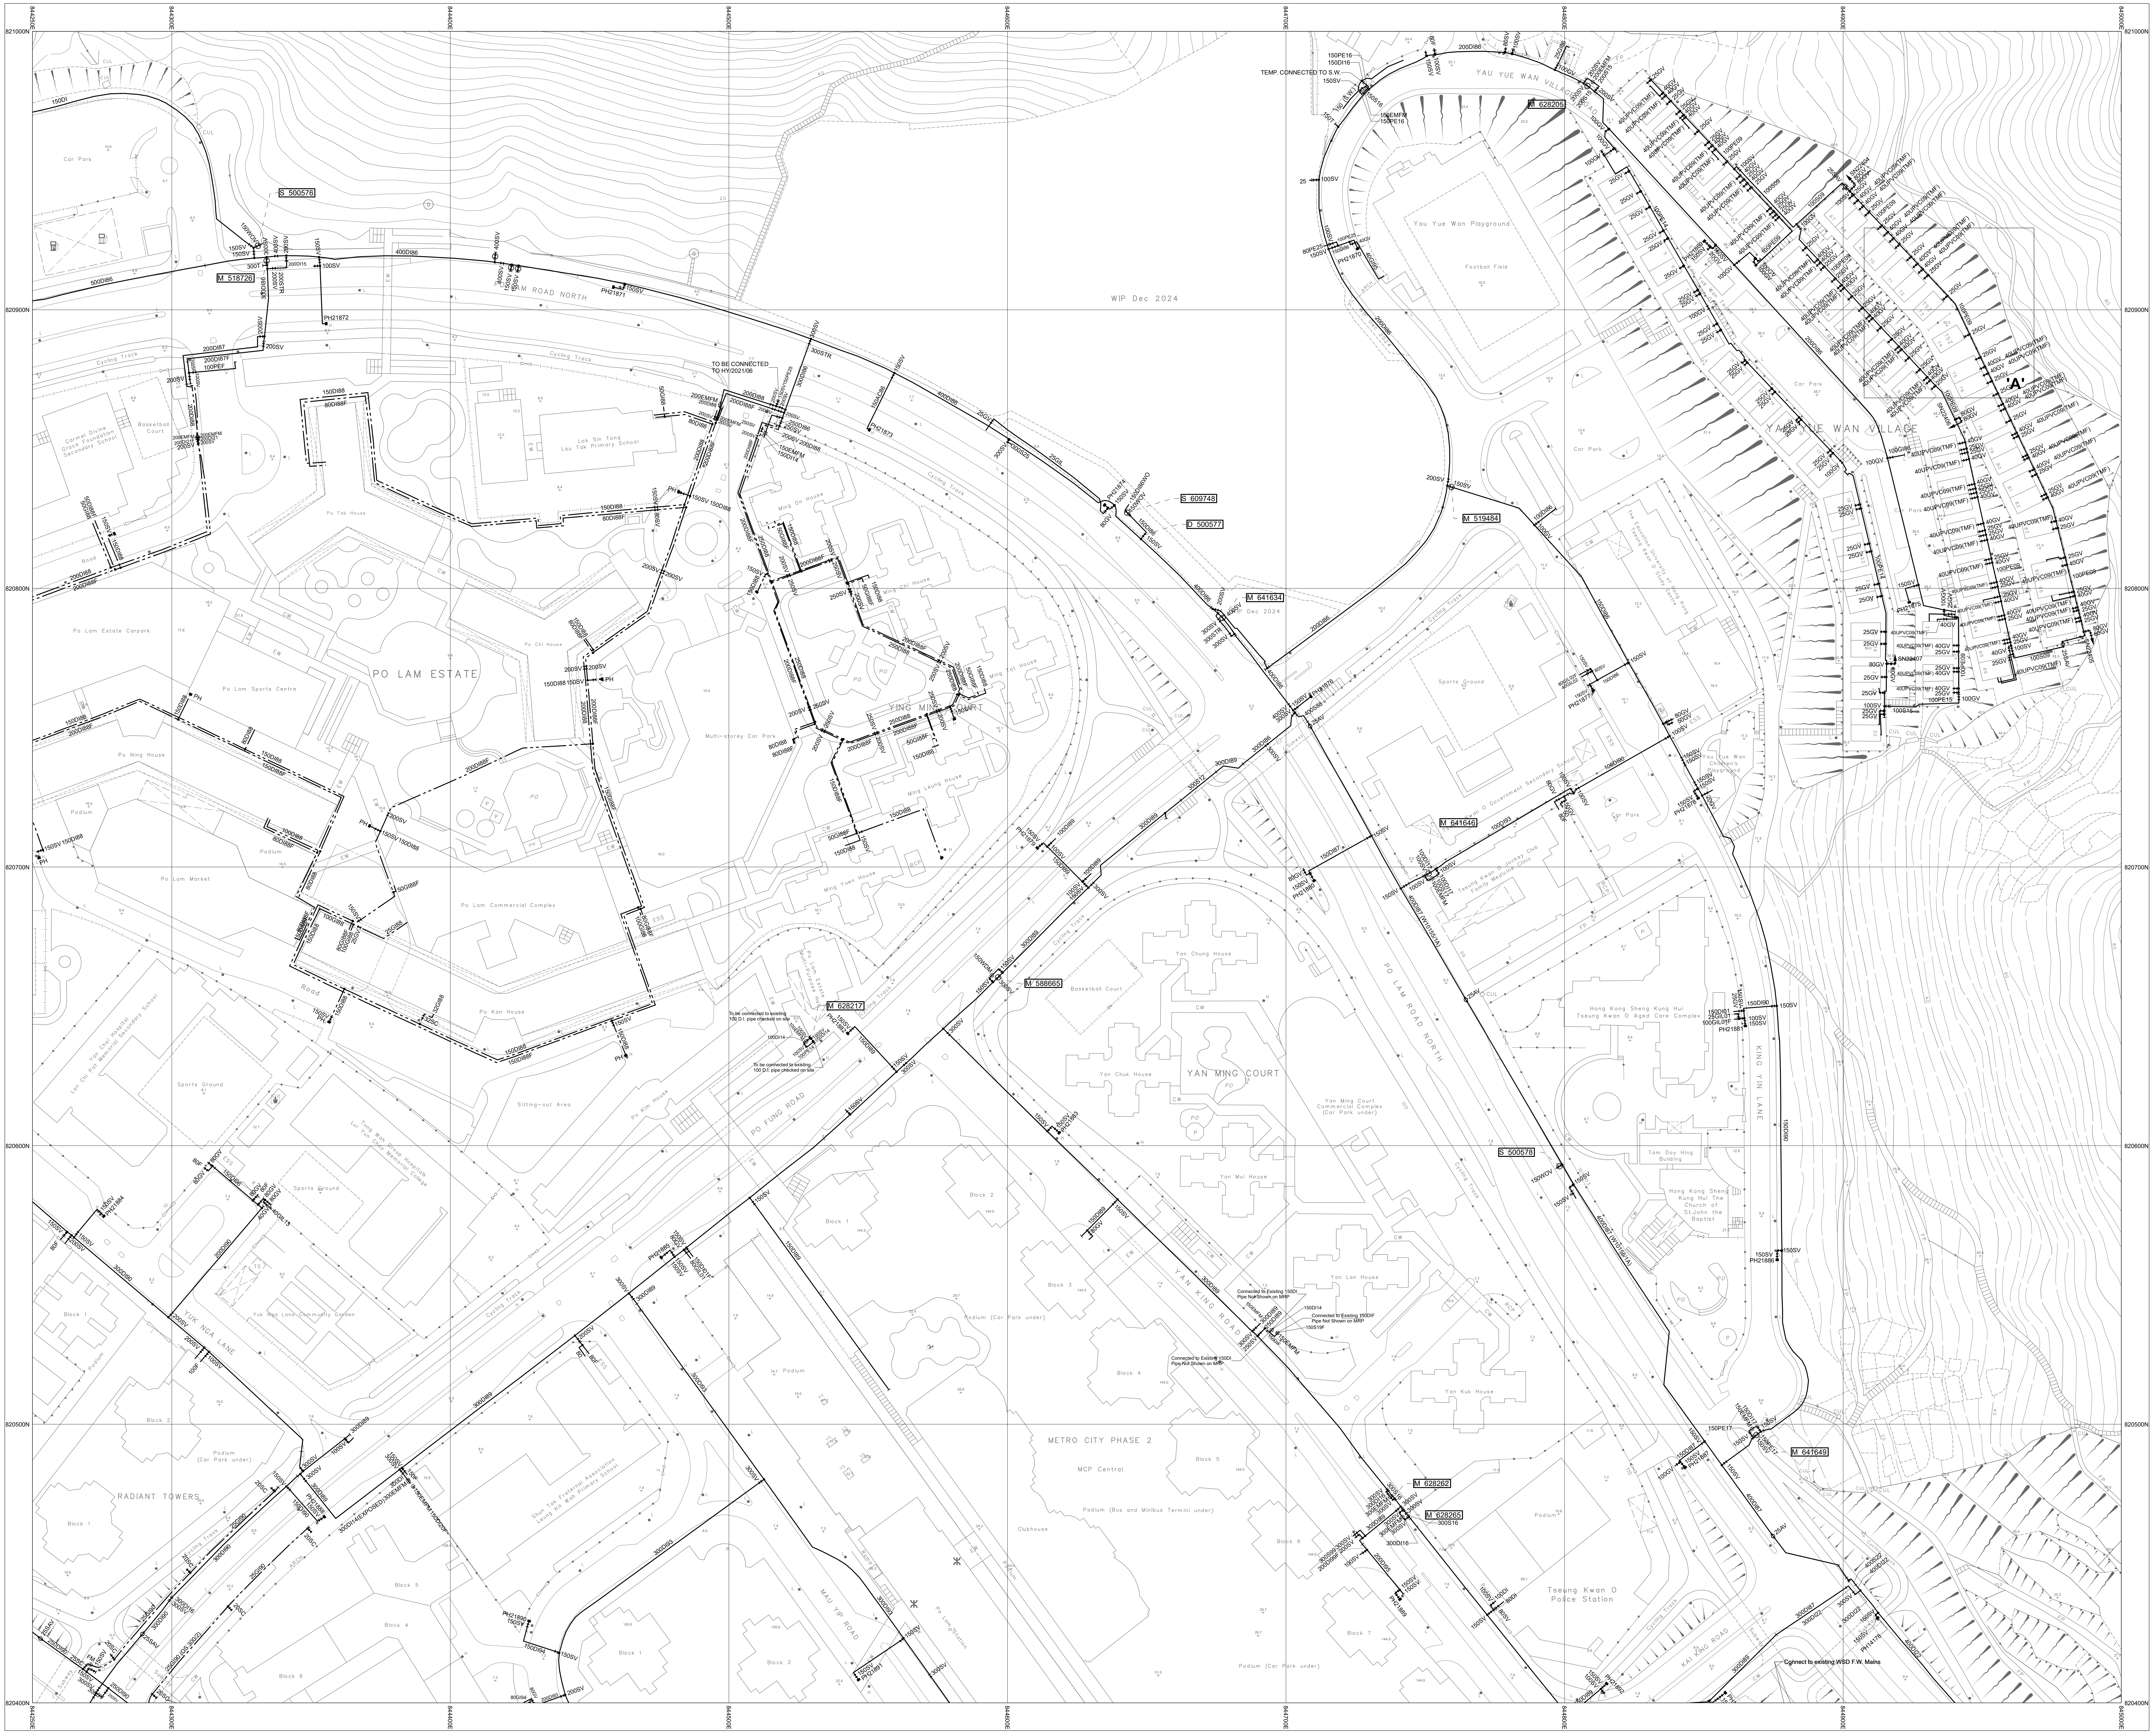
11-NE-15B
11-NE-20B
11-NE-15C
12-NW-11C
PO LAM ESTATE
YAN MING COURT
METRO CITY PHASE 2
RADIANT TOWERS
YAU YUE WAN VILLAGE
PO LAM ROAD NORTH
PO FUNG ROAD
YAN KING ROAD
KING YIN LANE
MAU TIP ROAD
WIP Dec 2024
'A'
Connect to existing WSD F.W. Mains

NOTES:

1. FOR MAINS RECORDS SIGN CONVENTIONS AND DESIGNATIONS SEE SKETCH NO.3988.
2. DIMENSIONS OF MAINS ARE IN MILLIMETRES UNLESS OTHERWISE SPECIFIED.
3. ALL LEVELS ARE IN METRES ABOVE PRINCIPAL DATUM.

Basemap Date Updated On: 05/01/2026

SCALE 1:1 000

METRES 20 10 0 20 40 60 80 100 METRES

THIS IS A COMPUTER PRINTOUT,
NO SIGNATURE IS REQUIRED.

FRESH WATER MAINS RECORD PLAN

YAU YUE WAN, TSEUNG KWAN O

COPYRIGHT RESERVED

DATE REVISED : 04/06/2026

SIGNED C.H. NG
CE/MSE
DATE: 10/06/1999

DRAWING NO.

W67880/ 11-NE-15D

Water Supplies Department
HONG KONG

© The Government of the Hong Kong SAR, Map reproduced with permission of the Director of Lands