INSET 'A'

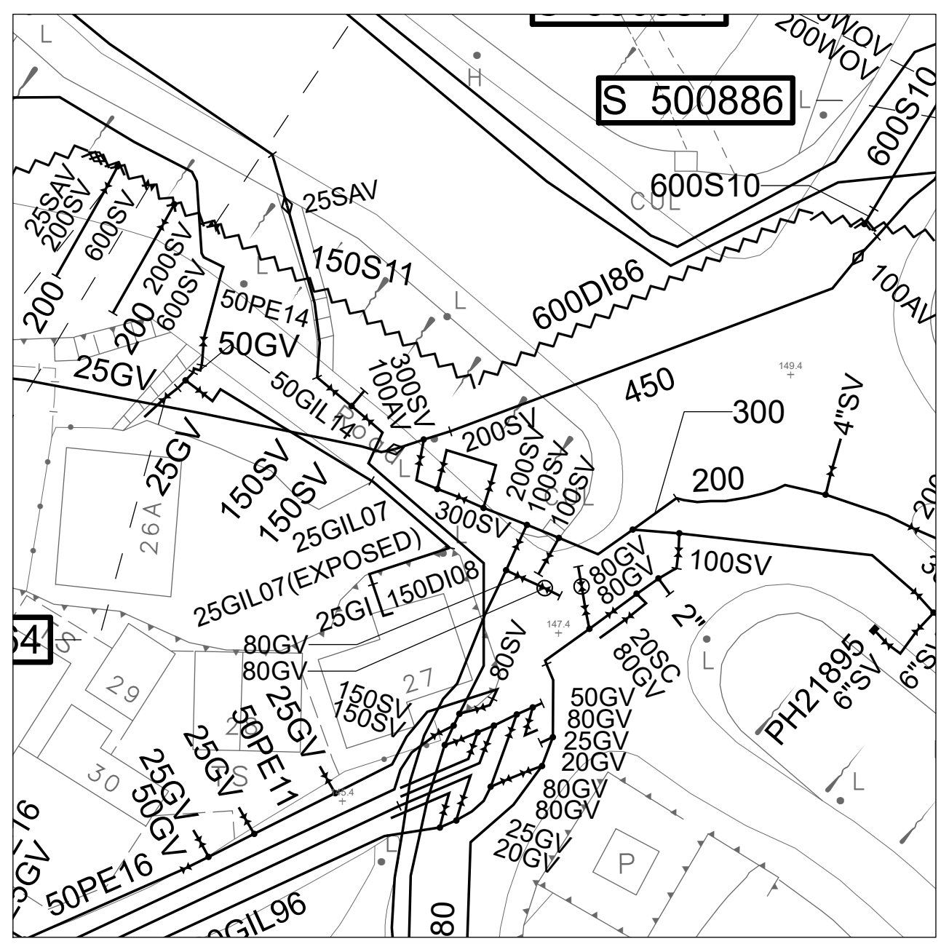

Scale 1:500

INSET 'B'

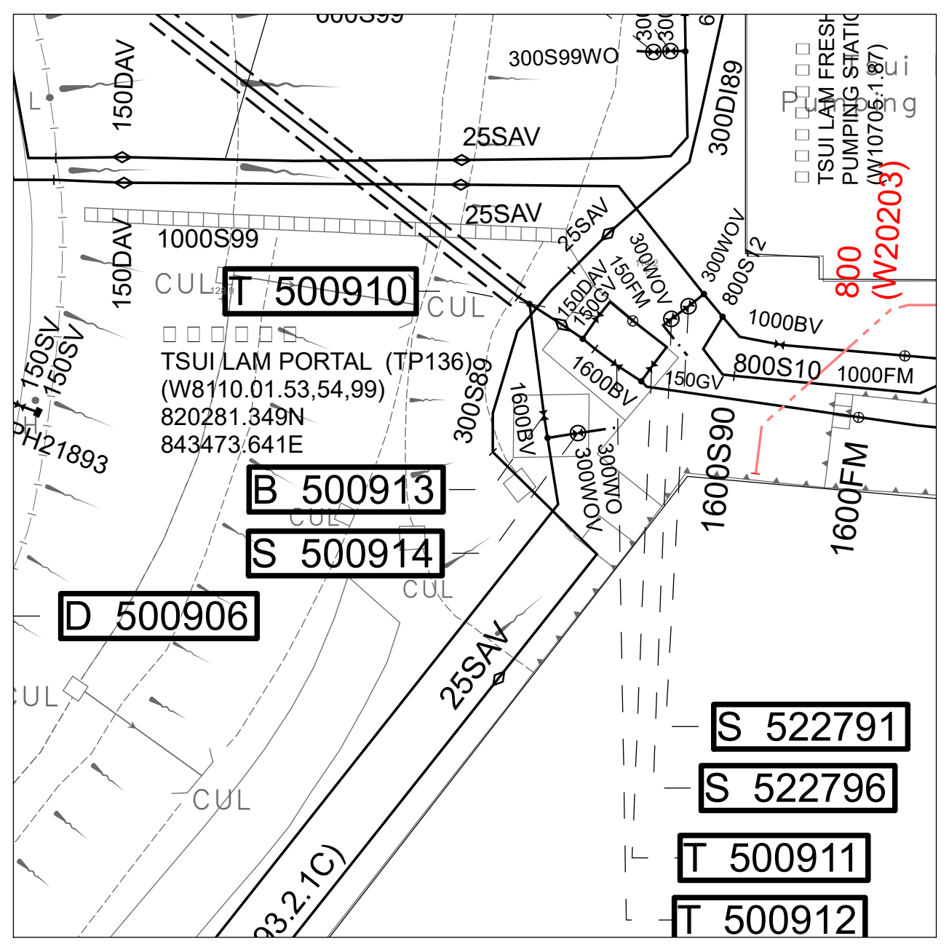

Scale 1:500

INSET 'C'

INSET 'D'

INSET 'E'

INSET 'F'

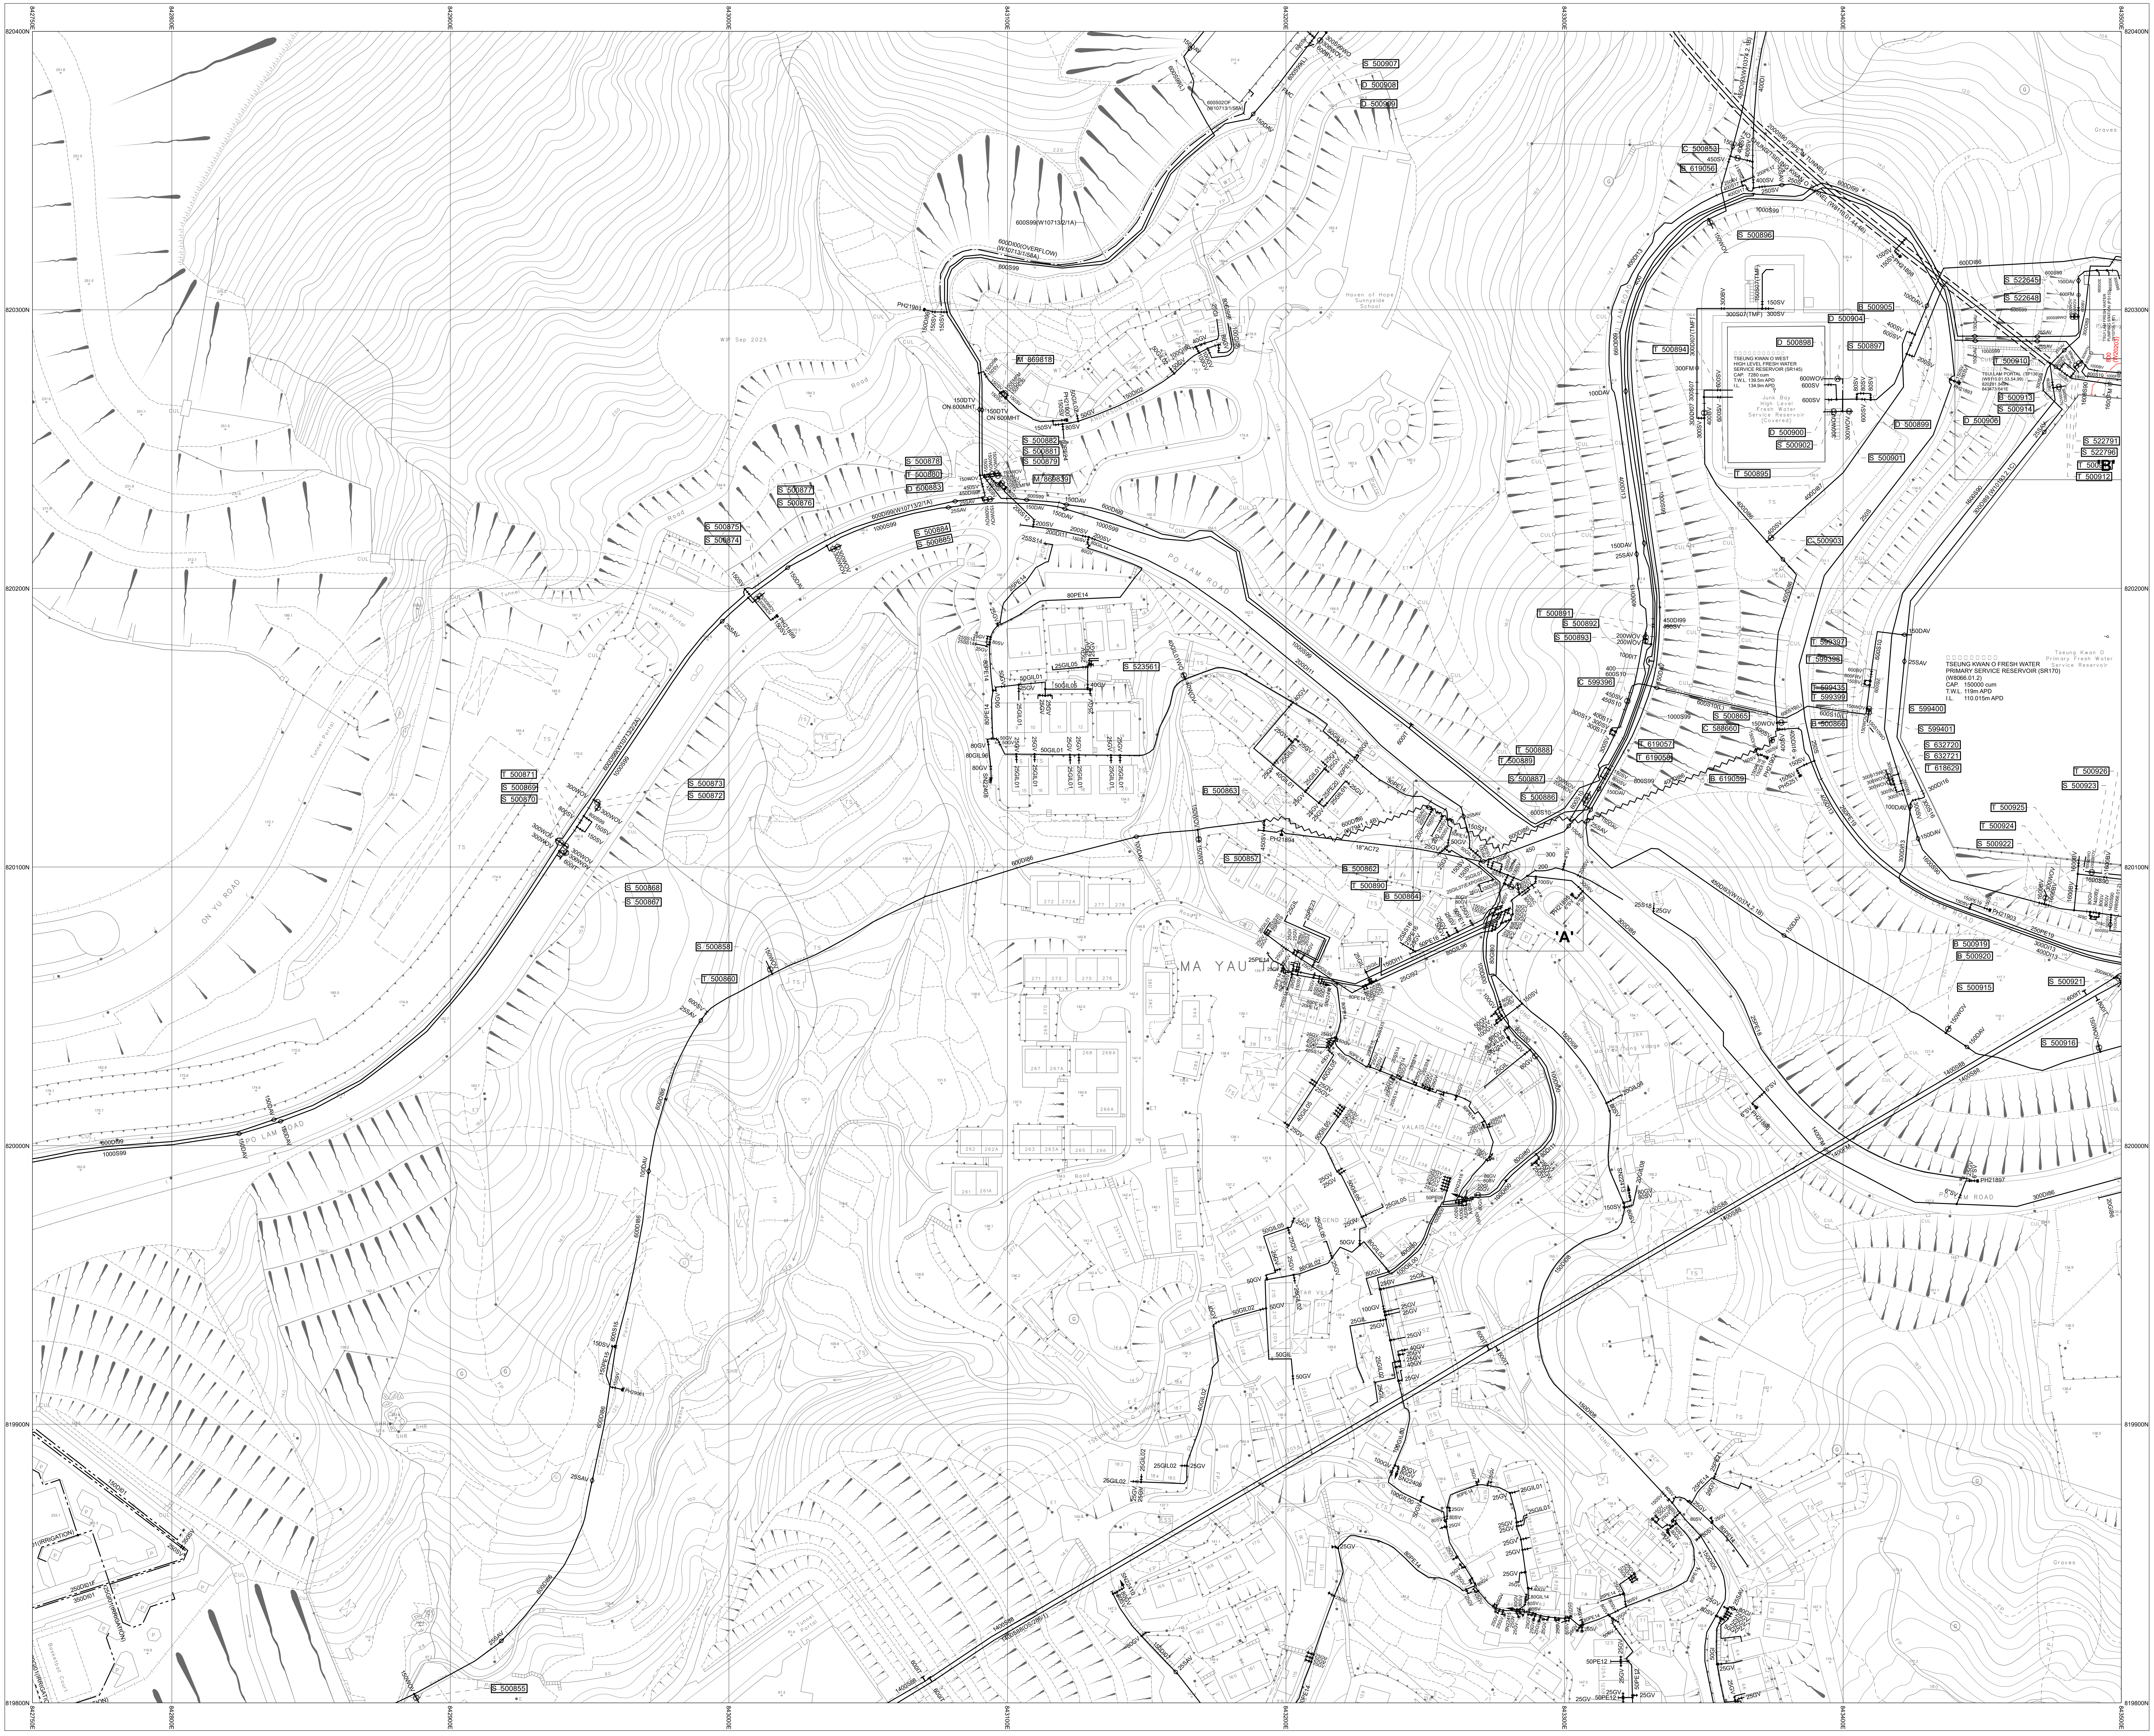
11-NE-14D
11-NE-19A
11-NE-20A
11-NE-19D
820400N
820300N
820200N
820100N
820000N
819900N
819800N
PO LAM ROAD
ON YU ROAD
MA YAU TONG
'A'
Haven of Hope Sunnyside School
TSEUNG KWAN O WEST HIGH LEVEL FRESH WATER SERVICE RESERVOIR (SR145)
TSEUNG KWAN O FRESH WATER PRIMARY SERVICE RESERVOIR (SR170)
Graves

NOTES:

1. FOR MAINS RECORDS SIGN CONVENTIONS AND DESIGNATIONS SEE SKETCH NO.3988.
2. DIMENSIONS OF MAINS ARE IN MILLIMETRES UNLESS OTHERWISE SPECIFIED.
3. ALL LEVELS ARE IN METRES ABOVE PRINCIPAL DATUM.

Basemap Date Updated On: 05/01/2026

SCALE 1:1 000

METRES 20 10 0 20 40 60 80 100 METRES

FRESH WATER MAINS RECORD PLAN

MA YAU TONG, SAU MAU PING SOUTH

THIS IS A COMPUTER PRINTOUT, NO SIGNATURE IS REQUIRED.

COPYRIGHT RESERVED

DATE REVISED : 03/06/2026

SIGNED

C.H. NG
CE/MSE

DATE: 10/06/1999

DRAWING NO.

W67880/ 11-NE-19B

Water Supplies Department
HONG KONG

© The Government of the Hong Kong SAR, Map reproduced with permission of the Director of Lands